

PERMIT

SEWAGE DISPOSAL SYSTEM

MARYLAND STATE DEPARTMENT OF HEALTH

HOWARD COUNTY

INDEXED

ELLICOTT CITY

DISTRICT 9th

DATE 7/21/75

2186

~~1975~~
A58067-C

1/25/75
Ready

#361974 File

Ronald Oaks IS PERMITTED TO INSTALL ALTER

ADDRESS Roxbury Road, Glenwood, Maryland PHONE 409-4922

A SEWAGE DISPOSAL SYSTEM LOCATED AT _____

SUBDIVISION _____ ROAD 4069 Idanthium Road LOT 2

PROPERTY OWNER Mr. and Mrs. Ronald Oaks

ADDRESS Roxbury Road, Glenwood, Maryland Phone: 409-4922

SPECIFICATIONS 4 bedrooms

DRAIN FIELD _____ DEPTH _____ FEET. BOTTOM AREA _____ SQ. FT.

SEEPAGE PITS _____ ABSORBENT SIDE-WALL AREA _____ SQ. FT.

SEPTIC TANK CAPACITY 1200 GALLONS

FOR GARBAGE GRINDER, INCREASE DISPOSAL AREA 25% & TANK CAPACITY 50%.

OTHER DRY WELL - 120 sq.ft. absorbent sidewall area per bedroom located 60 ft. from left property line and 190 ft. from back corner and side intersection toward front. Inlet to be no deeper than 4 ft. and maximum depth of 10 ft. from original grade.

NOTE: ALL PIPE FROM HOUSE TO DISPOSAL AREA MUST BE CAST IRON.
PERMIT VOID AFTER THREE YEARS.

NOTE: INSTALL STAND PIPES ON SEPTIC TANK AND DRY WELL. STAND PIPES MUST BE 6 INCHES IN DIAMETER. CAST IRON, CONCRETE OR TERRA COTTA ACCEPTED.

PLANS APPROVED BY Fred Frosselt DATE 5/10/75

FILL SEPTIC TANK AND DISTRIBUTION BOX WITH WATER BEFORE CALLING FOR AN INSPECTION. COVER NO WORK UNTIL INSPECTED AND APPROVED.

NEITHER THE HOWARD COUNTY COMMISSIONERS NOR THE HEALTH DEPARTMENT IS RESPONSIBLE FOR THE SUCCESSFUL OPERATION OF ANY SYSTEM.


BLDG PERMIT SIGNED

AND RETURNED 7-2-97

Serial # 20106622
Sumner

A 58067-C

PERMIT

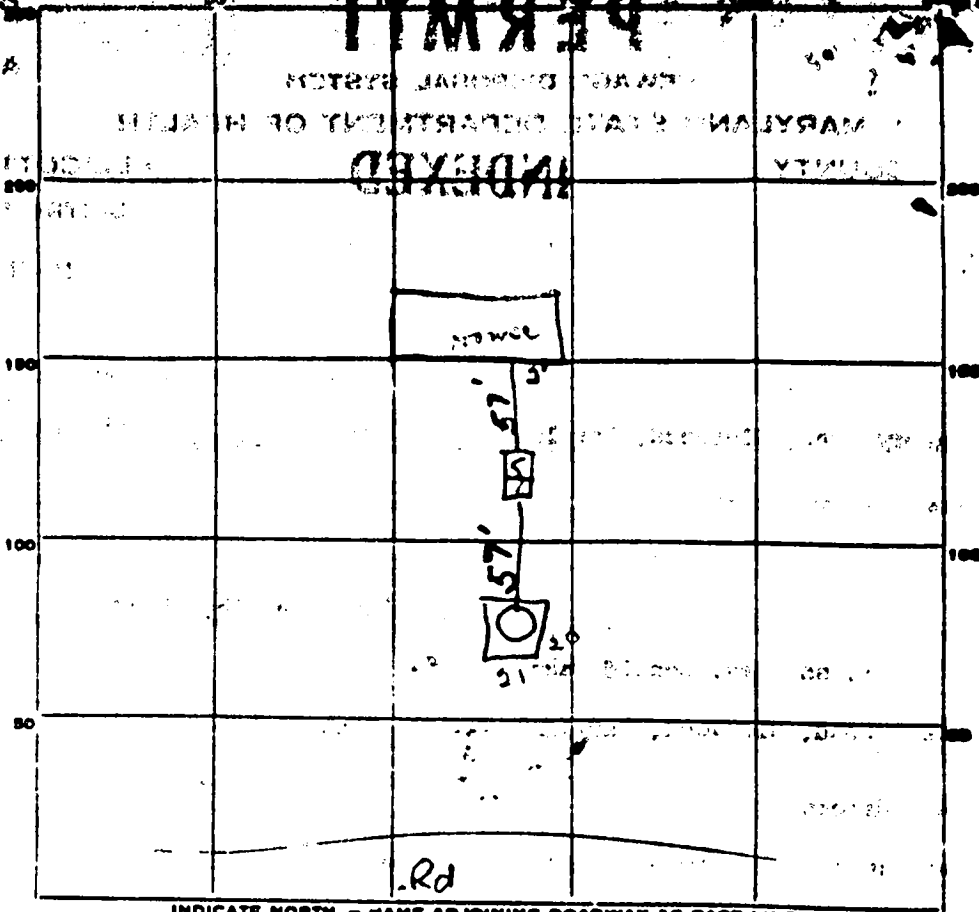

INDICATE NORTH. - NAME ADJOINING ROADWAY AS BASE LINE.

PERMIT CARD Signed

SEPTIC TANK, LEVEL OK

CLEANOUTS OK

DISTRIBUTION BOX, LEVEL _____

TILE FIELD: DEPTH _____ FT. TRENCH WIDTH _____ FT.

GRAVEL DEPTH _____ IN. TOTAL LENGTH _____ FT.

NUMBER OF TRENCHES _____ TOTAL BOTTOM AREA _____


SEEPAGE PITS, INSIDE DIAMETER 20x21 FT. DEPTH BELOW INLET 62 FT.

ABSORBENT AREA 533 SQ. FT.

REMARKS _____

DATE SYSTEM APPROVED 7/25/55

INSPECTOR R. Tom

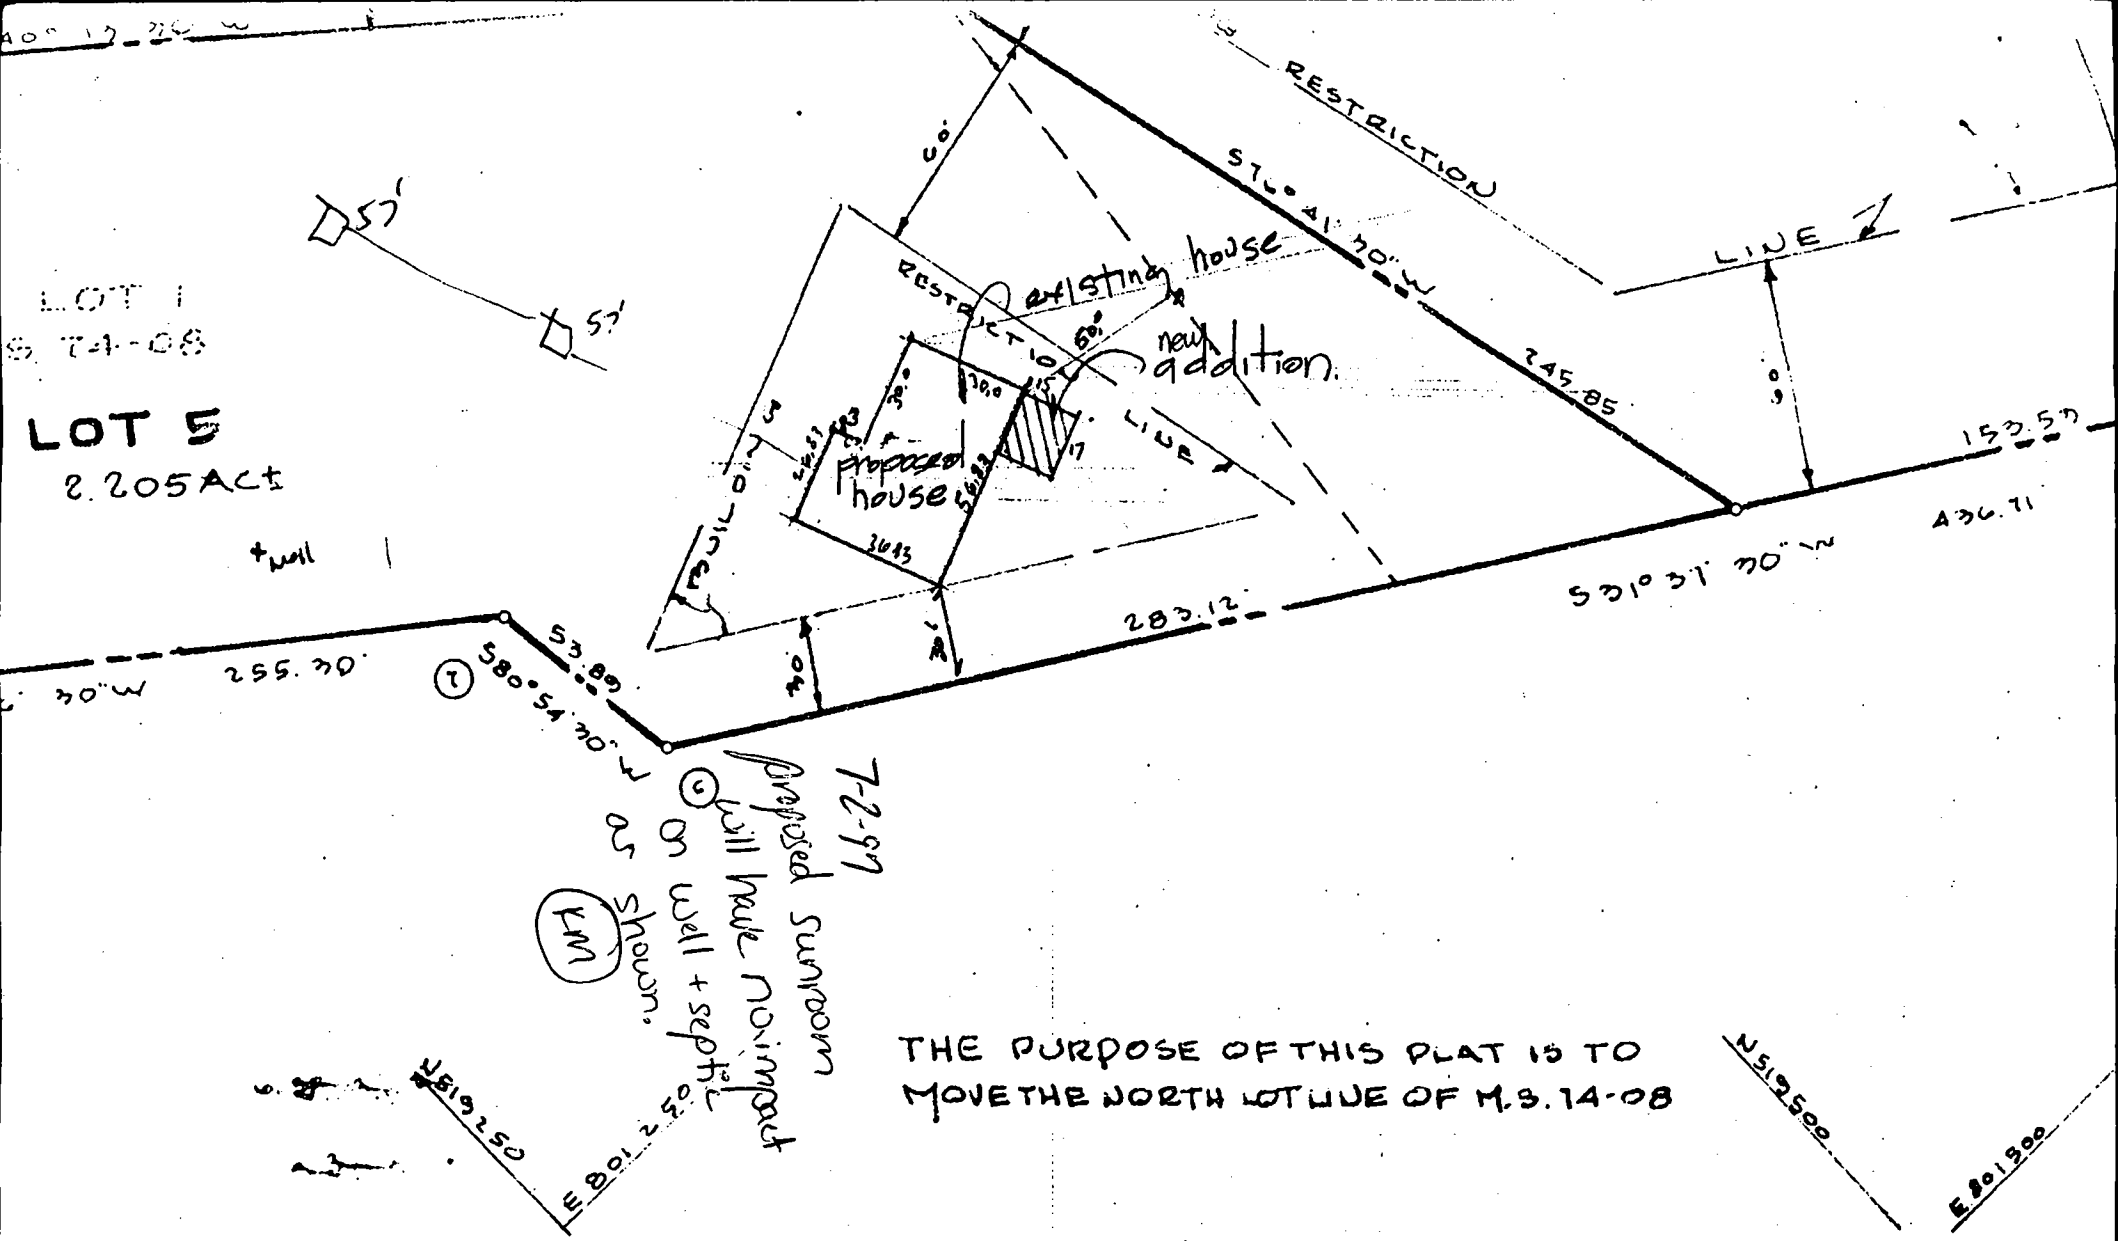

LOT 1
S. 74-08

LOT 5
2.205 Act

7-2-99
Proposed Sunroom
will have no impact
on well + septic
system.

THE PURPOSE OF THIS PLAT IS TO
MOVE THE NORTH LOT LINE OF M.S. 14-08

VEYOR'S CERTIFICATE

THE FINAL PLAT SHOWN HEREON IS
A DIVISION OF ALL THAT LAND WHICH BY
DEED DATED AND RECORDED AMONG THE LAND RECORDS
OF HOWARD COUNTY IN LIBER 614, AT FOLIO 605, ETC. WHICH WAS
GRANTED TO R. SMITH, AND WIFE, UNTO RONALD A. OAKS
AND PART OF THAT LAND WHICH BY DEED DATED
AND RECORDED AMONG THE LAND RECORDS OF HOWARD COUNTY
AT FOLIO 051, WHICH WAS GRANTED AND

OWNER'S CERTIFICATE

WE, C. EDGAR PUGH, JR., NANCY GRIMM PUGH, RONALD A. OAKS AND JANET K. OAKS,
OWNERS OF THE PROPERTY SHOWN AND DESCRIBED HEREON, HEREBY ADOPT THIS PLAN OF
SUBDIVISION; AND IN CONSIDERATION OF THE APPROVAL OF THIS PLAT BY THE
OFFICE OF PLANNING AND ZONING, ESTABLISH THE MINIMUM BUILDING
RESTRICTION LINES. ALL EASEMENTS OF RIGHTS OF WAY AFFECTING
THE PROPERTY ARE INCLUDED IN THIS PLAN OF SUBDIVISION. WITNESS
OUR HANDS THIS DAY OF SEPTEMBER 1989.