

*Repair*  
*8/25/64*

# PERMIT

P 08925

SEWAGE DISPOSAL SYSTEM

A \_\_\_\_\_

MARYLAND STATE DEPARTMENT OF HEALTH

HOWARD COUNTY

ELLICOTT CITY

DISTRICT 1

**INDEXED**

DATE 8/20/64

Ernest Robinson IS PERMITTED TO INSTALL  ALTER \_\_\_\_\_

ADDRESS 141 Baker St., Baltimore 16, Md. PHONE LA 3-5328

A SEWAGE DISPOSAL SYSTEM LOCATED AT \_\_\_\_\_

SUBDIVISION \_\_\_\_\_ ROAD 6162 Lawyers Hill Rd LOT \_\_\_\_\_

PROPERTY OWNER H. A. Warner

ADDRESS 5714 Lawyers Hill Rd., Elkridge, Maryland

**SPECIFICATIONS**

DRAIN FIELD \_\_\_\_\_ DEPTH \_\_\_\_\_ FEET, BOTTOM AREA \_\_\_\_\_ SQ. FT.

SEEPAGE PITS \_\_\_\_\_ ABSORBENT SIDE-WALL AREA \_\_\_\_\_ SQ. FT.

SEPTIC TANK CAPACITY 1000 GALLONS

FOR GARBAGE GRINDER, INCREASE DISPOSAL AREA 22% & TANK CAPACITY 50%.

OTHER Two 8x12 dry wells.


PLANS APPROVED BY \_\_\_\_\_ DATE 8/20/64

FILL SEPTIC TANK AND DISTRIBUTION BOX WITH WATER BEFORE CALLING FOR AN INSPECTION. COVER NO WORK UNTIL INSPECTED AND APPROVED.

NEITHER THE HOWARD COUNTY COMMISSIONERS NOR THE HEALTH DEPARTMENT IS RESPONSIBLE FOR THE SUCCESSFUL OPERATION OF ANY SYSTEM.

P508925

*408925*

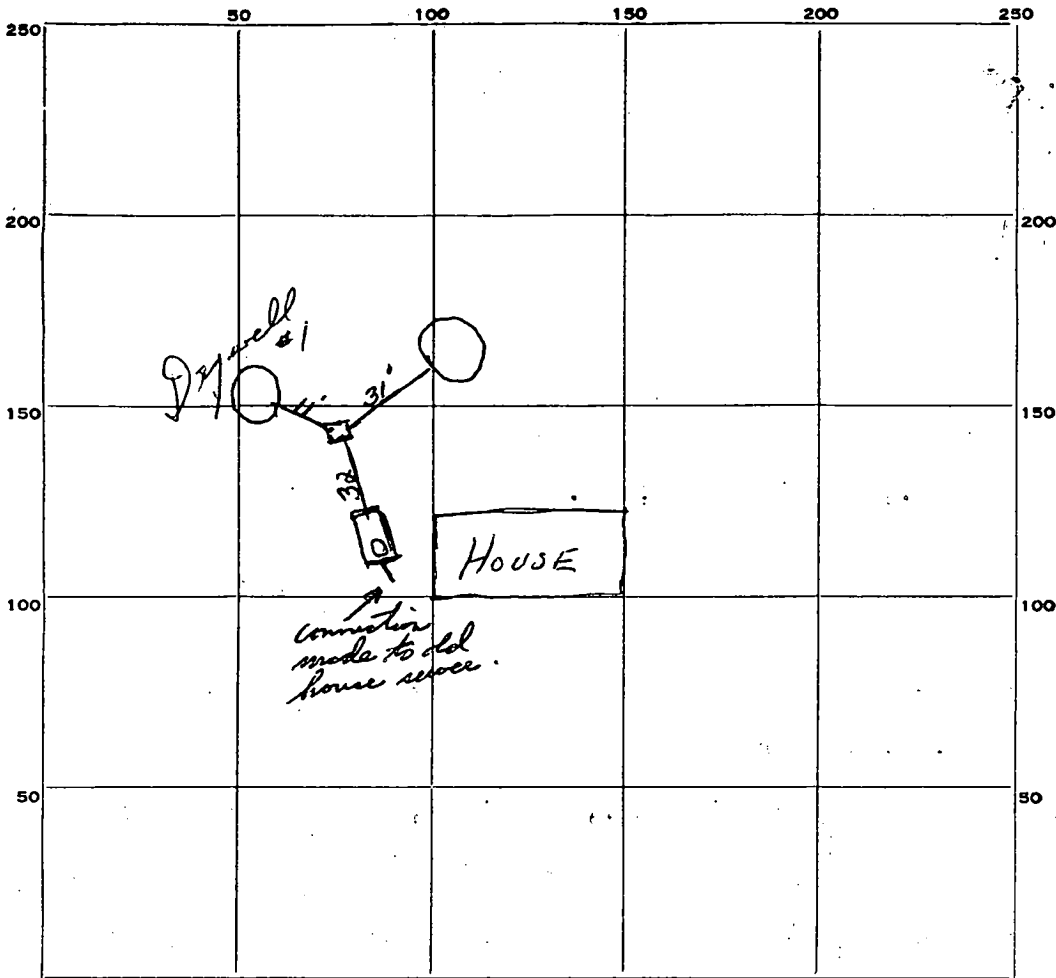

INDICATE NORTH. - NAME ADJOINING ROADWAY AS BASE LINE.

PERMIT CARD yes

SEPTIC TANK, LEVEL 1000 gal concrete CLEANOUTS 8" standard pipe

DISTRIBUTION BOX, LEVEL concrete - 2 outlets

TILE FIELD, DEPTH \_\_\_\_\_ FT. TRENCH WIDTH \_\_\_\_\_ FT.

GRAVEL DEPTH \_\_\_\_\_ IN. TOTAL LENGTH \_\_\_\_\_ FT.

NUMBER OF TRENCHES \_\_\_\_\_ TOTAL BOTTOM AREA \_\_\_\_\_

SEEPAGE PITS, INSIDE DIAMETER \_\_\_\_\_ FT. DEPTH BELOW INLET \_\_\_\_\_ FT.

ABSORBENT AREA \_\_\_\_\_ SQ. FT.

REMARKS Dry well #1 outside dia. 12 ft. depth below inlet 9 1/2 ft.  
" " 12 ft. " " " 8 1/2 ft.  
Presently connecting to public water.

DATE SYSTEM APPROVED 8-25-64 INSPECTOR J. E. Hennigan