

P510587 E

4-30-73

# PERMIT

SEWAGE DISPOSAL SYSTEM

MARYLAND STATE DEPARTMENT OF HEALTH

HOWARD COUNTY

INDEXED  
INDEXED

ELLICOTT CITY

DISTRICT 1st

DATE 4/10

01-164503

Roy A. Bauman, Company

IS PERMITTED TO INSTALL  ALTER

ADDRESS 5750 Furnace Avenue, Elkridge, Md. 21227

PHONE 796-2515

SEWAGE DISPOSAL SYSTEM LOCATED AT \_\_\_\_\_

SUBDIVISION

6199 ROAD

Layoffs Hill Road

LOT \_\_\_\_\_

PROPERTY OWNER

Mr. Elbridge

ADDRESS \_\_\_\_\_

SPECIFICATIONS

9 bedrooms

DRAIN FIELD \_\_\_\_\_ DEPTH \_\_\_\_\_ FEET BOTTOM AREA \_\_\_\_\_ SQ. FT.

SEEPAGE PITS \_\_\_\_\_ ABSORBENT SIDE-WALL AREA \_\_\_\_\_ SQ. FT.

SEPTIC TANK CAPACITY 1000 GALLONS

FOR GARBAGE GRINDER, INCREASE DISPOSAL AREA 25% & TANK CAPACITY 50%

OTHER DRY WELL - To be 100 sq. ft. of absorbent sidewall area below the inlet pipe per codebook. Maximum depth of dry well in to be 15 ft. below original grade. Inlet pipe to begin 6 ft. below original grade. Locate dry well 39 ft. from right side line and 302 ft. from Layoffs Hill Road as lot is now standing on Layoffs Hill Road facing lot.

NOTE: ALL PIPE FROM HOUSE TO DRY WELL MUST BE CAST IRON.  
PERMIT VOID AFTER THREE YEARS.

NOTE: INSTALL STAND PIPE ON SEPTIC TANK AND DRY WELL.

PLANS APPROVED BY James T. Wright

DATE 12/19/69

INSTALL SEPTIC TANK AND DISTRIBUTION BOX WITH WATER BEFORE CALLING FOR AN INSPECTION. COVER NO WORK UNTIL INSPECTED AND APPROVED.

NEITHER THE HOWARD COUNTY COMMISSIONERS NOR THE HEALTH DEPARTMENT IS RESPONSIBLE FOR THE SUCCESSFUL OPERATION OF ANY SYSTEM.

PERMIT SIGNED  
RETURNED 9/30/74  
Mail # 73021  
Strayg Shid.


*Completed & Franchising*

*R.M.*  
*4/74*

INSPECTOR \_\_\_\_\_ DATE \_\_\_\_\_

P510587E

100 - 100 feet - OK to cover

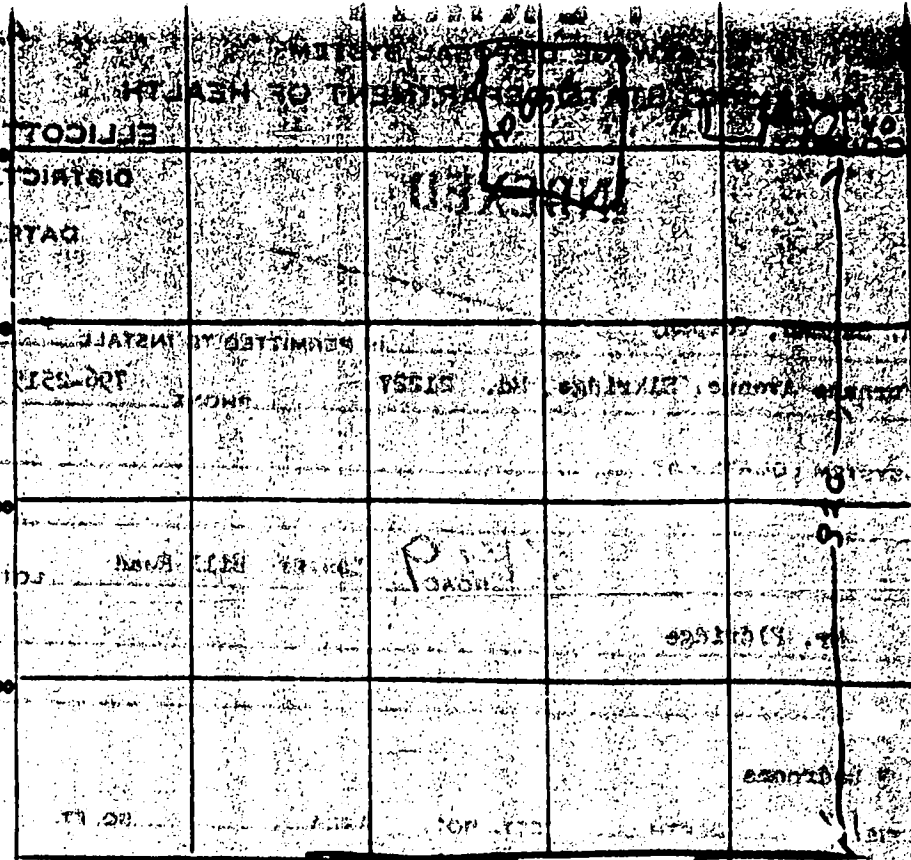

INDICATE NORTH - NAME ADJOINING ROADWAY AS BASE LINE

LAWYER'S

PERMIT CARD

SEPTIC TANK, LEVEL 12.0 covered on cleanouts NO

DISTRIBUTION BOX, LEVEL 10.0

FIELD DEPTH 5 FT. TRENCH WIDTH 12

GRAVEL DEPTH 1 IN. TOTAL LENGTH 59

NUMBER OF TRENCHES 1 TOTAL BOTTOM AREA 531

SEPTIC PITS, INSIDE DIAMETER 12 FT. DEPTH BELOW INLET 9

ABSORBENT AREA 531 SQ. FT. counting slow

REMARKS: 4/24/73 - Drip Well is 9 ft deep

below top of bed Dry Well not yet installed

diameter of Dry Well is 9 ft.

Excavate tank & sewer lines & install sewer to


dry Well & Call for inspection. OK to cover

part of Dry Well B.H. Wood to cover into ground

entirely & leaving tank & entering into

DATE SYSTEM APPROVED

INSPECTOR

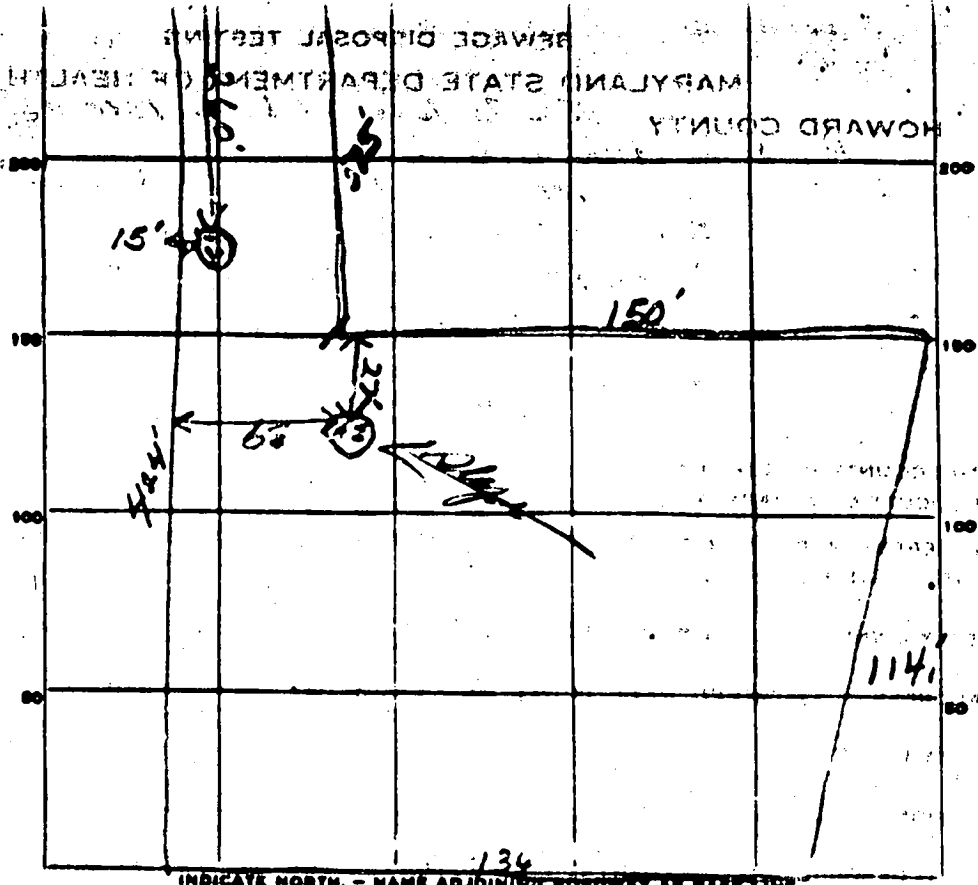

DATE	TEST NO.	DEPTH	PRE-WET		TEST - 1" DROP		TIME
			START	STOP	START	STOP	
12/19/48	1	13'	9 45	9 46	9 46	9 47	1 min
	2	7'	9 52	9 54	9 54	9 58	4 min
	3	14'	9 57	9 58	9 58	10 02	1 min
	4	6'	9 54	9 57	9 57	10 13	14 min

SOIL AUGER FINDING \_\_\_\_\_


TESTED BY \_\_\_\_\_

REMARKS \_\_\_\_\_


*See test log for details below*

Lawyers Hill Rd. (30 R/W)  
N68°52'30"E 40.70'

9/13/72  
S. J. Dyer

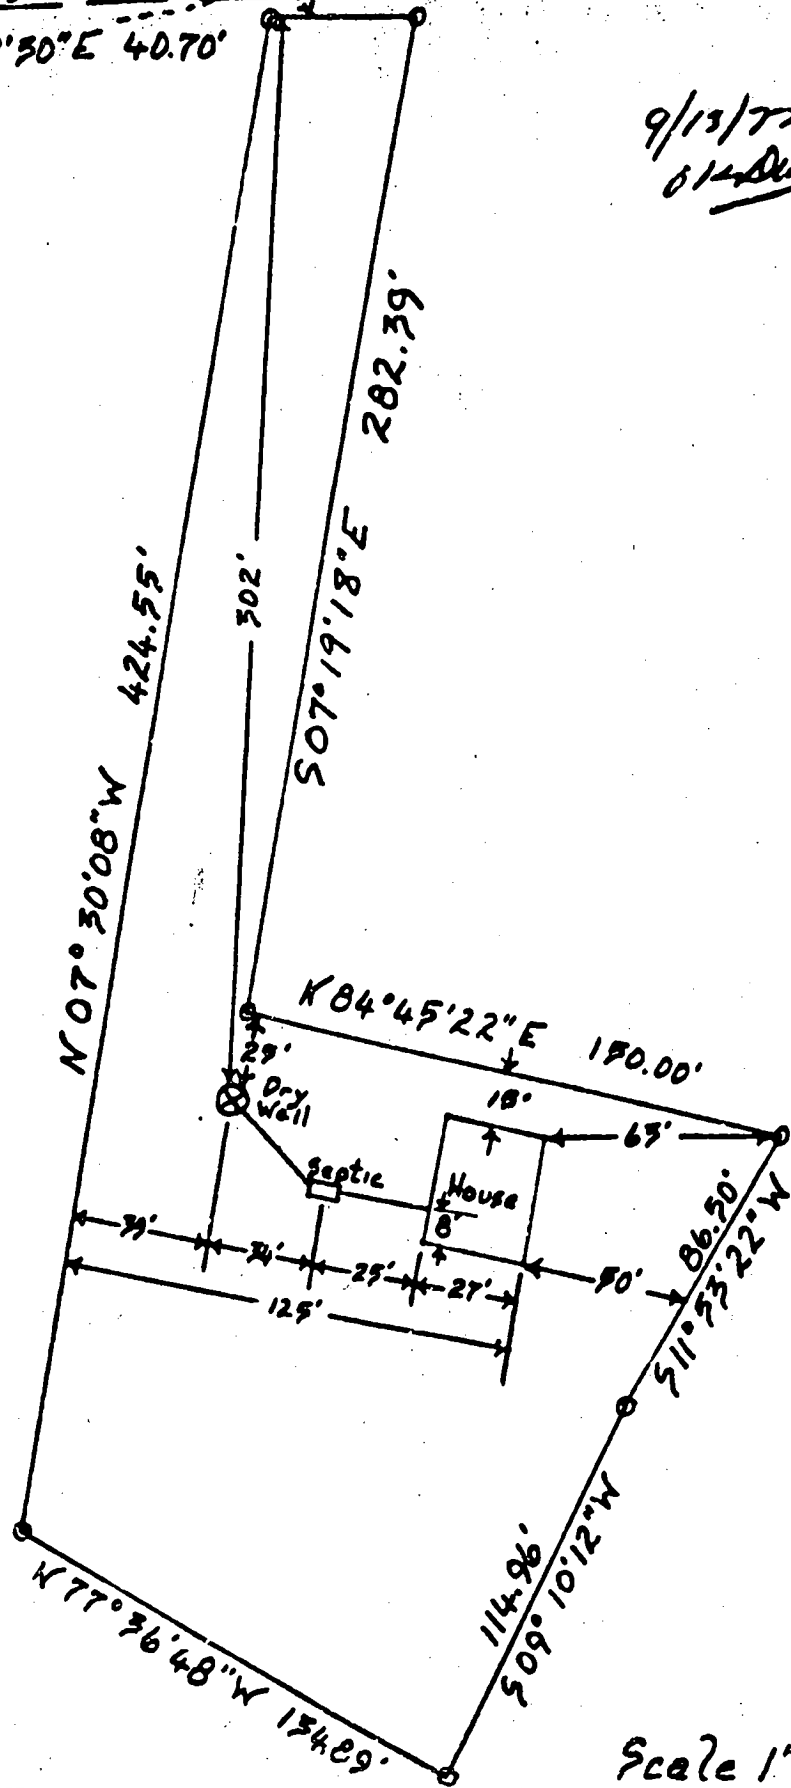

Scale 1" = 50'

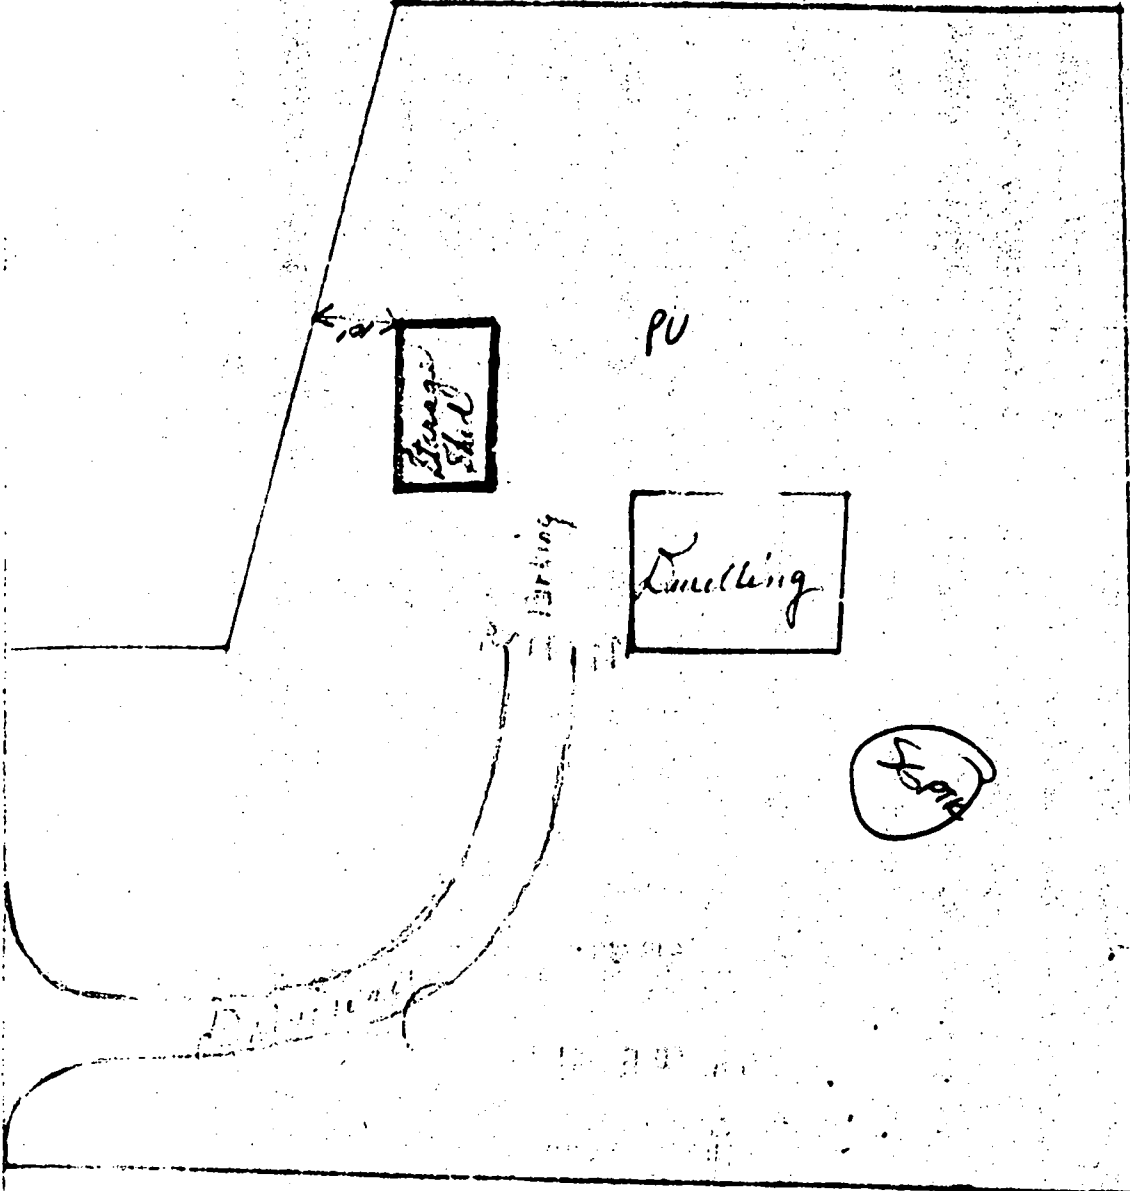

SOUTH

APPLICATION

HOWARD COUNTY

SERIAL NUMBER

# PERMIT APPLICATION

DEPARTMENT OF INSPECTIONS, LICENSES & PERMIT  
3430 COURT HOUSE DRIVE, ELLICOTT CITY, MARYLAND 21043

15002 #75 FF  
B0011879

BUILDING ADDRESS (HOUSE NO., STREET, TOWN OR AREA)

6199 LAWYERS HILL RD  
FLKRIDGE, MD. 21075 11438

GRADING/SEDIMENT CONTROL  YES  NO

SDP #

DESCRIPTION OF WORK AUTHORIZED

36 x 40' Addition to existing dwelling - (2) car garage WITH (3) Bedrooms Above (1) Relocated Bathroom

LOT NO.	PARCEL NO.	SEC.	AREA	BLOCK NO.	LIBER.	FOLIO
N/A	102	N/A	N/A	21		
SUB DIVISION		ZONE	ZONE MAP	ELEC. DIST.	CENSUS TR.	
N/A		REV	32	1	6.12	

OWNER NAME AND ADDRESS  
WILLIAM H BROWN  
MARY HOFBAUER BROWN 410-379-0417

PHONE NO.

OCCUPANT'S NAME AND ADDRESS  
SAME

PHONE NO.

ARCHITECT OR ENGINEER'S NAME AND ADDRESS  
CRAIG A. MORGAN  
534 6TH ST. SE.  
WASHINGTON, DC 20003

PHONE NO. 202-547-3245

CONTRACTOR'S NAME AND ADDRESS  
RESIDENTIAL CONSTRUCTION SERVICES  
1913 FAIRVIEW AVE  
BALTIMORE, MD 21227 410-536-0566

PHONE NO.

EXISTING USE  
Primary SFD  
RESIDENCE

PROPOSED USE  
SAME W/ADD.

EST. CONSTRUCTION COST. 80,000

LICENSE NUMBER 33325

PERMIT FEE

SIZE OF BLDG.	FRONT	DEPTH	HEIGHT

TYPE OF BLDG.	AREA	VOLUME	ROOF
B. ROOMS			
ROOMS			
BATHS			
FIREPLACES			

FOOTINGS	FOUNDATION	S. WALLS

UTILITIES				
WATER/WELL	SEWER/SEPTIC	GAS	ELECTRICITY	TYPE OF HEAT (AC)
				OIL

I have carefully examined and read this application and know the same is true and correct, and that is doing this work, all provisions of Howard County Ordinances and the State Laws of Maryland will be complied with, whether specified or not; and I will notify the Department of Inspections and Permits twenty-four hours in advance when I am ready for the inspections called for elsewhere in the application; and that no work will be covered up until such inspections have been completed with.

W. H. Morgan

OWNER'S SIGNATURE DATE 5-20-98

### FOR OFFICE USE ONLY

DISTANCE IN FEET FROM R/W LINE TO FRONT BUILDING LINE \_\_\_\_\_

SIDE YARD (DISTANCE IN FEET FROM SIDE BLDG. LINE TO SIDE PROPERTY LINE) \_\_\_\_\_

TO SIDE BUILDING LINE \_\_\_\_\_

DISTANCE IN FEET, REAR YD. REQUIRING SET \_\_\_\_\_

BACK \_\_\_\_\_ (CORNER LOT ONLY)

SDP # \_\_\_\_\_

Check payable to: DIRECTOR OF FINANCE OF HOWARD COUNTY

**CAUTION**

To begin construction before a permit placard has been issued and displayed on the job is a violation of the law.

Use and occupancy permit must be applied for two weeks before it will be issued.


IMPORTANT: PLEASE SHOW ZIP CODES AND AREA CODES WHEREVER REQUIRED.

LP-69-591 CR 1070

FUNCTION	DATE	SIGNATURE APPROVAL
ZONING/PLANNING		
SHA		
SEDIMENT/GRADING		
BUILDING OFFICIAL		
WATER & SEWER		
HEALTH DEPT.	6/2/98	Douglas
FIRE PROTECTION		
STORM WATER MGM		

APPROVED DATE

Distribution of Copies:  
White - Building Official  
Green - Planning & Zoning  
Yellow - Engineering  
Pink - Health Dept.  
Gold - S.H.A.

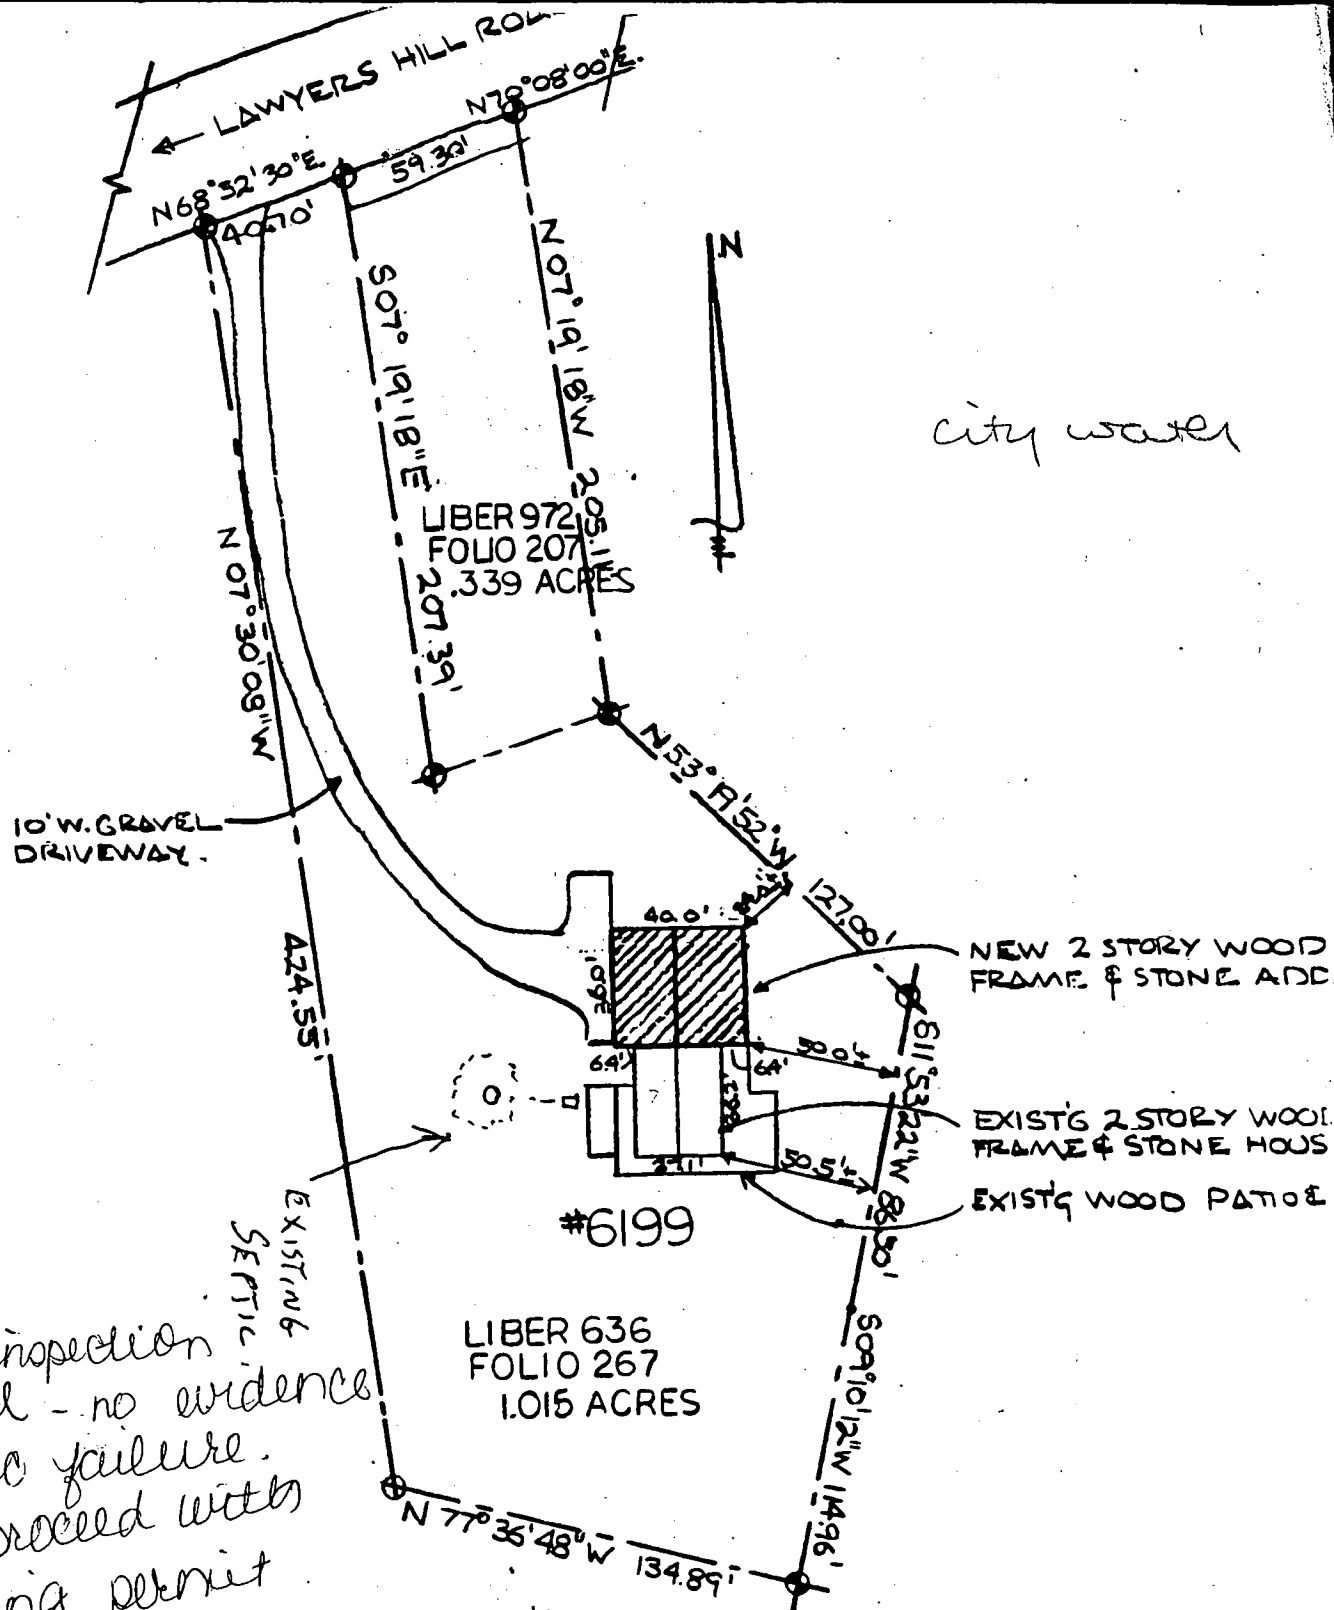

6/9/98 site inspection performed - no evidence of septic failure. OK to proceed with building permit w/o septic upgrade at this time.

**LOCATION SURVEY PLAT - HOWARD CO**

SCALE: 1" = 60'

SURVEY INFORMATION BY:  
 LDE INC.  
 9250 RUMSEY ROAD SUITE 106  
 COLUMBIA, MARYLAND 21045  
 (410) 715-1070  
 DATED 11-6-96

OUT YARD. (net # of beds = 3)

SET



---

HOWARD COUNTY HEALTH DEPARTMENT

---

Joyce M. Boyd, M.D., County Health Officer  
June 2, 1998

Mr. and Mrs. William Brown  
6199 Lawyers Hill Road  
Elkridge, Maryland 21075

RE: Proposed addition to existing dwelling  
6199 Lawyers Hill Road  
Building Permit #B00111879

Dear Mr. and Mrs. Brown:

This office has recently received the above referenced building permit application; however, we are unable to approve the application at this time.

The proposal is to add supplementary bedrooms to the existing house. Any proposal for an increase in number of bedrooms in a house indicates potential increase in sewage flow. Health Department records of the septic system currently serving the existing house indicate a system sized for three bedrooms, installed in April, 1973. Therefore, prior to consideration for Health Department approval of the proposal, evaluation and upgrade of the existing septic system shall be necessary.

Please contact me at (410) 313-2640 to discuss resolution of the Health Department concerns outlined above. Thank you in advance for your cooperation in this matter.

Sincerely,

Donna K. Soe, R.S.  
Water and Sewerage Program

DKS  
cc: file

*3 new/  
BUT MOVING UPSTAIRS*

*2 BATHS  
CHANGING LOCATION OF 2*

*MEET @ 10:00  
TUES DAY*

*(CW)*