

Repair 6/19/64

PERMIT

Approved 6/19/64 RF

P ~~08592~~
A PS11415-C

SEWAGE DISPOSAL SYSTEM

MARYLAND STATE DEPARTMENT OF HEALTH

HOWARD COUNTY

ELLICOTT CITY

DISTRICT 1

DATE 6/10/64

RE-INDEXED

RPS#?

R. D. Shilling Co. IS PERMITTED TO INSTALL ALTER

ADDRESS 52 Hunt Club Rd., Elkridge 27, Maryland PHONE 796-2200

A SEWAGE DISPOSAL SYSTEM LOCATED AT _____

SUBDIVISION _____ ROAD _____ LOT _____

PROPERTY OWNER Mrs. Marie E. Lohrig

ADDRESS Ilchester Road, Ellicott City, Maryland (2nd house east of Landing Rd.)

SPECIFICATIONS

DRAIN FIELD _____ DEPTH _____ FEET, BOTTOM AREA _____ SQ. FT.

SEEPAGE PITS _____ ABSORBENT SIDE-WALL AREA _____ SQ. FT.

SEPTIC TANK CAPACITY _____ GALLONS

FOR GARBAGE GRINDER, INCREASE DISPOSAL AREA 22% & TANK CAPACITY 50%.


OTHER Repair job - 300 sq. ft. drain field or leaching bed.

PLANS APPROVED BY _____ DATE _____

FILL SEPTIC TANK AND DISTRIBUTION BOX WITH WATER BEFORE CALLING FOR AN INSPECTION. COVER NO WORK UNTIL INSPECTED AND APPROVED.

NEITHER THE HOWARD COUNTY COMMISSIONERS NOR THE HEALTH DEPARTMENT IS RESPONSIBLE FOR THE SUCCESSFUL OPERATION OF ANY SYSTEM.

PS11415-C

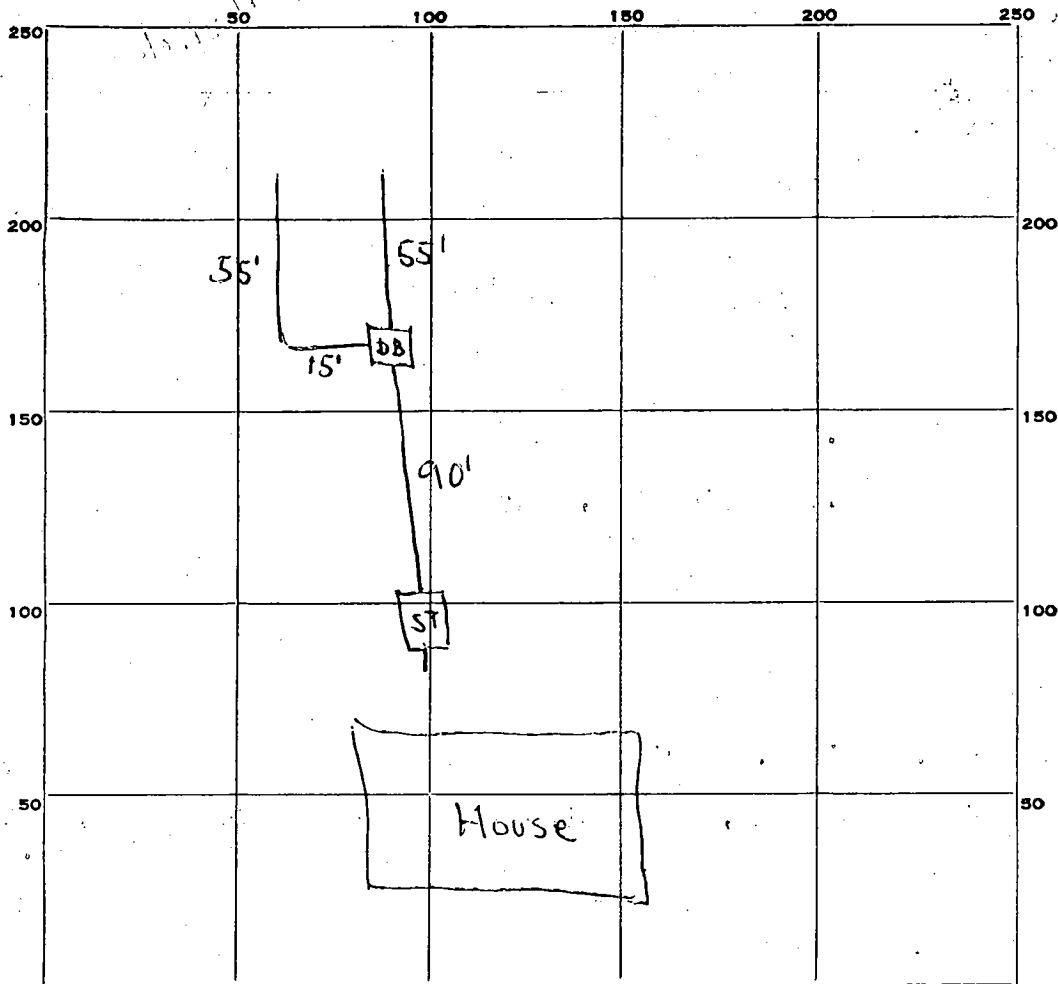

INDICATE NORTH. - NAME ADJOINING ROADWAY AS BASE LINE.

Hickster Rd.

PERMIT CARD OK

SEPTIC TANK, LEVEL OK CLEANOUTS OK

DISTRIBUTION BOX, LEVEL OK

TILE FIELD, DEPTH 3 1/2 FT. TRENCH WIDTH 3 FT.

GRAVEL DEPTH 12" IN. TOTAL LENGTH 110 FT.

NUMBER OF TRENCHES 2 TOTAL BOTTOM AREA 330 sq. ft.

SEEPAGE PITS, INSIDE DIAMETER _____ FT. DEPTH BELOW INLET _____ FT.

ABSORBENT AREA _____ SQ. FT.

REMARKS _____

DATE SYSTEM APPROVED 6/19/64

INSPECTOR R. F. [Signature]