

# APPLICATION

## FOR PERCOLATION TESTING AND SITE EVALUATION

TEST DATE(S) \_\_\_\_\_ TEST TIME \_\_\_\_\_

AP 520082-E

AGENCY REVIEW: \_\_\_\_\_

DATE 3/5/04

DO NOT WRITE ABOVE THIS LINE

HEREBY APPLY FOR THE NECESSARY TESTING/EVALUATION PRIOR TO ISSUANCE OF SEWAGE DISPOSAL SYSTEM PERMIT(S) TO:

CHECK AS NEEDED:

- CONSTRUCT NEW SEPTIC SYSTEM(S)
- REPAIR/ADD TO AN EXISTING SEPTIC SYSTEM
- REPLACE AN EXISTING SEPTIC SYSTEM

CHECK AS NEEDED:

- NEW STRUCTURE(S)
- ADDITION TO AN EXISTING STRUCTURE
- REPLACE AN EXISTING STRUCTURE

CHECK ONE:

- CREATE NEW LOT(S)
- BUILD ON AN EXISTING LOT IN A SUBDIVISION
- BUILD ON AN EXISTING PARCEL OF RECORD

IS THE PROPERTY WITHIN 2500' OF ANY RESERVOIR?

- YES
- NO

THE TYPE OF STRUCTURE IS:

- RESIDENTIAL WITH UNKNOWN PROPOSED BEDROOMS IN THE COMPLETED STRUCTURE (NOTE UNKNOWN IF APPROPRIATE)
- COMMERCIAL (PROVIDE DETAIL OF NUMBERS AND TYPES OF EMPLOYEES/ CUSTOMERS ON ACCOMPANYING PLAN)
- INSTITUTIONAL/GOVERNMENT (PROVIDE DETAIL OF NUMBERS AND TYPES OF EMPLOYEES/USERS ON ACCOMPANYING PLAN)

PROPERTY OWNER(S) PRINCE FLORENCE UNDINE

DAYTIME PHONE \_\_\_\_\_ CELL \_\_\_\_\_ FAX \_\_\_\_\_

MAILING ADDRESS \_\_\_\_\_ STREET \_\_\_\_\_ CITY/TOWN \_\_\_\_\_ STATE \_\_\_\_\_ ZIP \_\_\_\_\_

APPLICANT Hailey Development c/o RICH THOMETZ

DAYTIME PHONE (301) 476-7715 CELL (301) 346-1037 FAX (301) 476-7717

MAILING ADDRESS 3905 NATIONAL DRIVE, SUITE 105, BURTONSVILLE MD. 20866  
STREET CITY/TOWN STATE ZIP

APPLICANT'S ROLE:  DEVELOPER  BUILDER  BUYER  RELATIVE/FRIEND  REALTOR  CONSULTANT

PROPERTY LOCATION  
SUBDIVISION/PROPERTY NAME PRINCE PROPERTY LOT NO. 6

PROPERTY ADDRESS END OF HUNTERBROOKE LANE / HUNTFIELD DRIVE  
STREET TOWN/POST OFFICE

AX MAP PAGE(S) 46 GRID 1 37 PARCEL(S) 104 PROPOSED LOT SIZE 3 AC. +


AS APPLICANT, I UNDERSTAND THE FOLLOWING: THE SYSTEM INSTALLED SUBSEQUENT TO THIS APPLICATION IS ACCEPTABLE ONLY UNTIL PUBLIC SEWERAGE IS AVAILABLE. THIS APPLICATION IS COMPLETE WHEN ALL APPLICABLE FEES AND A DETAILED SITE PLAN HAVE BEEN RECEIVED. I ACCEPT THE RESPONSIBILITY FOR COMPLIANCE WITH ALL M.O.S.H.A. AND "UNIFORM UTILITY" REQUIREMENTS. APPROVAL IS BASED UPON SATISFACTORY REVIEW OF A PERC CERTIFICATION PLAN.

TEST RESULTS WILL BE MAILED TO APPLICANT. Zacharia G. Frisch (agent for Developer)  
SIGNATURE OF APPLICANT

HOWARD COUNTY HEALTH DEPARTMENT, BUREAU OF ENVIRONMENTAL HEALTH, WELL AND SEPTIC PROGRAM  
3525-H ELLICOTT MILLS DRIVE, ELLICOTT CITY, MARYLAND 21043-4544 (410) 313-1771 FAX (410) 313-2648  
TDD (410) 313-2323 TOLL FREE 1-877-4MD-DHMH

AP

627  
brnhvy  
salm  
15-20%  
Rx  
SE  
30-40%  
Rx  
H. brn  
tan  
salm  
15-20%  
saprolite

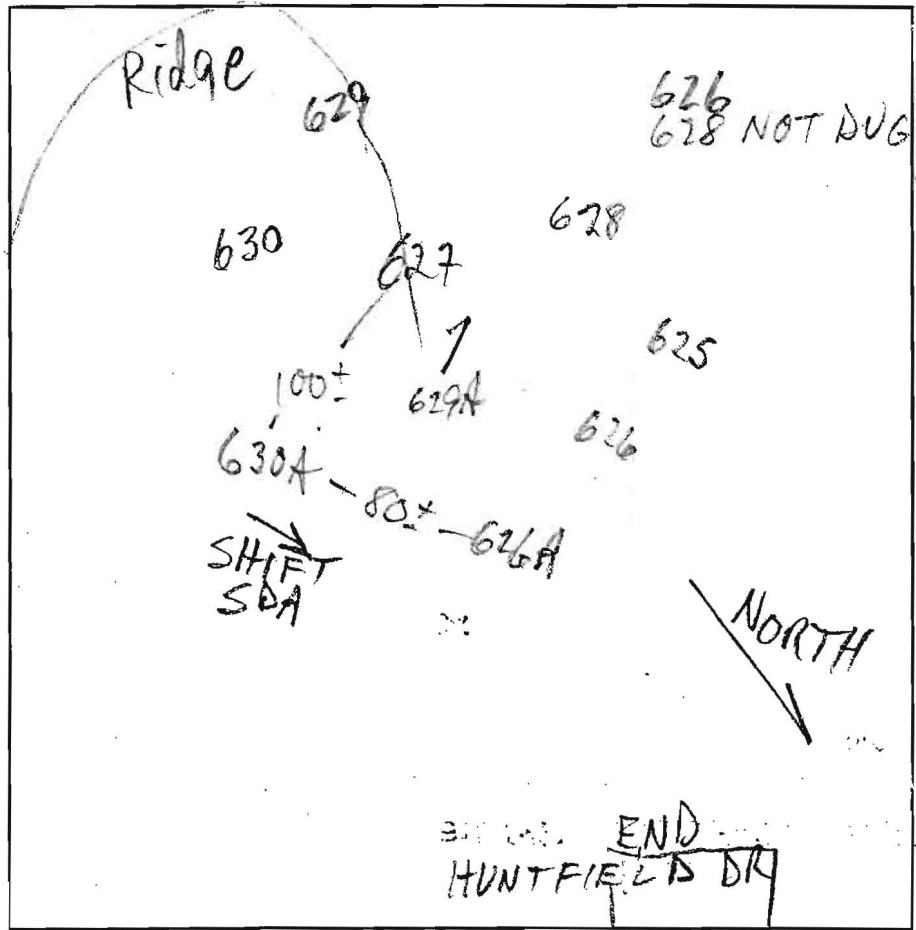

630A  
orge brn  
hvy lm  
4 1/2  
5 1/2  
sac l m  
brnhvylm  
30% Rx  
tan  
gray  
salm  
15% Rx  
7 1/2-8  
SE

625/29A  
orge sa  
cl l m  
H. brn  
salm  
15%  
Rx

DATE	TEST #	DEPTH	START	BREAK 1" DROP	STOP 2" DROP	TIME OF 2ND INCH	P/F/H
4/14/04	630v	2-3	ROCK	PER	KETTERMAN	F	
	629v	2-3	ROCK	PER	KETTERMAN	F	
	627v	6 13	12:53	1:00	1:09	9	P
	625v	12 1/2					P
	626AS	5 12	1:02	1:03	1:05	2	P
	629Av	13					P
	630Av	11 1/2	1:15	1:22	1:22		F
	630AS	OTHER 7 SDE	2:10	2:11	2:13	2	P

626A  
orge  
brn  
hvy lm  
tan  
H. brn  
salm  
10-15%  
frags

REMARKS ONLY 627, 625, 629, 630 PER PLAN; STAY NW OF HOLES AND  
SANITARIAN M. Ripkin BACKHOE KVK OTHERS Hanley Dev  
TEST HOLES USED IN SDA 625, 627, 629A, 626A, 630A AVG. PERC TIME 4 SQ. FT/BR 180  
TRENCH WIDTH 2 INLET DEPTH 4 MAX. BOT DEPTH 8 EFFECTIVE SW 3-4

12