


5A
 West wall
 strong org micac
 LEAM TRAIL KY
 brn, yorn
 TRAC
 Bottom 13'

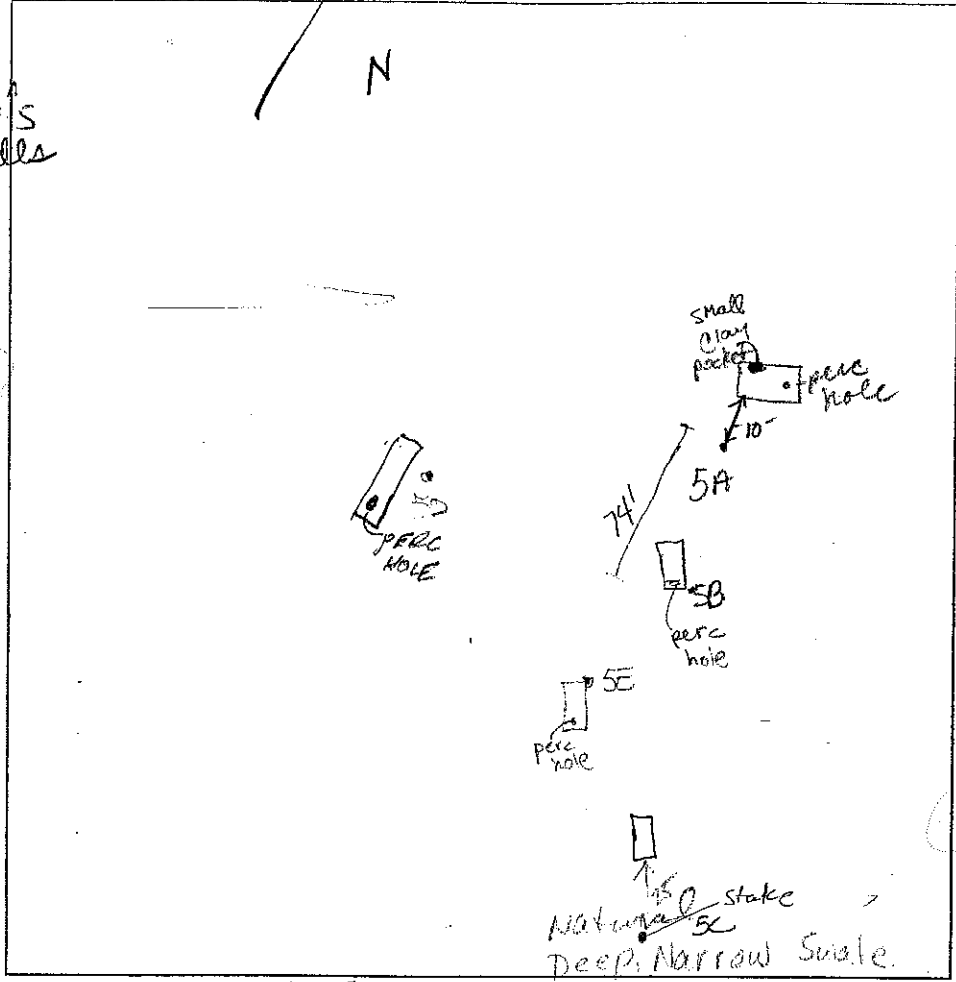

5B
 Wk org LS
 Very micac md gr sand brn 10"
 4'
 org brn sand md. grain tightly packed for 1' then loose SAND
 Bottom 13'

5E
 Wk organ
 Sand
 A few
 Tighter packed
 Bottom 13'

5C
 Strong org
 Shallow silts
 3'
 fine - md gr micac sand Rx 25%
 Bottom 12 1/2'

LOT 5

DATE	TEST #	DEPTH	START	BREAK 1" DROP	STOP 2" DROP	TIME OF 2nd INCH	P/F/H
10/28	5A	6' M / 14' V	1:00	1:03	1:07	4	P
	5E	5 1/2' M / 13' V	1:09	1:17	1:25	8	P
	5B	5 1/2' M / 13' V	1:21 ³⁰	1:31	1:42	11	P
	5D	7' M / 13'	1:37	1:39	1:42	3	P
	5C	5 1/2' M / 12 1/2'	1:45	1:49	1:56	7	P

5D
 Brown loam 6"
 Org
 Silty
 30-40% Cobble
 Quartz
 NE side
 Bottom 13'

REMARKS Hole dug 25' from stake 5C (in circle)
 SANITARIAN Kaci / FA BACKHOE _____ OTHERS Bob Skasby Mark Johnson
 TEST HOLES USED IN SDA _____ AVG. PERC TIME _____ SQ. FT/BR _____
 TRENCH WIDTH _____ INLET DEPTH _____ MAX. BOT DEPTH _____ EFFECTIVE SW _____