

DATE	TEST #	DEPTH	START	BREAK 1" DROP	STOP 2" DROP	TIME OF 2nd INCH	P/F/H
4/5/04	101	5 1/2' / 13'	AB	2:51	2:55	2min	F
	103	5 1/2' / 10 1/2'	02	3:05	3:07	2min	F
	102	6' / 13'	3:15	3:18	3:24	6min	F


REMARKS _____
 SANITARIAN FA BACKHOE Wille Snodden OTHERS Bob Sheasley
 TEST HOLES USED IN SDA _____ AVG. PERC TIME _____ SQ. FT/BR _____
 TRENCH WIDTH _____ INLET DEPTH _____ MAX. BOT DEPTH _____ EFFECTIVE SW _____

AP 601

Brown loam 1'
 Yellow Brown Silty Clay loam 4'
 Yellow Brown Silty loam 5-10% Micz 1293 11.5'

6A1
 Brown loam 1 1/2'
 Red Brown Silty Clay loam 4'
 Yellow Brown Silty loam 11'

6E1
 Brown loam 1'
 Red Brown Silty Clay loam 3 1/2'
 Yellow Brown Silty loam
 Silty loam 1590 Rock 11 1/2'

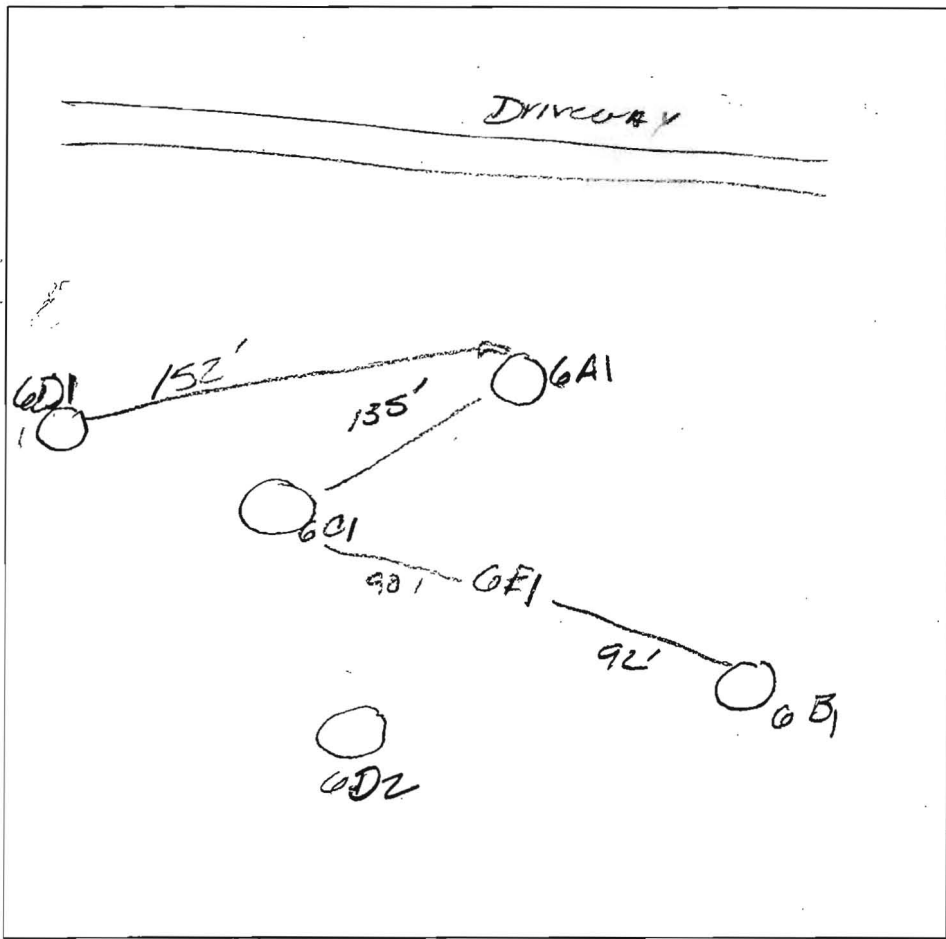

6B1
 Brown loam 1'
 Red Brown Silty Clay loam 3'
 Yellow Brown Silty loam 1590 Rock 10 1/2'
 WATER 12'

6D2
 Brown loam 1'
 Red Brown Silty Clay loam 4'
 Yellow Brown Silty loam
 Large stones and pieces of concrete 6'
 13'

DATE	TEST #	DEPTH	START	BREAK 1" DROP	STOP 2" DROP	TIME OF 2nd INCH	PIF/H
12/4/03	6C1	5' 11 1/2'	12 49	12 53	12 59	6min	P
	6A1	5' 11'	12 58	1 07	1 19	12min	P
	6E1	5 1/2' 11 1/2'	1 20	1 25	1 28	3min	P
	6B1	5 1/2' 12'	1 28	1 54	1 42	8min	P
	6D2	5 1/4' 13'	1 43	1 46	1 49	3min	P

REMARKS _____
 SANITARIAN FA BACKHOE ball the OTHERS Mark Johnson, Bob Sheesley
 TEST HOLES USED IN SDA _____ AVG. PERC TIME _____ SQ. FT/BR _____
 TRENCH WIDTH _____ INLET DEPTH _____ MAX. BOT DEPTH _____ EFFECTIVE SW _____