


A/P
 101
 Brown
 loam
 1'
 Red
 Sackey
 loam
 3'
 Brown
 Sackey
 15%
 Rock
 13'

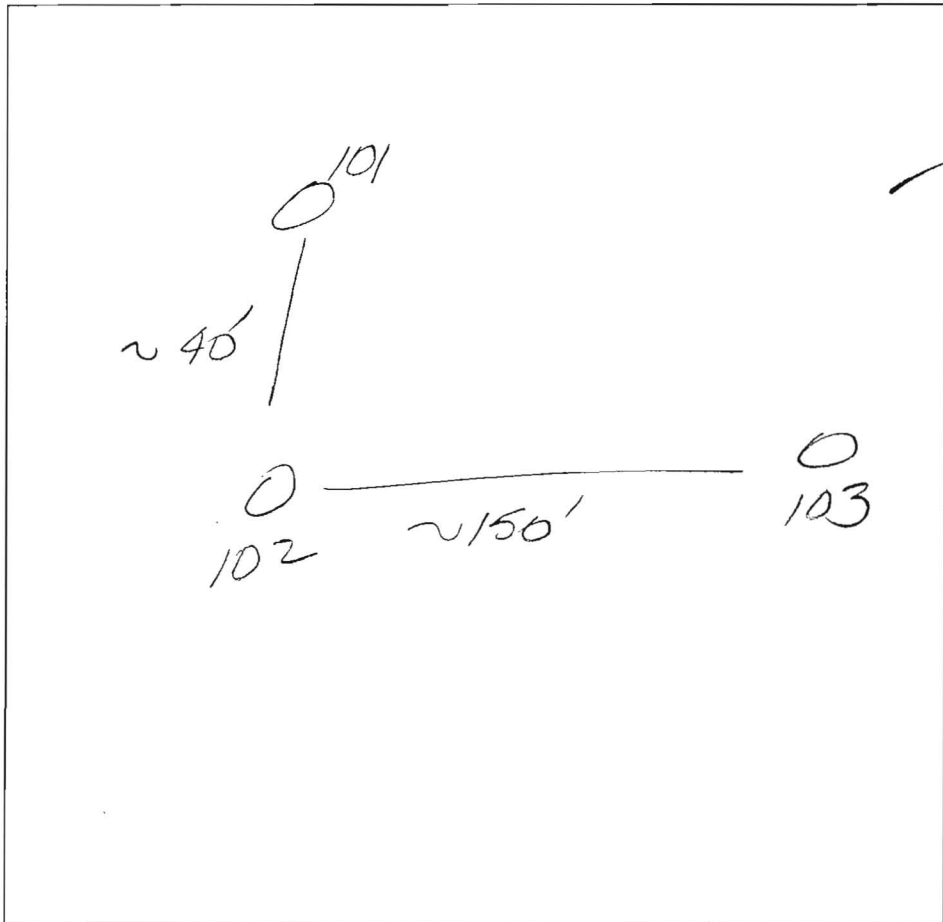

103
 Brown
 loam
 6'
 Brown
 Sackey
 15%
 Rock
 10 1/2'

DATE	TEST #	DEPTH	START	BREAK 1" DROP	STOP 2" DROP	TIME OF 2nd INCH	P/F/H
4/6/04	101	5 1/2' / 13'	AB	2 51	2 53	2min	F
	103	5 1/2' / 10 1/2'	3 02	3 05	3 07	2min	F
	102	6' / 13'	3 15	3 18	3 24	6min	P

Brown
 loam
 8"
 Yellow
 Brown
 Sackey
 loam
 3'
 Red
 Brown
 Sackey
 6'
 Yellow
 Brown
 Sackey
 15%
 Rock
 13'


REMARKS _____
 SANITARIAN FA BACKHOE Willie Swartz OTHERS Rob Sheasley
Mark Johnson
 TEST HOLES USED IN SDA _____ AVG. PERC TIME _____ SQ. FT/BR _____
 TRENCH WIDTH _____ INLET DEPTH _____ MAX. BOT DEPTH _____ EFFECTIVE SW _____

AP 601

Brown loam
 Yellow Brown Silty Clay loam
 Yellow Brown Silty loam
 5-10% Mica pebbles

601
 Brown loam
 Red Brown Silty Clay loam
 Yellow Brown Silty loam
 15% Rock

601
 Brown loam
 Red Brown Silty Clay loam
 Yellow Brown Silty loam
 15% Rock

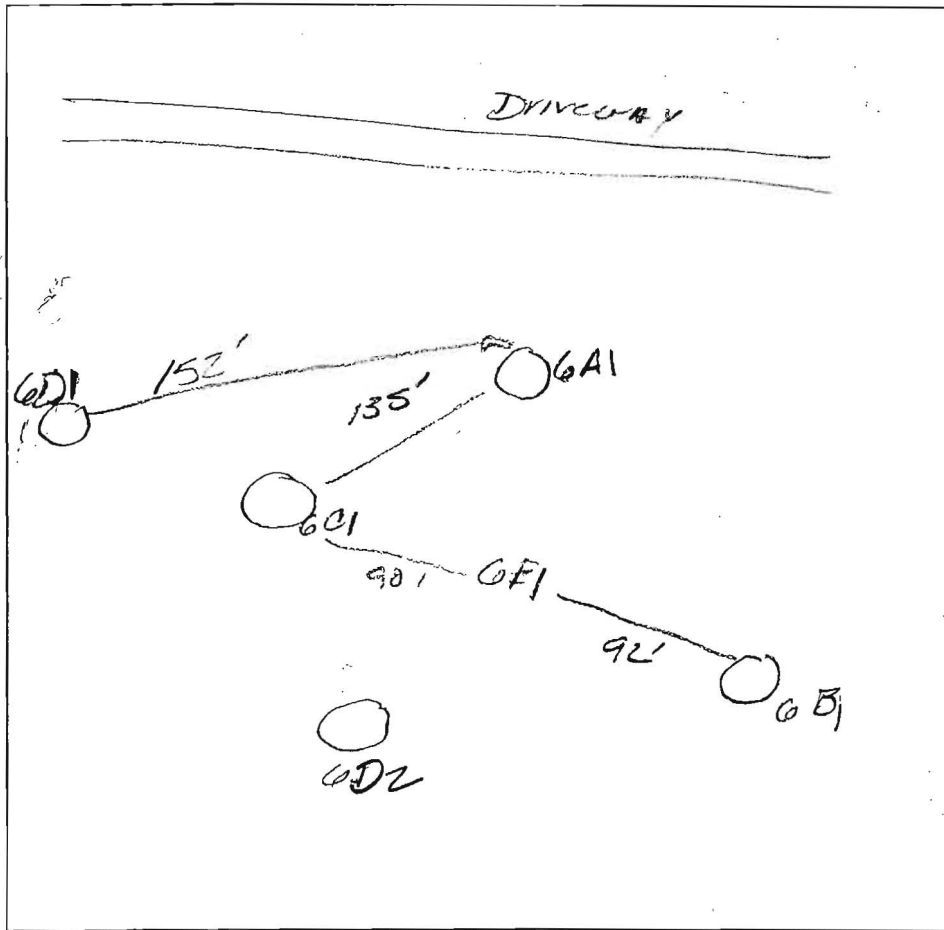

601
 Brown loam
 Red Brown Silty loam
 Yellow Brown Silty loam
 15% Rock
 WATER

601
 Brown loam
 Red Silty Clay loam
 Yellow Brown Silty loam
 Large string of mica pebbles quarried

DATE	TEST #	DEPTH	START	BREAK 1" DROP	STOP 2" DROP	TIME OF 2nd INCH	PIFIH
12/9/03	601	5' / 11 1/2'	12 49	12 53	12 59	6min	P
	60A1	5' / 11'	12 58	1 07	1 19	12min	P
	60E1	5 1/2' / 11 1/2'	1 28	1 25	1 28	3min	P
	60B1	5 1/2' / 12'	1 28	1 54	1 42	8min	P
	60D2	5 1/2' / 13'	1 43	1 46	1 49	3min	P

REMARKS _____
 SANITARIAN EA BACKHOE Trudger OTHERS Doletson, Mark Johnson, Bob Shuster
 TEST HOLES USED IN SDA _____ AVG. PERC TIME _____ SQ. FT/BR _____
 TRENCH WIDTH _____ INLET DEPTH _____ MAX. BOT DEPTH _____ EFFECTIVE SW _____

