

A/P 14C

Heavy Red Brown loam
3'
Platy micaceous loam of sand
Sand
Very friable
Saprophytic below 4"
15% Rx frags
HARD


BOTTOM 14D

Brown Red Brown loam
Solum of pockets of loam
Pock pocket on N. side
Weak orange 5-10% Rx frags
H. Brown sand

14E

Yellow clay loam
Crangit
Brown loam of pockets of solum

Brown very micaceous solum
upson
North wall

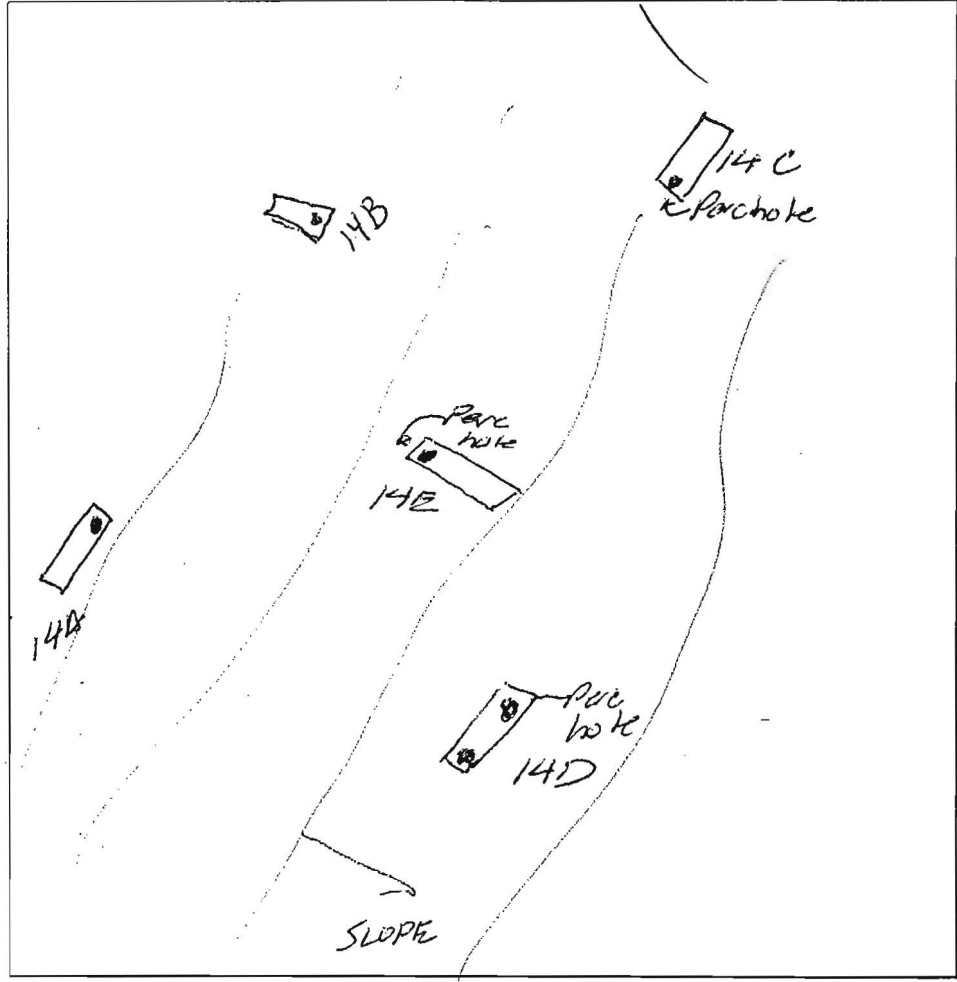

(14A) / 14D
Bm
s: cll
Ribbons 1 1/2 - 2"
rd, rdbrn
s: L
Rx ~ 5% ±
Horn
meas.
L SAND - S
sm Rx frags
~ 10%
H. Bottom

14B
SE
14A
above
11 1/2 H. Bottom

DATE	TEST #	DEPTH	START	BREAK 1" DROP	STOP 2" DROP	TIME OF 2nd INCH	P/F/H
10/29/03	14C	6' / 10'	16	20	26	6min	P
	14D	5 1/2' / 13'	34	36 1/2	39 2/3	6sec 3min	P
	14E	5 1/2' / 11'	46	49 1/4	55	6min	P
	14A	6' / 1 1/2'	2 00	02 00	04 10	4 2min	P
	14B	6' / 1 1/2'	2:15 ⁴¹	2:19 ⁴⁰	2:24	5	P

REMARKS _____
 SANITARIAN KO/FA BACKHOE _____ OTHERS Rob Sheesky
Mark Johnson
 TEST HOLES USED IN SDA _____ AVG. PERC TIME _____ SQ. FT/BR _____
 TRENCH WIDTH _____ INLET DEPTH _____ MAX. BOT DEPTH _____ EFFECTIVE SAW _____

E 1322215
N 541375

*Signed perc cert
10-1-07*

MATCHLINE SHEET 2 OF 3

