

A/P

1502

Brown loam




10"

Yellow Brown Silty loam

7'

Red Silty loam 15% Rock

12'

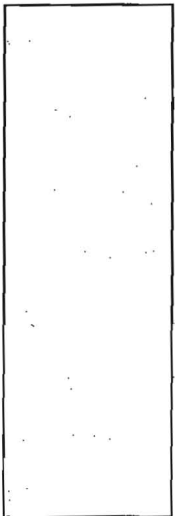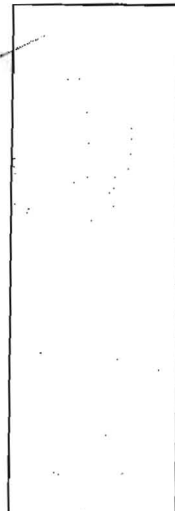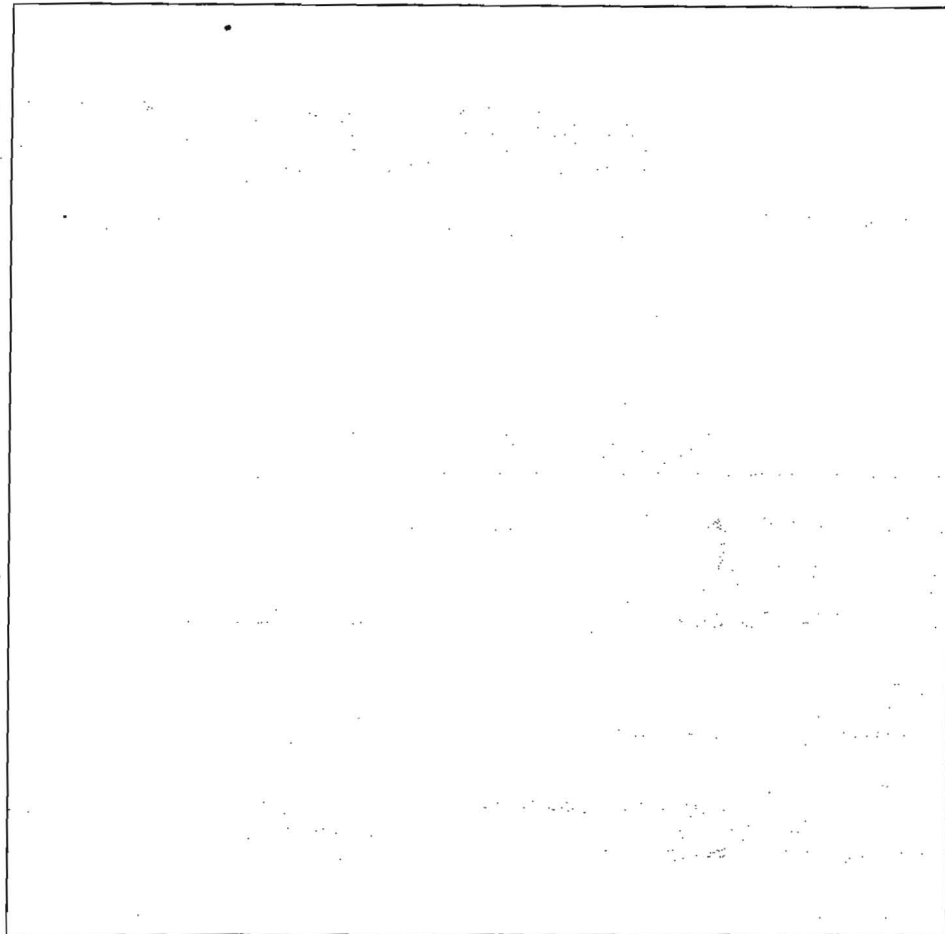

DATE	TEST #	DEPTH	START	BREAK 1" DROP	STOP 2" DROP	TIME OF 2nd INCH	P/F/H
12/16/03	1502	<del>7 1/2'</del> 12'	3 1/2'	3:30	4:00	30 min	P

REMARKS \_\_\_\_\_ *Wille* \_\_\_\_\_ *Mark Johnson*


SANITARIAN *FAH* \_\_\_\_\_ BACKHOE *Snowden* \_\_\_\_\_ OTHERS *Bob Schorsky* \_\_\_\_\_

TEST HOLES USED IN SDA \_\_\_\_\_ AVG. PERC TIME \_\_\_\_\_ SQ. FT/BR \_\_\_\_\_

TRENCH WIDTH \_\_\_\_\_ INLET DEPTH \_\_\_\_\_ MAX. BOT DEPTH \_\_\_\_\_ EFFECTIVE SW \_\_\_\_\_

15D  
Brown loam  
4'  
Yellow Brown Silty loam  
4'  
Red Silty loam  
↓  
Red Silty loam  
1590  
Rock  
14'

15E  
Brown loam  
4'  
Yellow Brown Silty loam  
4 1/2'  
Pocket Sand  
Quartz  
Yellow Brown Silty loam  
Red micaceous Silty loam  
Silt loam  
Hard Bottom  
7'

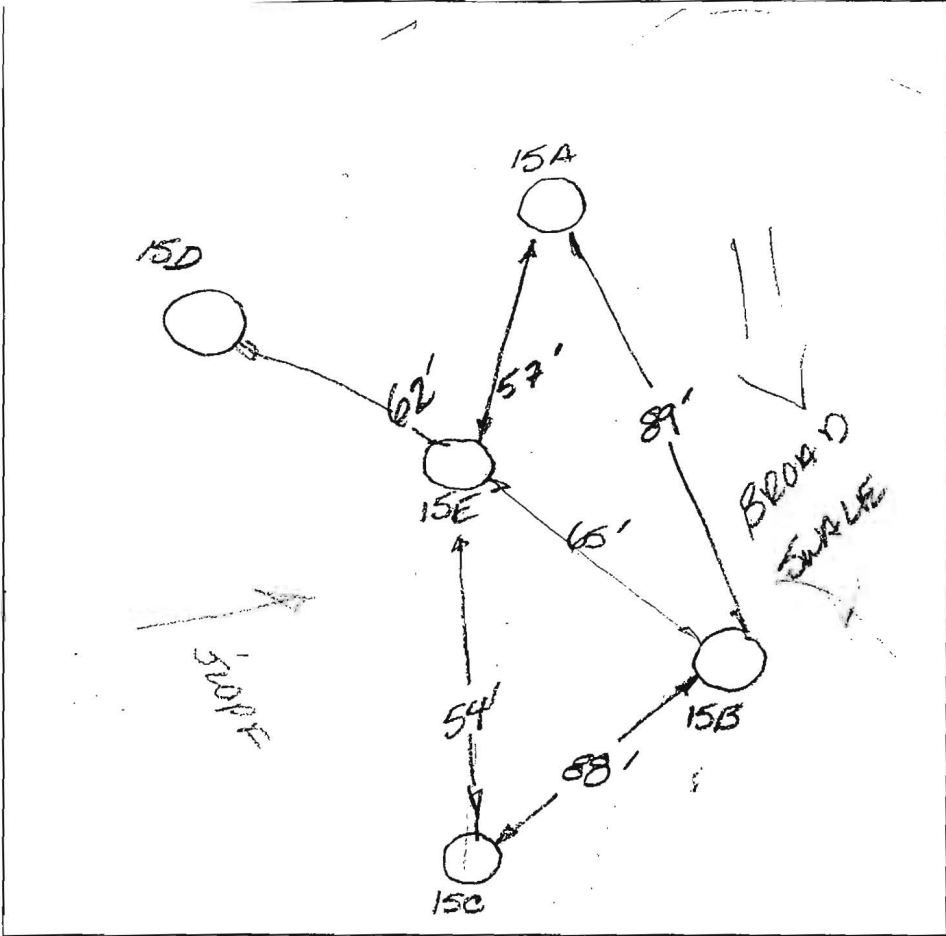


DATE	TEST #	DEPTH	START	BREAK 1" DROP	STOP 2" DROP	TIME OF 2nd INCH	P/F/H
11/20/03	15D	5 1/2' / 14'	11 18	STOPPED AFTER 20min			
	15E	NOT TESTED					
	15A	NOT DUG BECAUSE					
	15B	OF LANDSCAPE POSITION					
11/20/03 Re-test	15D	6 1/2' / 14'	11 45	09 12	33 12	24min	P

REMARKS WILLIE BOB SHAW'S KEY  
 SANITARIAN FA BACKHOE SMOUDEN OTHERS DALE JOHNSON  
 TEST HOLES USED IN SDA \_\_\_\_\_ AVG. PERC TIME \_\_\_\_\_ SQ. FT/BR \_\_\_\_\_  
 TRENCH WIDTH \_\_\_\_\_ INLET DEPTH \_\_\_\_\_ MAX. BOT DEPTH \_\_\_\_\_ EFFECTIVE SW \_\_\_\_\_

A/P 15A1

15A1  
 Brown Loam 1'  
 Yellow Brown Silty Clay Loam 5'  
 Red Silty loam 6 1/2'  
 Dense Yellow Silty Clay loam 9'  
 Red micaceous Silty loam 14'

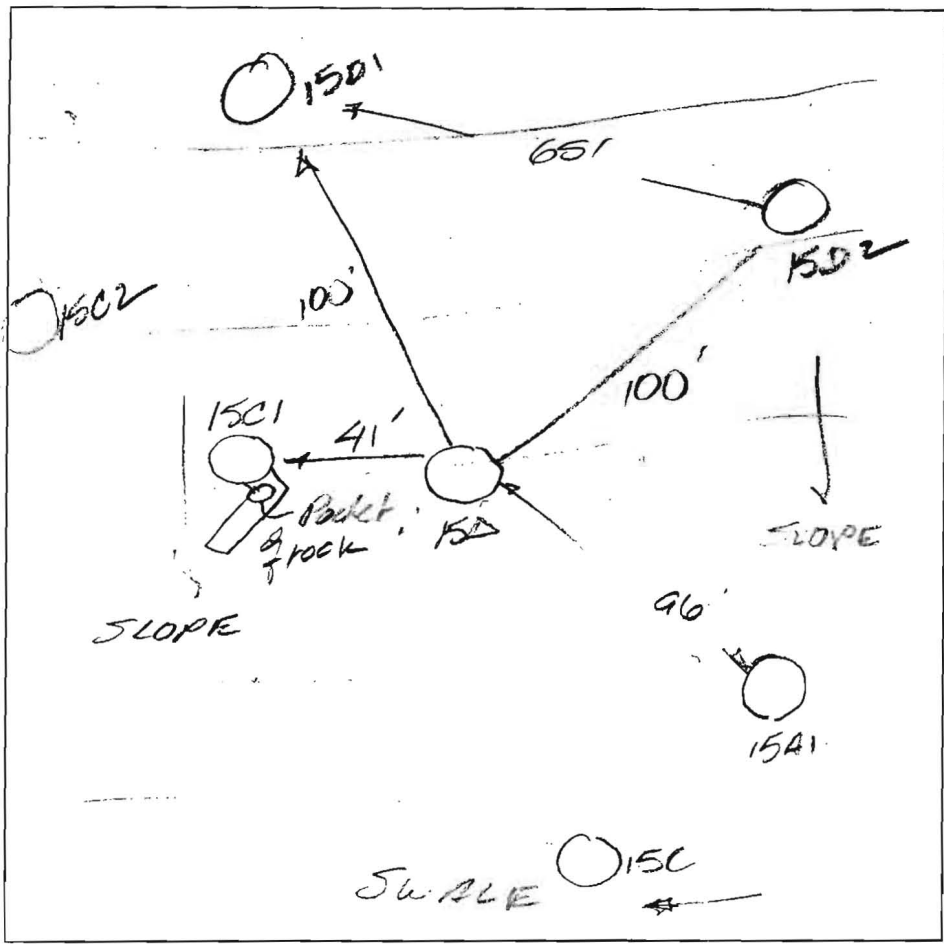

15C  
 Brown Loam 8"  
 Yellow Brown Silty Clay Loam 6'  
 Red Silty loam 6 1/2'  
 Dense Yellow Silty loam 7'  
 Red Brown Red Silty loam 13'

1501  
 Brown Loam 1'  
 Dense Yellow Silty loam 3'  
 Dense Red Silty loam 5 1/2'  
 Red Silty loam  
 Silty loam  
 1590 Channery MUD 12 1/2'

15D2  
 Brown Loam 1'  
 Yellow Brown Silty Clay loam 3 1/2'  
 Red Silty loam

DATE	TEST #	DEPTH	START	BREAK 1" DROP	STOP 2" DROP	TIME OF 2nd INCH	P/F/H	
11/20/03	15D1	5 1/2' / 12 1/2'	11 33	11 47	12 06	19 min	P	
	15A1	14'	NOT TESTED					
	15D2	6' / 13'	12 12	STOPPED @ 1:45 after 1/2"				
	15C	7' / 13'	1 13	1 20	1 27	7 min	P	
	15C1	7' / 13'	1 30	1 37	1 44	7 min	P	
retest	15D2	7 1/2'	2 55	3 09	3 37	30 min	P	
		15D3	Per BS notes					
		15D						

REMARKS \_\_\_\_\_  
 SANITARIAN FA BACKHOE WILLIE SNOWDEN OTHERS MARK JOHNSON, DALE JOHNSON, BOB SHEPHERD  
 TEST HOLES USED IN SDA \_\_\_\_\_ AVG. PERC TIME \_\_\_\_\_ SQ. FT/BR \_\_\_\_\_  
 TRENCH WIDTH \_\_\_\_\_ INLET DEPTH \_\_\_\_\_ MAX. BOT DEPTH \_\_\_\_\_ EFFECTIVE SW \_\_\_\_\_

N 541375

Signed perc cert  
10-1-07

MATCHLINE SHEET 2 OF 3

EX. S  
AND  
TO BE

GIB

MF BR15D1  
ELEV. = 407.50

MF 15D2  
ELEV. = 408.00

BR15C2  
ELEV. = 410.00

MF BR15A  
ELEV. = 405.50

MF 15A1  
ELEV. = 402.50

MF BR15D  
ELEV. = 403.00

MF BR15C  
ELEV. = 402.00

EKB2

LOT 10  
3.27 AC.  
EKB2

LOT 16  
3.34 AC.

MF BR10D  
ELEV. = 401.00

MF BR10A  
ELEV. = 404.00

MF BR10E 11186SF  
ELEV. = 402.50

MF BR10C  
ELEV. = 401.50

MF BR10B  
ELEV. = 403.50

LOT 15  
3.08 AC.

GnC2

MF BR14D  
ELEV. = 392.00

MF BR14A  
ELEV. = 399.50

MF BR14E  
ELEV. = 395.25

MF BR14C  
ELEV. = 392.00

MF BR14B

LOT 11  
3.19 AC.

RT3B  
= 390.25

