

11/27/79
H 29/79
a-o-p

approved 11/28/79
J. Stayer
P 30383

PERMIT

SEWAGE DISPOSAL SYSTEM

A REPAIR

MARYLAND STATE DEPARTMENT OF HEALTH*

HOWARD COUNTY

INDEXED

ELLICOTT CITY

DISTRICT _____

DATE 11/26/79

Jack Fyock

IS PERMITTED TO INSTALL ALTER X

ADDRESS Glennlg, Md.

PHONE _____

SUBDIVISION _____ ROAD Lime Kiln Road

LOT _____

PROPERTY OWNER Wolfel

Rt. 216 - 2nd house past Maucks Meat Market on right hand side.

ADDRESS Lime Kiln Road

SPECIFICATIONS

SEPTIC TANK CAPACITY _____ GALLONS

DRAIN FIELD _____ DEPTH _____ FEET, BOTTOM AREA _____ SQ. FT.

DEEP TRENCH _____ DEPTH _____ FEET, BOTTOM AREA _____ SQ. FT.

SEEPAGE PITS _____ ABSORBENT SIDE-WALL AREA _____ SQ. FT.

INLET PIPE 5 FT. BELOW ORIGINAL GRADE. MAXIMUM DEPTH 12 FT. BELOW ORIGINAL GRADE

EFFECTIVE DEPTH AT _____ FT. BELOW ORIGINAL GRADE.

LOCATE DISPOSAL AREA _____ FT. FROM _____ LOT LINE AND _____ FT. FROM _____ LOT LINE AS SEEN WHEN FACING LOT FROM

REPAIR-CALL FOR INSPECTION WHEN GROUND IS OPENED UP SO SANITARIAN CAN RECOMMEND

REPAIR. MINIMUM REQUIREMENT FOR ANY REPAIR WILL BE 120 SQ. FT. PER BEDROOM.

Trenches - 65' to 75' long. Maximum depth 12 ft - inlets at 5 ft. 5 ft buffer - 7 ft gravel

PLANS APPROVED BY Palmer Wine

DATE 11/26/79

COVER NO WORK UNTIL INSPECTED AND APPROVED.

NEITHER THE HOWARD COUNTY COUNCIL NOR THE HEALTH DEPARTMENT IS RESPONSIBLE FOR THE SUCCESSFUL OPERATION OF ANY SYSTEM.

NOTE: IF TRENCH IS USED CALL FOR INSPECTION BEFORE PLACING GRAVEL IN TRENCH.

NOTE: NO DRY WELL SHALL EXCEED 15 FOOT IN DIAMETER.


NOTE: ALL PIPE FROM HOUSE TO DISPOSAL AREA MUST BE CAST IRON.

PERMIT VOID AFTER THREE YEARS.

NOTE: INSTALL STAND PIPE ON SEPTIC TANK AND DRY WELL. STAND PIPES MUST BE 6 INCHES IN DIAMETER. CAST IRON, CONCRETE OR TERRA COTTA ACCEPTED.

*INSTALLER IS RESPONSIBLE FOR OBTAINING FINAL APPROVAL ON THIS PERMIT.

P 30383

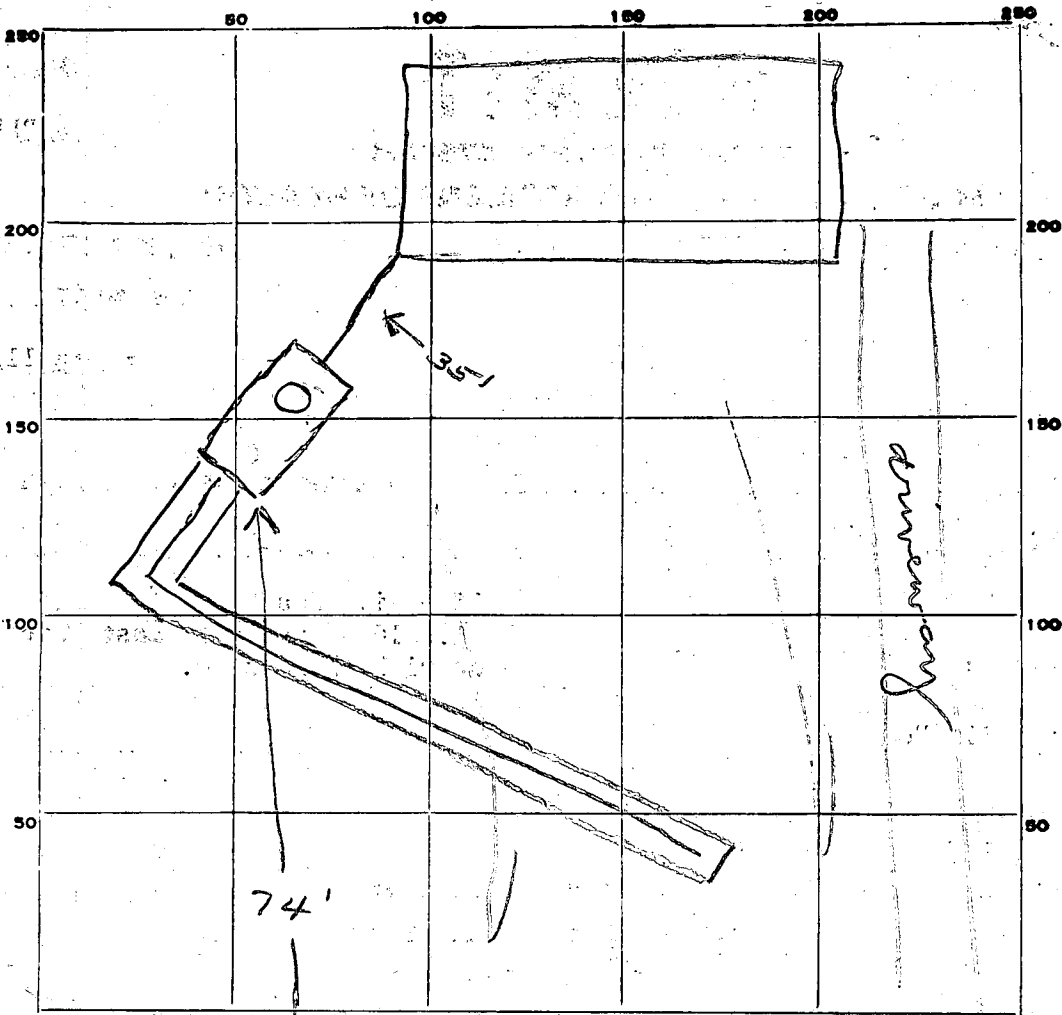

PERMIT CARD: No Lime Kiln Rd.

SEPTIC TANK, LEVEL CLEANOUTS 5T

DISTRIBUTION BOX, LEVEL manhole

TILE FIELD, DEPTH 12 FT. TRENCH WIDTH 2 FT.

GRAVEL DEPTH 7 IN. TOTAL LENGTH 75 FT.

NUMBER OF TRENCHES 1 TOTAL BOTTOM AREA 525

SEEPAGE PITS, INSIDE DIAMETER _____ FT. DEPTH BELOW INLET _____ FT.

ABSORBENT AREA 525 SQ. FT.

REMARKS 11/27/79 - trench to be 65 to 75 ft long, 12 ft deep,
inlets at 5 ft, with 7 ft gravel. Call for trench inspection. J
11/27/79 - OK to add gravel to trench. New septic
tanks needed - call when ready. J
11/28/79 OK to cover all work. J

DATE SYSTEM APPROVED 11/28/79 INSPECTOR J. Stayer