

PERMIT

SEWAGE DISPOSAL SYSTEM

MARYLAND STATE DEPARTMENT OF HEALTH*

HOWARD COUNTY

ELLICOTT CITY

DISTRICT 3rd.

DATE 3/19/80

P 30571

A REPAIR

INDEXED

03-298108

Jack Fyock

IS PERMITTED TO INSTALL ALTER X

ADDRESS 13775 Triadelphia Road PHONE 286-2939

SUBDIVISION Woodmark ROAD 12221 Ioka Court LOT 51

PROPERTY OWNER Richard A. Wafer

ADDRESS 12221 Ioka Court, Ellicott City, Md. 21043 PHONE: 988-9550

SPECIFICATIONS

SEPTIC TANK CAPACITY _____ GALLONS

DRAIN FIELD _____ DEPTH _____ FEET, BOTTOM AREA _____ SQ. FT.

DEEP TRENCH _____ DEPTH _____ FEET, BOTTOM AREA _____ SQ. FT.

SEEPAGE PITS _____ ABSORBENT SIDE-WALL AREA _____ SQ. FT.

INLET PIPE _____ FT. BELOW ORIGINAL GRADE. MAXIMUM DEPTH _____ FT. BELOW ORIGINAL GRADE

EFFECTIVE DEPTH AT _____ FT. BELOW ORIGINAL GRADE.

LOCATE DISPOSAL AREA _____ FT. FROM _____ LOT LINE AND _____ FT. FROM _____ LOT LINE AS SEEN WHEN FACING LOT FROM

REPAIR One - 60 foot long trench - 7-8 foot of stone under pipe - come off

old dry well with 3-5 foot earth buffer and then 60 foot trench. Maximum depth 12 feet to run paralled to back of house and on contour of ground as much as possible.

PLANS APPROVED BY C.B.Streaker DATE 3/19/80

COVER NO WORK UNTIL INSPECTED AND APPROVED.

NEITHER THE HOWARD COUNTY COUNCIL NOR THE HEALTH DEPARTMENT IS RESPONSIBLE FOR THE SUCCESSFUL OPERATION OF ANY SYSTEM.

NOTE: IF TRENCH IS USED CALL FOR INSPECTION BEFORE PLACING GRAVEL IN TRENCH.

NOTE: NO DRY WELL SHALL EXCEED 15 FOOT IN DIAMETER.

NOTE: ALL PIPE FROM HOUSE TO DISPOSAL AREA MUST BE CAST IRON.

PERMIT VOID AFTER THREE YEARS.

NOTE: INSTALL STAND PIPE ON SEPTIC TANK AND DRY WELL. STAND PIPES MUST BE 6 INCHES IN DIAMETER. CAST IRON, CONCRETE OR TERRA COTTA ACCEPTED.


***INSTALLER IS RESPONSIBLE FOR OBTAINING FINAL APPROVAL ON THIS PERMIT.**

*final
3/20/80
AM 2/19/80*

9.30

app 3-19-80
NEW

P
A
30571

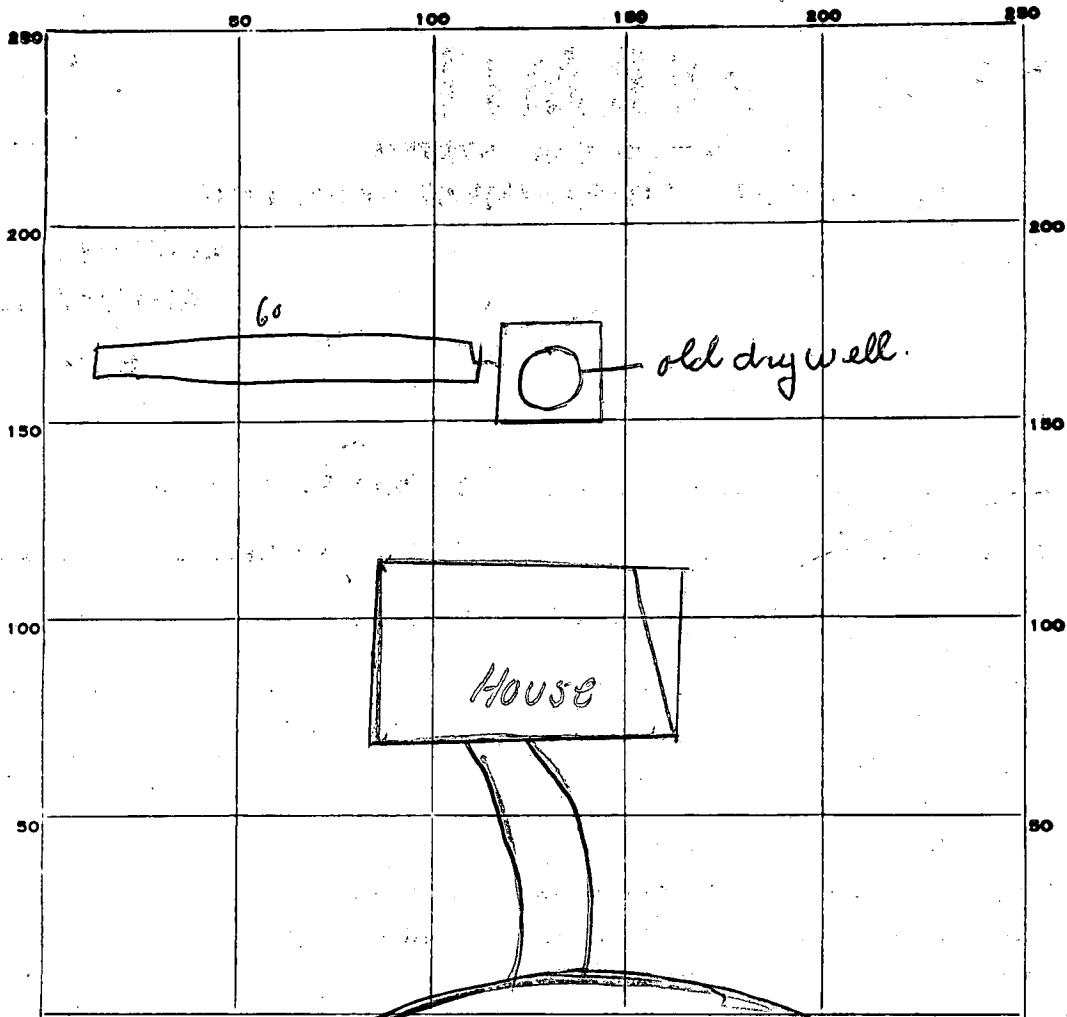

INDICATE NORTH NAME ADJOINING ROADWAY AS BASE LINE.

John Court

PERMIT CARD _____

SEPTIC TANK, LEVEL NA

CLEANOUTS NA

DISTRIBUTION BOX, LEVEL NA

TILE FIELD, DEPTH 12' FT. TRENCH WIDTH 18" to 24"

GRAVEL DEPTH ~~108~~ 96 IN. TOTAL LENGTH 60 FT.

NUMBER OF TRENCHES 2 TOTAL BOTTOM AREA 120

SEEPAGE PITS, INSIDE DIAMETER NA FT. DEPTH BELOW INLET 4' FT.

ABSORBENT AREA _____ SQ. FT. *one side of trench*

REMARKS *3-14-80* OK to cover just 60 ft of trench - depth as per owner. *PLW*

OK + only added trench dug - because letter from owner states on depth of trench add 10' gravel.

DATE SYSTEM APPROVED 3-19-80

INSPECTOR *W. Money*

APPLICATION

Repair Per
3/19/80
9:30 A.M.

SEWAGE DISPOSAL TESTING

STATE OF MARYLAND - DEPARTMENT OF HEALTH AND MENTAL HYGIENE

A _____
P Repair

HOWARD COUNTY HEALTH DEPARTMENT
ENVIRONMENTAL HEALTH SERVICES
P.O. BOX 476 ELLICOTT, MARYLAND 21043
TELEPHONE: 992-2330

DISTRICT 3rd

DATE 3/17/80

TO: THE COUNTY HEALTH OFFICER
ELLICOTT CITY, MARYLAND

I, HEREBY, APPLY FOR THE NECESSARY TEST IN ORDER TO CONSTRUCT (OR RECONSTRUCT) A SEWAGE DISPOSAL SYSTEM.

PROPERTY OWNER Richard A. Wafer

ADDRESS 12221 Ioka Court, Ellicott City, Md. 21043 PHONE 988-9550

PROPERTY LOCATION:

SUBDIVISION Woodmark LOT NO. (?)

ROAD AND DESCRIPTION 12221 Ioka Court

SIZE OF LOT ? TYPE BLDG. ?

THE SYSTEM INSTALLED UNDER THIS APPLICATION IS ACCEPTABLE ONLY UNTIL PUBLIC FACILITIES BECOME AVAILABLE.

I FULLY UNDERSTAND THE FEE CONNECTED WITH THE FILING OF THIS PERC TEST APPLICATION IS NON-REFUNDABLE UNDER ANY CIRCUMSTANCES.

SIGNATURE OF APPLICANT /s/ Jack Fyock for Richard A. Wafer

APPROVED BY C. B. Shaker FOR Repair Trench DATE 3/19/80

REJECTED BY _____ FOR _____ DATE _____

HOLD PENDING FURTHER TESTS _____ DATE _____



REASONS FOR REJECTION OR HOLDING 3/19/80 for Repair Permit 1' 60' long trench

{ 7'-8' of stones under pipe come off old dry well
with 3'-5' earth bulfin + then 60' trench maximum depth 12'
to run parallel to block of house + on contour of ground as much
as possible C.B.S.

THIS IS NOT A PERMIT

51

SOIL PROFILE

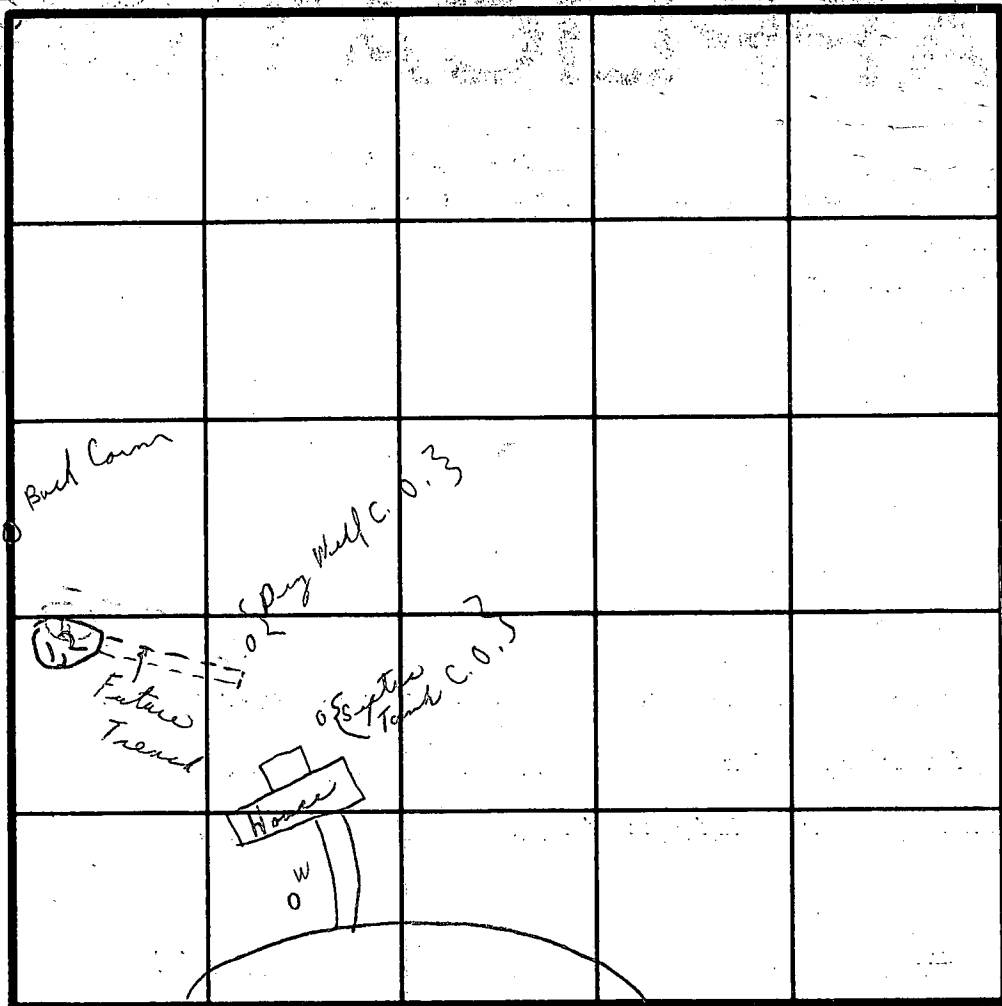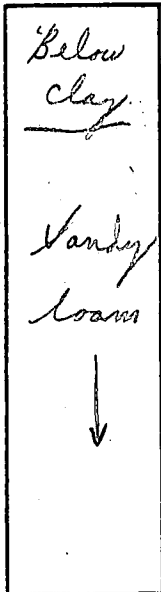

Field sheet

INDICATE NORTH - NAME ADJOINING ROADWAY AS BASE LINE.

Loka Court

DATE	TEST NO.	DEPTH	PRE-WET		TEST - 1" DROP		TIME
			START	STOP	START	STOP	
3/19/80	1	4'					
	2	12'		Sandy			
	3	1'					
	4	1'					

REMARKS Possibly #51 { 1:60' Trench (inlet off old) }
 TYPE OF SOIL Sandy loam { staying @ least 10' off each line }
 TESTED BY C. B. J. { Mr. Wager }
 ALSO PRESENT { Mr. Frock }
 { Mr. Pittenger }