

4/22/80  
after 9:00 P.M.

01-168428

# PERMIT

P 30641

SEWAGE DISPOSAL SYSTEM

m A REPAIR

MARYLAND STATE DEPARTMENT OF HEALTH

NOT APPROVED 4/22/80

HOWARD COUNTY

ELLICOTT CITY RH/CW

INDEXED

NO RECORD OF COMPLETED INSPECTION  
AS OF 7/17/95

DISTRICT 1st.

DATE 4/21/80

INDEX "AS IS" (CW)

Don Will Plumbing

IS PERMITTED TO INSTALL \_\_\_\_\_ ALTER X

ADDRESS 5003 Landing Road, Elkridge, Md. 21227 PHONE 744-6958

SUBDIVISION \_\_\_\_\_ ROAD 5041 Landing Road LOT \_\_\_\_\_

PROPERTY OWNER Harrison

ADDRESS 5041 Landing Road, Elkridge, Md. 21227 PHONE: 788-2882

SPECIFICATIONS

SEPTIC TANK CAPACITY \_\_\_\_\_ GALLONS

DRAIN FIELD \_\_\_\_\_ DEPTH \_\_\_\_\_ FEET, BOTTOM AREA \_\_\_\_\_ SQ. FT.

DEEP TRENCH \_\_\_\_\_ DEPTH \_\_\_\_\_ FEET, BOTTOM AREA \_\_\_\_\_ SQ. FT.

SEEPAGE PITS \_\_\_\_\_ ABSORBENT SIDE-WALL AREA \_\_\_\_\_ SQ. FT.

INLET PIPE \_\_\_\_\_ FT. BELOW ORIGINAL GRADE. MAXIMUM DEPTH \_\_\_\_\_ FT. BELOW ORIGINAL GRADE

EFFECTIVE DEPTH AT \_\_\_\_\_ FT. BELOW ORIGINAL GRADE.

LOCATE DISPOSAL AREA \_\_\_\_\_ FT. FROM \_\_\_\_\_ LOT LINE AND \_\_\_\_\_ FT. FROM \_\_\_\_\_ LOT LINE AS SEEN WHEN FACING LOT FROM


REPAIR - replace 1000 gal. septic tank. CALL FOR INSPECTION WHEN GROUND IS OPENED UP AND SEPTIC TANK IS IN PLACE.

PLANS APPROVED BY Palmer Wine DATE 4/21/80

- COVER NO WORK UNTIL INSPECTED AND APPROVED.
- NEITHER THE HOWARD COUNTY COUNCIL NOR THE HEALTH DEPARTMENT IS RESPONSIBLE FOR THE SUCCESSFUL OPERATION OF ANY SYSTEM.
- NOTE: IF TRENCH IS USED CALL FOR INSPECTION BEFORE PLACING GRAVEL IN TRENCH.
- NOTE: NO DRY WELL SHALL EXCEED 15 FOOT IN DIAMETER.
- NOTE: ALL PIPE FROM HOUSE TO DISPOSAL AREA MUST BE CAST IRON.
- PERMIT VOID AFTER THREE YEARS.
- NOTE: INSTALL STAND PIPE ON SEPTIC TANK AND DRY WELL. STAND PIPES MUST BE 6 INCHES IN DIAMETER. CAST IRON, CONCRETE OR TERRA COTTA ACCEPTED.

**\*INSTALLER IS RESPONSIBLE FOR OBTAINING FINAL APPROVAL ON THIS PERMIT.**

A 30641

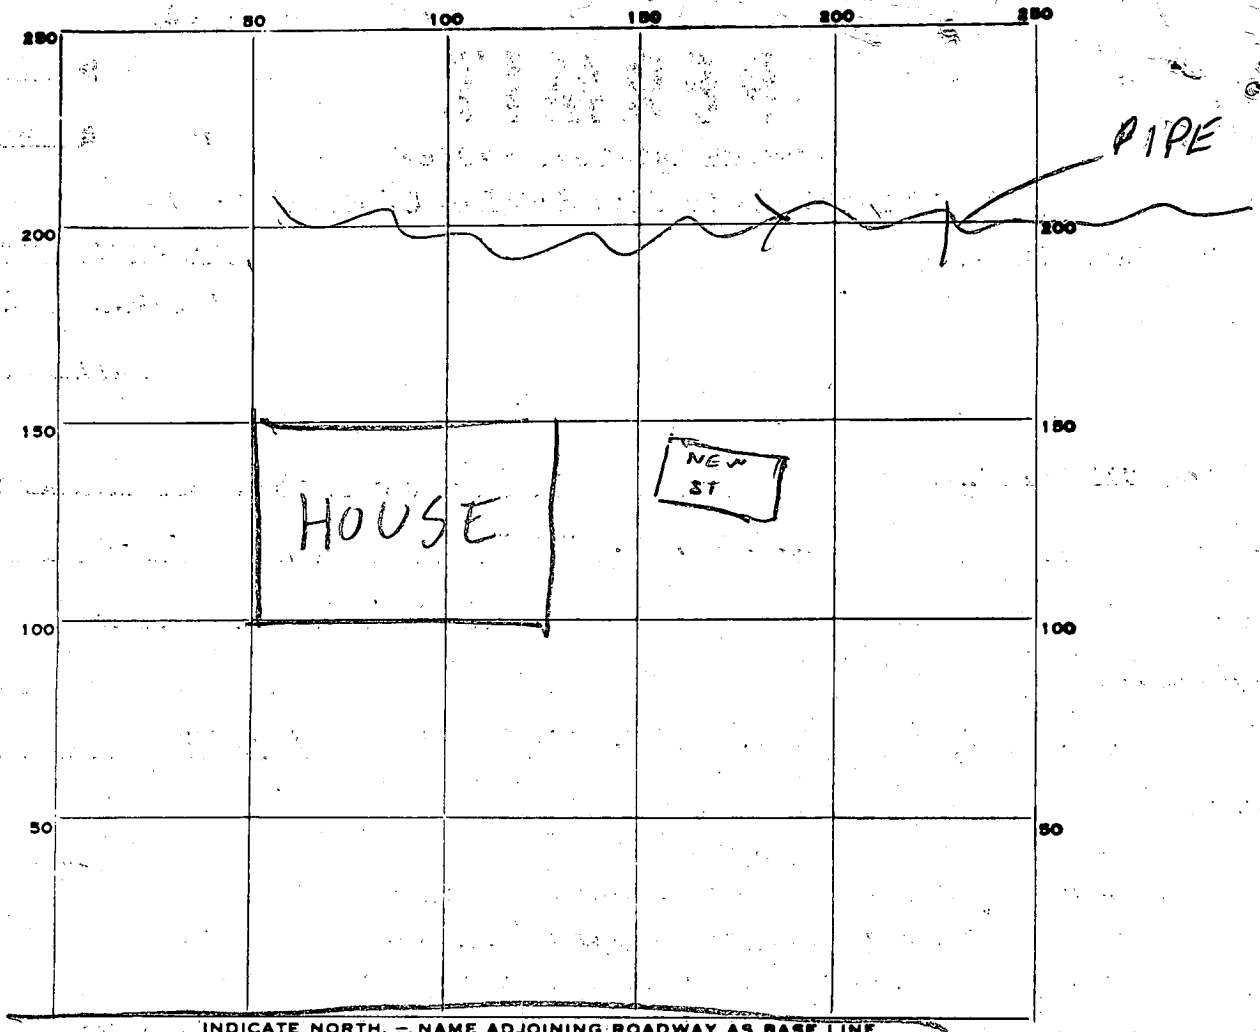

PERMIT CARD \_\_\_\_\_

SEPTIC TANK, LEVEL 10001 CLEANOUTS OK

DISTRIBUTION BOX, LEVEL \_\_\_\_\_

TILE FIELD, DEPTH \_\_\_\_\_ FT. TRENCH WIDTH \_\_\_\_\_ FT.

GRAVEL DEPTH \_\_\_\_\_ IN. TOTAL LENGTH \_\_\_\_\_ FT.

NUMBER OF TRENCHES \_\_\_\_\_ TOTAL BOTTOM AREA \_\_\_\_\_

SEEPAGE PITS, INSIDE DIAMETER \_\_\_\_\_ FT. DEPTH BELOW INLET \_\_\_\_\_ FT.

ABSORBENT AREA \_\_\_\_\_ SQ. FT.

REMARKS 4/22/80 - TANK OK BUT NOT YET HOOLED TO  
OLD DF & HOUSE .MUST SEE HOOK UP . MUST ALSO  
PUT DYE IN DB TO SEE IF THERE IS ANY OVERFLOW  
FROM PIPE IN STREAM RH  
NO RECORD OF FUTURE INSPECTION AS OF 7/17/95 (CW)  
INDEX AS NOT APPROVED

DATE SYSTEM, APPROVED NOT 4/22/80 INSPECTOR RH/CW