

5/15/80

01-172921

APPROVED
5/16/80 RH
P 30673

PERMIT

SEWAGE DISPOSAL SYSTEM

A Repair

MARYLAND STATE DEPARTMENT OF HEALTH

HOWARD COUNTY

ELLICOTT CITY

DISTRICT 1st

INDEXED

DATE 5/12/80

Mr. Paul Schissler
South Carroll Backhoe Service

IS PERMITTED TO INSTALL ALTER X

ADDRESS 7311 Brangles Road, Marriottsville, Md. 21104 PHONE 795-2642

SUBDIVISION _____ ROAD 5426 Kerger Road LOT _____

PROPERTY OWNER Mr. and Mrs. Charles E. Fischer

ADDRESS 5426 Kerger Road, Ellicott City, Md. 21043

SPECIFICATIONS

SEPTIC TANK CAPACITY _____ GALLONS

DRAIN FIELD _____ DEPTH _____ FEET, BOTTOM AREA _____ SQ. FT.

DEEP TRENCH _____ DEPTH _____ FEET, BOTTOM AREA _____ SQ. FT.

SEEPAGE PITS _____ ABSORBENT SIDE-WALL AREA _____ SQ. FT.

INLET PIPE _____ FT. BELOW ORIGINAL GRADE. MAXIMUM DEPTH _____ FT. BELOW ORIGINAL GRADE

EFFECTIVE DEPTH AT _____ FT. BELOW ORIGINAL GRADE.

LOCATE DISPOSAL AREA _____ FT. FROM _____ LOT LINE AND _____ FT. FROM _____ LOT LINE AS SEEN WHEN FACING LOT FROM

REPAIR - Call for an appointment when ground is opened up and Sanitarian will recommend the repair system.

*3 trenches - 40 ft long - 12 ft deep - 2 ft stone - dist. bed
trenches to be 14' apart center to center*

PLANS APPROVED BY Palmer F. Wine DATE 5/12/80

COVER NO WORK UNTIL INSPECTED AND APPROVED.

NEITHER THE HOWARD COUNTY COUNCIL NOR THE HEALTH DEPARTMENT IS RESPONSIBLE FOR THE SUCCESSFUL OPERATION OF ANY SYSTEM.

NOTE: IF TRENCH IS USED CALL FOR INSPECTION BEFORE PLACING GRAVEL IN TRENCH.

NOTE: NO DRY WELL SHALL EXCEED 15 FOOT IN DIAMETER.


NOTE: ALL PIPE FROM HOUSE TO DISPOSAL AREA MUST BE CAST IRON.

PERMIT VOID AFTER THREE YEARS.

NOTE: INSTALL STAND PIPE ON SEPTIC TANK AND DRY WELL. STAND PIPES MUST BE 6 INCHES IN DIAMETER. CAST IRON, CONCRETE OR TERRA COTTA ACCEPTED.

***INSTALLER IS RESPONSIBLE FOR OBTAINING FINAL APPROVAL ON THIS PERMIT.**

A.P. 30673

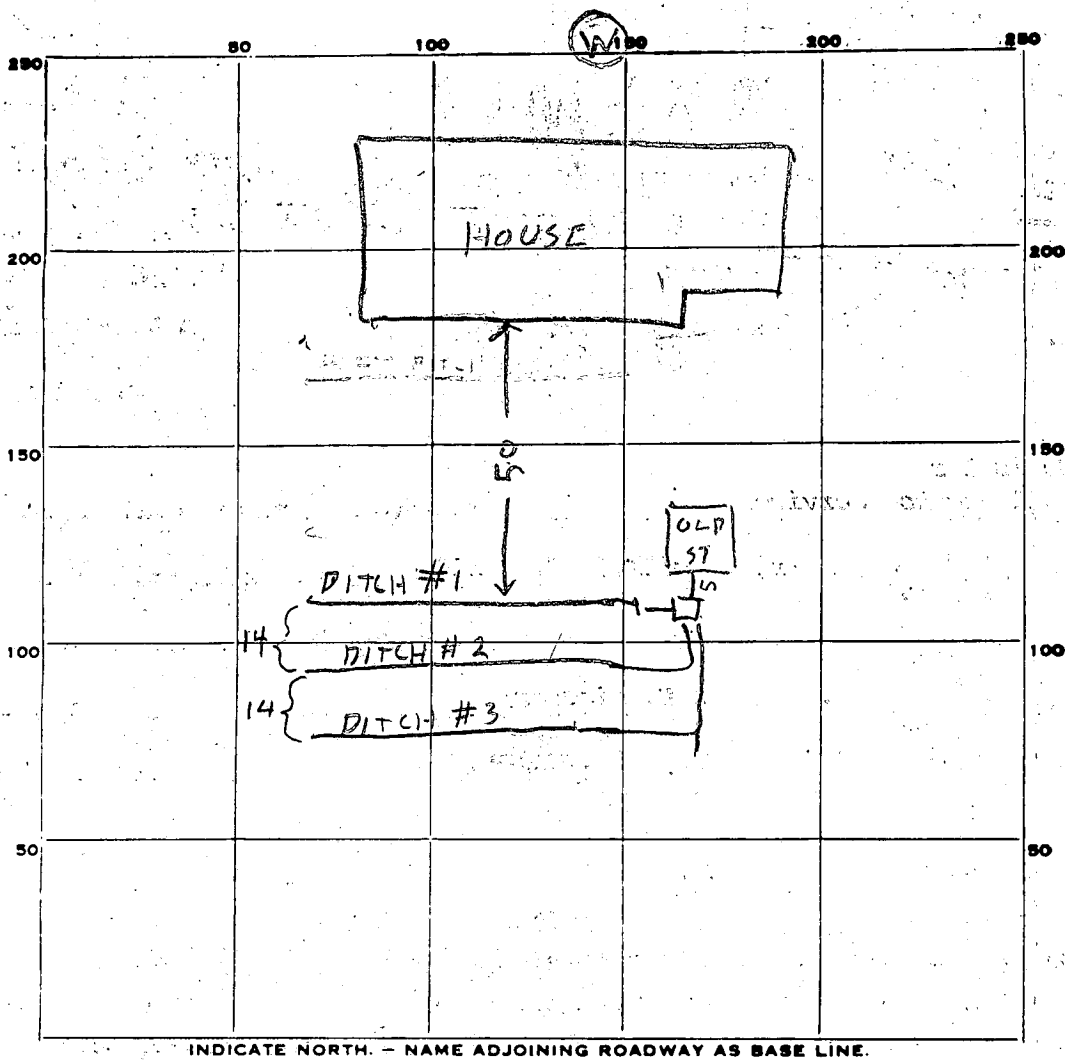

INDICATE NORTH. - NAME ADJOINING ROADWAY AS BASE LINE.

PERMIT CARD YES

SEPTIC TANK, LEVEL OLD TANK CLEANOUTS _____

DISTRIBUTION BOX, LEVEL OK

PITCH #1	12	PITCH #1	3
PITCH #2	12	PITCH #2	2
PITCH #3	12	PITCH #2	2 FT. 42 FT
PITCH #1	7 FT	PITCH #1	40 FT
PITCH #2	7 FT	PITCH #2	40 FT
GRAVEL DEPTH	3	TOTAL LENGTH	#3 41 FT.

NUMBER OF TRENCHES _____ TOTAL BOTTOM AREA _____

SEEPAGE PITS, INSIDE DIAMETER _____ FT. DEPTH BELOW INLET _____ FT.

ABSORBENT AREA _____ SQ. FT.

REMARKS 5/15/80 - DM WAS HERE EARLIER & DECIDED ON 3 DITCHES

DITCH #1 OK, ADD STONE TO DITCH #1 RH 5/15/80 400PM - DITCH #2 OK TO

ADD STONE RH 5/16/80 1030 - OK TO COVER DITCH #2 DITCH #3 25 FT

LONG & 12 FT DEEP LENGTHEN DITCH #3 TO 40 FT & ADD STONE, & FINISH JOB

FINISH JOB & CALL. 5/16/80 - 340PM DITCH #3 LENGTHENED & STONE ADDED

JOB FINISHED RH

DATE SYSTEM APPROVED 5/16/80

INSPECTOR Raymond Hodges