

~~8/21/80~~  
~~8/20/80~~

8/21/80 possible  
a.m. if

Approved 8/21/80  
Stage

# PERMIT

P 30699  
A Repair

SEWAGE DISPOSAL SYSTEM  
MARYLAND STATE DEPARTMENT OF HEALTH

HOWARD COUNTY

04-309944

INDEXED

ELLICOTT CITY

DISTRICT 4th

DATE 5/23/80

~~William Wright~~

Paul Schuster

IS PERMITTED TO INSTALL ALTER X

ADDRESS 11551 Homewood Road, Ellicott City, Md. 21043 PHONE 730-6395

SUBDIVISION \_\_\_\_\_ ROAD 713 Long Corner Road LOT \_\_\_\_\_

PROPERTY OWNER Robert G. Blackford

ADDRESS 713 Long Corner Road, Mt. Airy, Md.

SPECIFICATIONS

SEPTIC TANK CAPACITY \_\_\_\_\_ GALLONS  
DRAIN FIELD \_\_\_\_\_ DEPTH \_\_\_\_\_ FEET, BOTTOM AREA \_\_\_\_\_ SQ. FT.  
DEEP TRENCH \_\_\_\_\_ DEPTH \_\_\_\_\_ FEET, BOTTOM AREA \_\_\_\_\_ SQ. FT.  
SEEPAGE PITS \_\_\_\_\_ ABSORBENT SIDE-WALL AREA \_\_\_\_\_ SQ. FT.  
INLET PIPE \_\_\_\_\_ FT. BELOW ORIGINAL GRADE. MAXIMUM DEPTH \_\_\_\_\_ FT. BELOW ORIGINAL GRADE  
EFFECTIVE DEPTH AT \_\_\_\_\_ FT. BELOW ORIGINAL GRADE.  
LOCATE DISPOSAL AREA \_\_\_\_\_ FT. FROM \_\_\_\_\_ LOT LINE AND \_\_\_\_\_ FT. FROM \_\_\_\_\_ LOT LINE AS SEEN WHEN  
FACING LOT FROM

Jim May 829-1720  
Paul Schuster


**REPAIR - Trench if one more bedroom added to be 20 ft. long and if two bedrooms added 40 ft. long. 125 sq. ft. per bedroom; inlet at 4 ft. and maximum depth 12 ft. below original grade, with 8 ft. of stone under pipe. CALL FOR INSPECTION OF TRENCH BEFORE PLACING ANY STONE IN TRENCH.**

PLANS APPROVED BY Donald W. Monaghan DATE 5/23/80

- COVER NO WORK UNTIL INSPECTED AND APPROVED.
- NEITHER THE HOWARD COUNTY COUNCIL NOR THE HEALTH DEPARTMENT IS RESPONSIBLE FOR THE SUCCESSFUL OPERATION OF ANY SYSTEM.
- NOTE: IF TRENCH IS USED CALL FOR INSPECTION BEFORE PLACING GRAVEL IN TRENCH.
- NOTE: NO DRY WELL SHALL EXCEED 15 FOOT IN DIAMETER.
- NOTE: ALL PIPE FROM HOUSE TO DISPOSAL AREA MUST BE CAST IRON.
- PERMIT VOID AFTER THREE YEARS.
- NOTE: INSTALL STAND PIPE ON SEPTIC TANK AND DRY WELL. STAND PIPES MUST BE 6 INCHES IN DIAMETER. CAST IRON, CONCRETE OR TERRA COTTA ACCEPTED.

**\*INSTALLER IS RESPONSIBLE FOR OBTAINING FINAL APPROVAL ON THIS PERMIT.**

P  
30699

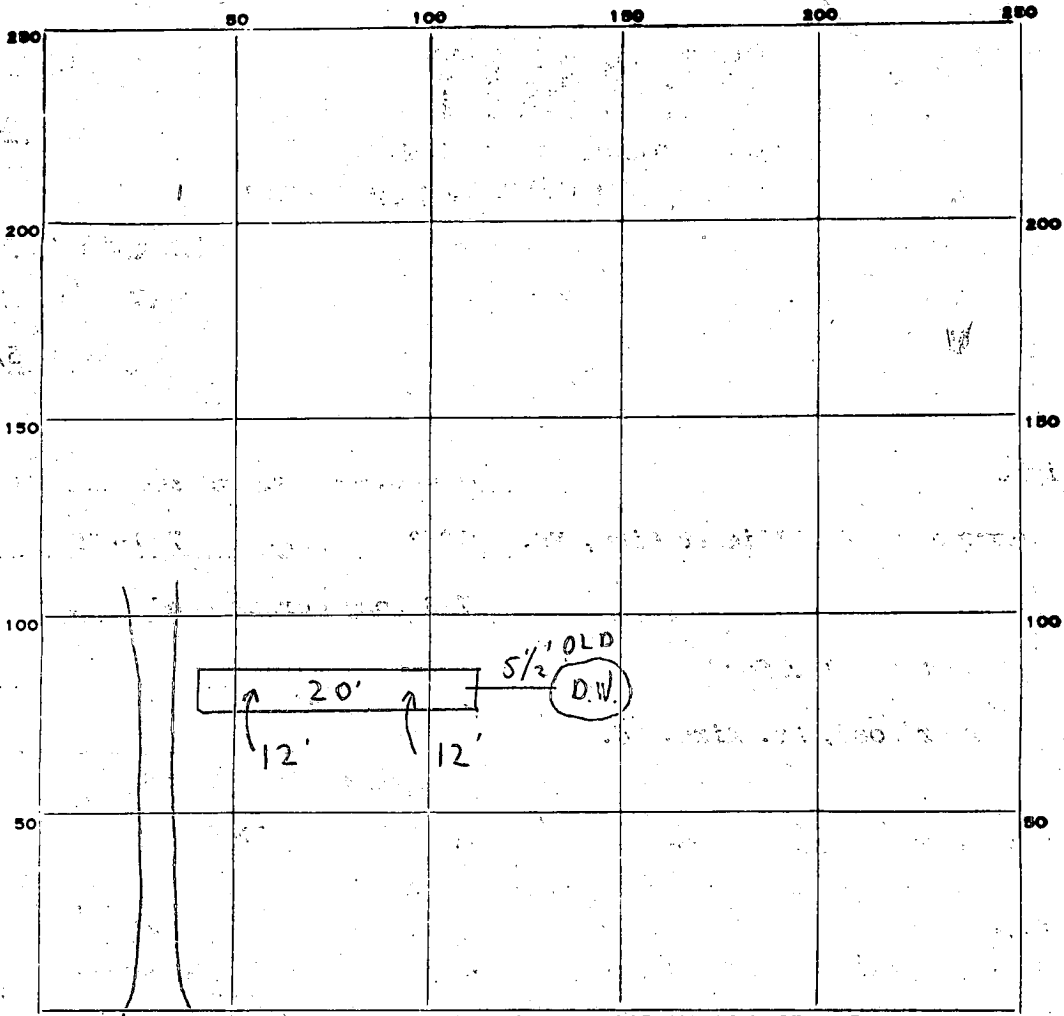

INDICATE NORTH. — NAME ADJOINING ROADWAY AS BASE LINE.

LONG CORNER ROAD

PERMIT CARD

SEPTIC TANK, LEVEL \_\_\_\_\_ CLEANOUTS \_\_\_\_\_

DISTRIBUTION BOX, LEVEL \_\_\_\_\_

TILE FIELD, DEPTH 12 FT. TRENCH WIDTH 2 FT.

GRAVEL DEPTH 8 1/2 IN. TOTAL LENGTH 20 FT.

NUMBER OF TRENCHES 1 TOTAL BOTTOM AREA 160

SEEPAGE PITS, INSIDE DIAMETER \_\_\_\_\_ FT. DEPTH BELOW INLET \_\_\_\_\_ FT.

ABSORBENT AREA 160 SQ. FT.

REMARKS 8/20/80 CHECKED TRENCH - OK FOR STONE.

8/21/80 OK to cover work JS C.B.S.

DATE SYSTEM APPROVED 8/21/80 INSPECTOR [Signature]



SCALE: 1" = 100'

# LONG CORNER ROAD


1200' TO SW  
SIDE RTE. 144

(30' WIDE)

Part of 4<sup>th</sup> Line - W.H.H. 375-626

Bag. W.H.H. 384-337  
@ End of 3<sup>rd</sup> of  
N 55° 54' W - 491.26' Line -  
W.H.H. 375-626 &  
Bag. C.M.P. 636-226

144.67'  
1<sup>st</sup> Line  
C.M.P. 636-226  
W.H.H. 384-337

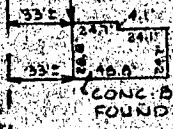

4<sup>th</sup> Line  
W.H.H. 375-626  
N 55° 54' W - 491.26'

C 4<sup>th</sup> Line  
C.M.P. 636-226  
W.H.H. 384-337

3<sup>rd</sup> Line  
C.M.P. 636-226  
W.H.H. 384-337

2<sup>nd</sup> Line  
S 56° 25' E - 506.10'

300.62' to  
Bag. 2<sup>nd</sup> Line - W.H.H. 375-626

151.16'

S 37° 37' W  
Part of 2<sup>nd</sup> Line  
W.H.H. 375-626

This is to certify that I have surveyed the property known as PROPERTY OF ROBERT G. BLACKFORD & KATHRYN A. BLACKFORD, WIFE - S.E. SIDE OF LONG CORNER ROAD - 4<sup>th</sup> ELECTION DISTRICT - HOWARD COUNTY, MARYLAND for the purpose of locating the improvements thereon, and the improvements are located as shown.

Signed this 7<sup>TH</sup> day of NOVEMBER 1973