

PERMIT

SEWAGE DISPOSAL SYSTEM

MARYLAND STATE DEPARTMENT OF HEALTH

HOWARD COUNTY

ELLICOTT CITY

DISTRICT _____

DATE 9/23/80

INDEXED

APPROVED
4/6/81 RH
P 30947

A REPAIR

4/6/81
10-62 please

Otis Ketterman

IS PERMITTED TO INSTALL ALTER X

ADDRESS 4647 Manor Lane, Ellicott City, Maryland 21043 PHONE 992-0062

SUBDIVISION _____ ROAD 8272 Lark Brown Road LOT _____

PROPERTY OWNER Kenneth C. Wood - Royal Crowning Ent, Inc.

ADDRESS 8272 Lark Brown Road

SPECIFICATIONS

SEPTIC TANK CAPACITY _____ GALLONS

DRAIN FIELD _____ DEPTH _____ FEET, BOTTOM AREA _____ SQ. FT.

DEEP TRENCH _____ DEPTH _____ FEET, BOTTOM AREA _____ SQ. FT.

SEEPAGE PITS _____ ABSORBENT SIDE-WALL AREA _____ SQ. FT.

INLET PIPE _____ FT. BELOW ORIGINAL GRADE, MAXIMUM DEPTH _____ FT. BELOW ORIGINAL GRADE

EFFECTIVE DEPTH AT _____ FT. BELOW ORIGINAL GRADE.

LOCATE DISPOSAL AREA _____ FT. FROM _____ LOT LINE AND _____ FT. FROM _____ LOT LINE AS SEEN WHEN FACING LOT FROM

REPAIR - CALL FOR INSPECTION WHEN GROUND IS OPENED UP SO SANITARIAN CAN RECOMMEND

REPAIR. 12/18/80 O.K. to install 2 each 1000 gallon metal sealed tanks in series with alarm device - buzzer or light alarm o.k. F.S.S.
OK TO PUT 2000 GAL TANK INSTEAD

PLANS APPROVED BY Palmer F. Wine DATE 9/23/80

COVER NO WORK UNTIL INSPECTED AND APPROVED.

NEITHER THE HOWARD COUNTY COUNCIL NOR THE HEALTH DEPARTMENT IS RESPONSIBLE FOR THE SUCCESSFUL OPERATION OF ANY SYSTEM.

NOTE: IF TRENCH IS USED CALL FOR INSPECTION BEFORE PLACING GRAVEL IN TRENCH.

NOTE: NO DRY WELL SHALL EXCEED 15 FOOT IN DIAMETER.

NOTE: ALL PIPE FROM HOUSE TO DISPOSAL AREA MUST BE CAST IRON.


PERMIT VOID AFTER THREE YEARS.

NOTE: INSTALL STAND PIPE ON SEPTIC TANK AND DRY WELL. STAND PIPES MUST BE 6 INCHES IN DIAMETER. CAST IRON, CONCRETE OR TERRA COTTA ACCEPTED.

*INSTALLER IS RESPONSIBLE FOR OBTAINING FINAL APPROVAL ON THIS PERMIT.

BLDG. PERMIT SIGNED
AND RETURNED 12/2/81
Sud # 42896
Pro-Bair

30947

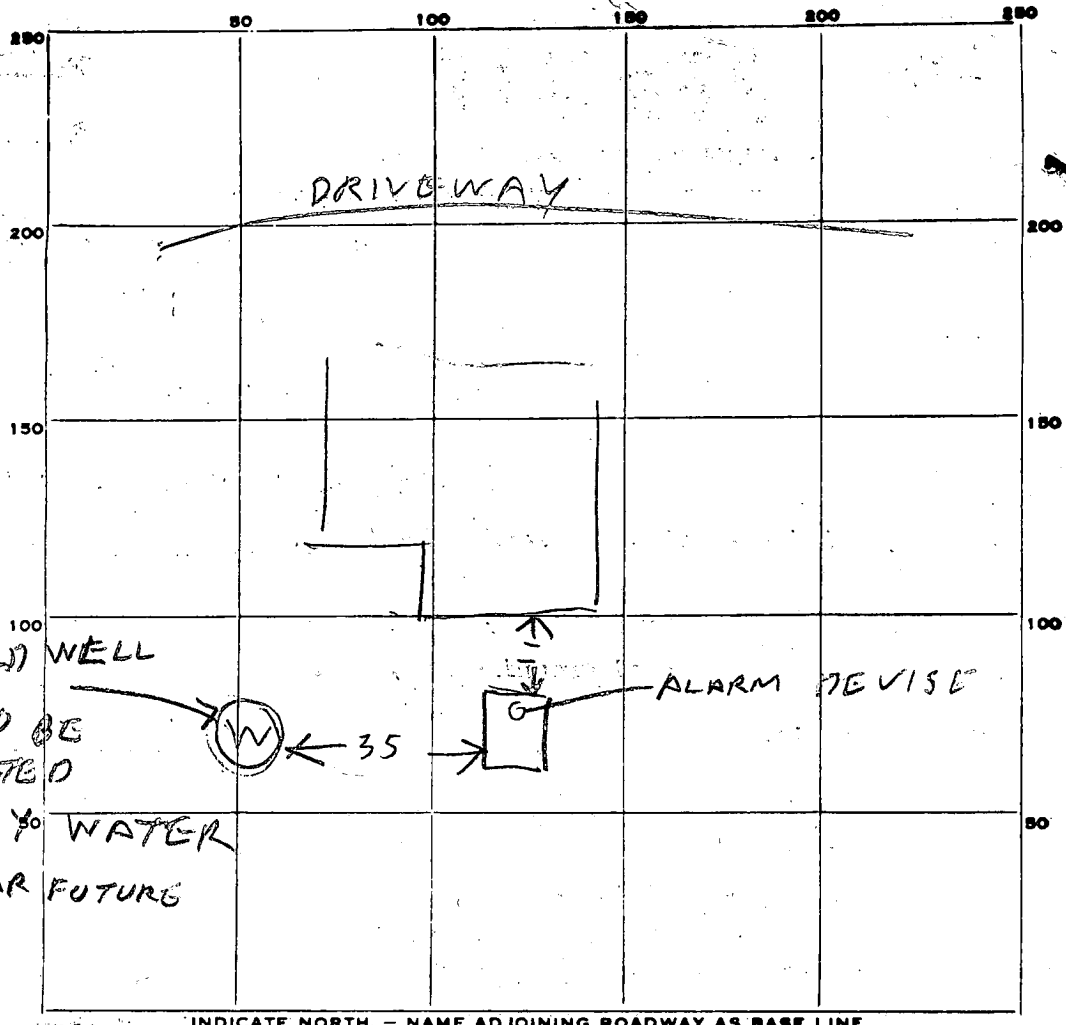

INDICATE NORTH. - NAME ADJOINING ROADWAY AS BASE LINE.

PERMIT CARD _____

SEPTIC TANK, LEVEL 2000

CLEANOUTS _____

DISTRIBUTION BOX, LEVEL _____

TILE FIELD, DEPTH _____ FT. TRENCH WIDTH _____ FT.

GRAVEL DEPTH _____ IN. TOTAL LENGTH _____ FT.

NUMBER OF TRENCHES _____ TOTAL BOTTOM AREA _____

SEEPAGE PITS, INSIDE DIAMETER _____ FT. DEPTH BELOW INLET _____ FT.

ABSORBENT AREA _____ SQ. FT.

REMARKS _____

DATE SYSTEM APPROVED 4/6/81

INSPECTOR Raymond Hooper

OPEN LAND

OPEN LAND
FALL OF LAND

LOCATION OF BARN

SEPTIC ETC

WELL

COTTAGE

3.15 A.

OWNER
KENNETH E. WOOD
P.O. BOX 538
COLUMBIA, MD.

200'

WARREN

8272 LARK BROWN RD

LARK BROWN RD

EC.
↑

RT 108

SIKES OR SOLOMON TENANT

799 4287

4/9/80 - SEPTIC SYSTEM OVERFLOWING IN APPROXIMATE
LOCATION SHOWN IN DRAWING
BARN ALREADY HALF FINISHED