

PERMIT

SEWAGE DISPOSAL SYSTEM

MARYLAND STATE DEPARTMENT OF HEALTH

HOWARD COUNTY

ELLICOTT CITY

DISTRICT 6th

DATE 6/27/77

P 26219

A 26054

INDEX

Columbia Park & Recreations IS PERMITTED TO INSTALL ALTER
5829 Banneker Road, Columbia, Md.
ADDRESS Lambskin Lane, Columbia, Md. PHONE 730-7000

A SEWAGE DISPOSAL SYSTEM LOCATED AT _____

SUBDIVISION _____ ROAD Lambskin Lane LOT _____

PROPERTY OWNER Columbia Park & Recreations

ADDRESS same as above

SPECIFICATIONS

Trench 120' x 2' x 10' sidewall
DRAIN FIELD _____ DEPTH _____ FEET, BOTTOM AREA 720 SQ. FT.

SEEPAGE PITS _____ ABSORBENT SIDE-WALL AREA _____ SQ. FT.

SEPTIC TANK CAPACITY more GALLONS

FOR GARBAGE GRINDER, INCREASE DISPOSAL AREA 22% & TANK CAPACITY 50%.


OTHER _____

PLANS APPROVED BY R Moorefield DATE 27 June 77

FILL SEPTIC TANK AND DISTRIBUTION BOX WITH WATER BEFORE CALLING FOR AN INSPECTION. COVER NO WORK UNTIL INSPECTED AND APPROVED.

NEITHER THE HOWARD COUNTY COMMISSIONERS NOR THE HEALTH DEPARTMENT IS RESPONSIBLE FOR THE SUCCESSFUL OPERATION OF ANY SYSTEM.

A
26054

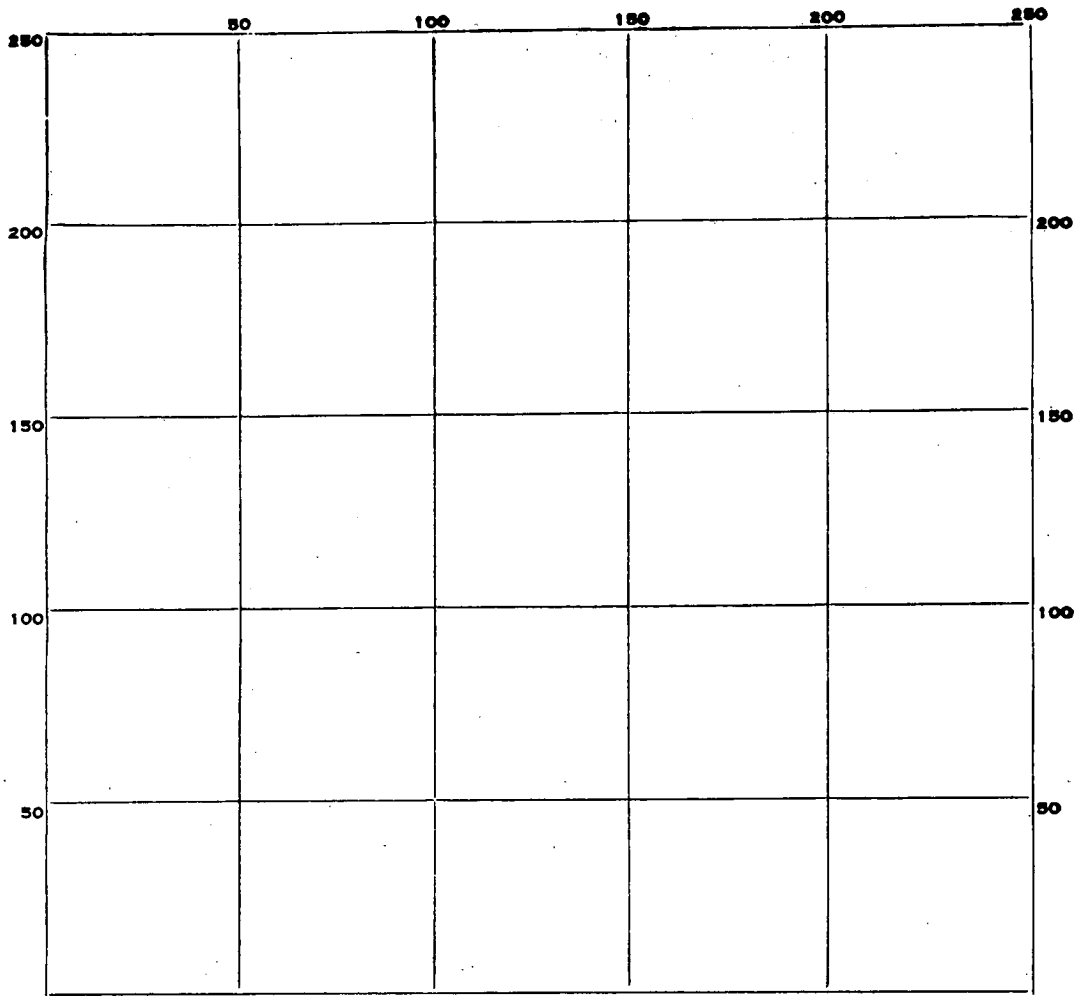

INDICATE NORTH. - NAME ADJOINING ROADWAY AS BASE LINE.

PERMIT CARD _____

SEPTIC TANK, LEVEL _____

CLEANOUTS _____

DISTRIBUTION BOX, LEVEL _____

TILE FIELD, DEPTH _____ FT. TRENCH WIDTH _____ FT.

GRAVEL DEPTH _____ IN. TOTAL LENGTH _____ FT.

NUMBER OF TRENCHES _____ TOTAL BOTTOM AREA _____

SEEPAGE PITS, INSIDE DIAMETER _____ FT. DEPTH BELOW INLET _____ FT.

ABSORBENT AREA _____ SQ. FT.

REMARKS _____

DATE SYSTEM APPROVED _____ INSPECTOR _____

APPLICATION

A 26054

6/27/77
1:30 PM

SEWAGE DISPOSAL TESTING

P _____

STATE OF MARYLAND - DEPARTMENT OF HEALTH AND MENTAL HYGIENE

HOWARD COUNTY HEALTH DEPARTMENT
ENVIRONMENTAL HEALTH SERVICES
P. O. BOX 476, ELLICOTT CITY, MARYLAND 21043
TELEPHONE: 465-5000, EXT. 356

DISTRICT 6th

DATE 6/9/77

TO: THE COUNTY HEALTH OFFICER
ELLICOTT CITY, MARYLAND

I, HEREBY, APPLY FOR THE NECESSARY TEST IN ORDER TO CONSTRUCT (OR RECONSTRUCT) A SEWAGE DISPOSAL SYSTEM.

PROPERTY OWNER Columbia Park and Receptions

ADDRESS Lambskin Lane, Columbia, Md. PHONE 730-7000

PROPERTY LOCATION: 5829 Banneker Road, Columbia, Md.

SUBDIVISION _____ LOT NO. _____

ROAD AND DESCRIPTION Lambskin Lane - Locust Park Neighborhood Pool

SIZE OF LOT ? TYPE BLDG. Backwash water from the pool
NUMBER OF BEDROOMS _____

IF NOT SINGLE RESIDENCE DESCRIBE _____

THE SYSTEM INSTALLED UNDER THIS APPLICATION IS ACCEPTABLE ONLY UNTIL PUBLIC FACILITIES BECOME AVAILABLE.

SIGNATURE OF APPLICANT W. Scott Custer


APPROVED BY R. Monfield FOR Trench DATE 27 June 77
(KIND OF SYSTEM)

REJECTED BY _____ FOR _____ DATE _____
(KIND OF SYSTEM)

HOLD PENDING FURTHER TESTS _____ DATE _____

REASONS FOR REJECTION OR HOLDING _____

THIS IS NOT A PERMIT

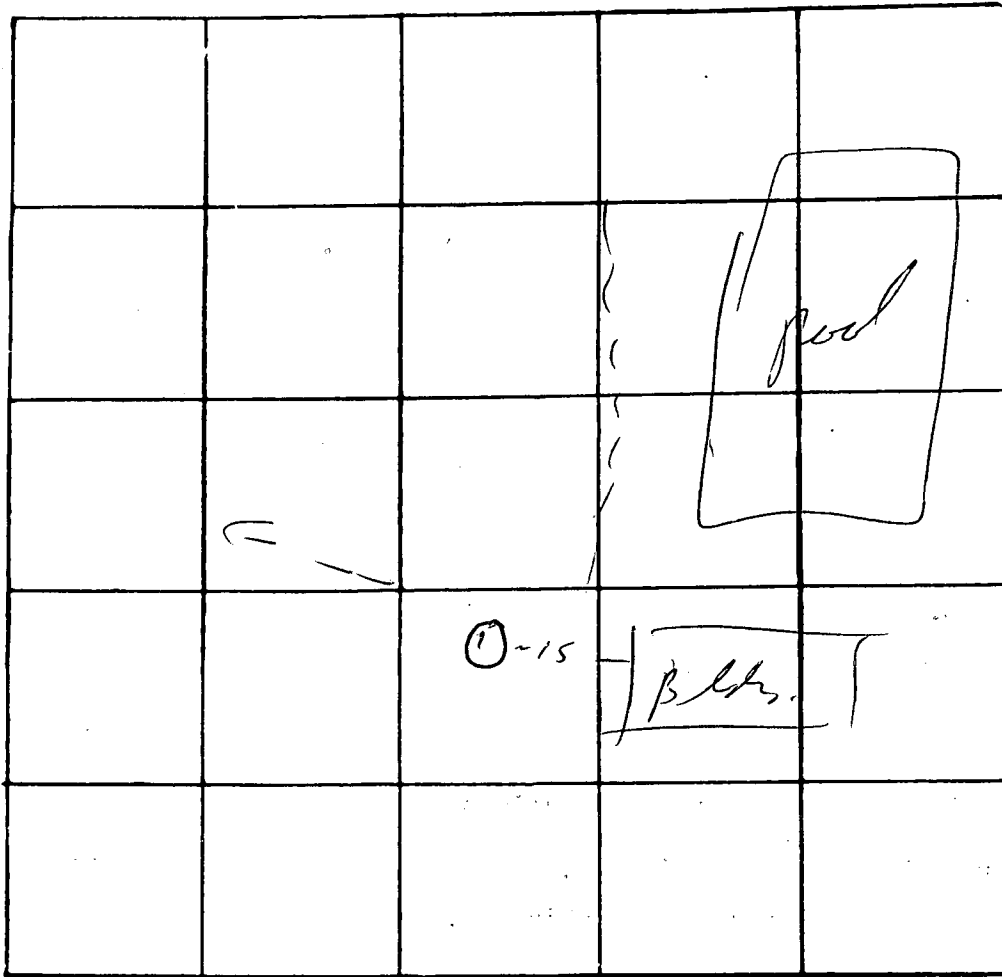

INDICATE NORTH. - NAME ADJOINING ROADWAY AS BASE LINE

DATE	TEST NO.	DEPTH	PRE-WET		TEST - 1" DROP		TIME
			START	STOP	START	STOP	
	1	13	1 ⁴⁹	1 ⁵⁵	1 ⁵⁵	2 ⁰⁷	12
	1A	13	1 ⁵⁸	2 ⁰⁴	2 ⁰⁴	2 ¹⁵	12

REMARKS _____

TYPE OF SOIL _____

TESTED BY M ALSO PRESENT: _____