

11/20/84

300  
water test of  
house connection

11/20/84 App'd F.S.

# PERMIT

05-387353

P 31926

A 2229

SEWAGE DISPOSAL SYSTEM

MARYLAND STATE DEPARTMENT OF HEALTH

HOWARD COUNTY

ELLICOTT CITY

DISTRICT 5th

DATE 5/13/82

5/20/82  
a.m. please

5/21/82  
study around

2:00 p.m.  
5/24/82

INDEXED

Soloman Construction Co. IS PERMITTED TO INSTALL X ALTER

ADDRESS 1038 North Randolph, Arlington, VA. 22201 PHONE 525-1410

SUBDIVISION Ley Property ROAD 12536 Lime Kilm Rd. LOT 5

PROPERTY OWNER Robin Ley Property/ Warren C. Edmunds

ADDRESS 1038 M. Randolph St., Arlington, VA 22201

SPECIFICATIONS 3 Bedrooms garbage grinder  
SEPTIC TANK CAPACITY 1500 GALLONS

DRAIN FIELD \_\_\_\_\_ DEPTH \_\_\_\_\_ FEET, BOTTOM AREA \_\_\_\_\_ SQ. FT.

DEEP TRENCH \_\_\_\_\_ DEPTH \_\_\_\_\_ FEET, BOTTOM AREA \_\_\_\_\_ SQ. FT.

SEEPAGE PITS \_\_\_\_\_ ABSORBENT SIDE-WALL AREA 195 SQ. FT. per bedroom

INLET PIPE 4 FT. BELOW ORIGINAL GRADE. MAXIMUM DEPTH 10 FT. BELOW ORIGINAL GRADE

EFFECTIVE DEPTH AT \_\_\_\_\_ FT. BELOW ORIGINAL GRADE.

LOCATE DISPOSAL AREA 220 FT. FROM left LOT LINE AND 150 FT. FROM back LOT LINE AS SEEN WHEN

FACING LOT FROM Lime Kilm Rd.

Trench to follow contour of land and run toward left property line as seen from Lime

Kilm Rd. 3 Bedroom with garbage grinder. O.K. to use 100 ft. long trench 10' deep, inlet 4'

195  
3  
585

PLANS APPROVED BY Jim Stayer DATE 1/8/79

COVER NO WORK UNTIL INSPECTED AND APPROVED.

NEITHER THE HOWARD COUNTY COUNCIL NOR THE HEALTH DEPARTMENT IS RESPONSIBLE FOR THE SUCCESSFUL OPERATION OF ANY SYSTEM.

NOTE: IF TRENCH IS USED CALL FOR INSPECTION BEFORE PLACING GRAVEL IN TRENCH.

NOTE: NO DRY WELL SHALL EXCEED 15 FOOT IN DIAMETER.

NOTE: ALL PIPE FROM HOUSE TO DISPOSAL AREA MUST BE CAST IRON.

PERMIT VOID AFTER THREE YEARS.


NOTE: INSTALL STAND PIPE ON SEPTIC TANK AND DRY WELL. STAND PIPES MUST BE 6 INCHES IN DIAMETER. CAST IRON, CONCRETE OR TERRA COTTA ACCEPTED.

BLDG. PERMIT SIGNED  
AND RETURNED on 6/4/82  
#49758 for S.F.D.  
3/28/84 care. per B.L.I.P.

\*INSTALLER IS RESPONSIBLE FOR OBTAINING FINAL APPROVAL ON THIS PERMIT.

BLDG. PERMIT SIGNED  
AND RETURNED 3/28/84  
Serial # 58183 S.F.D.

A 28229

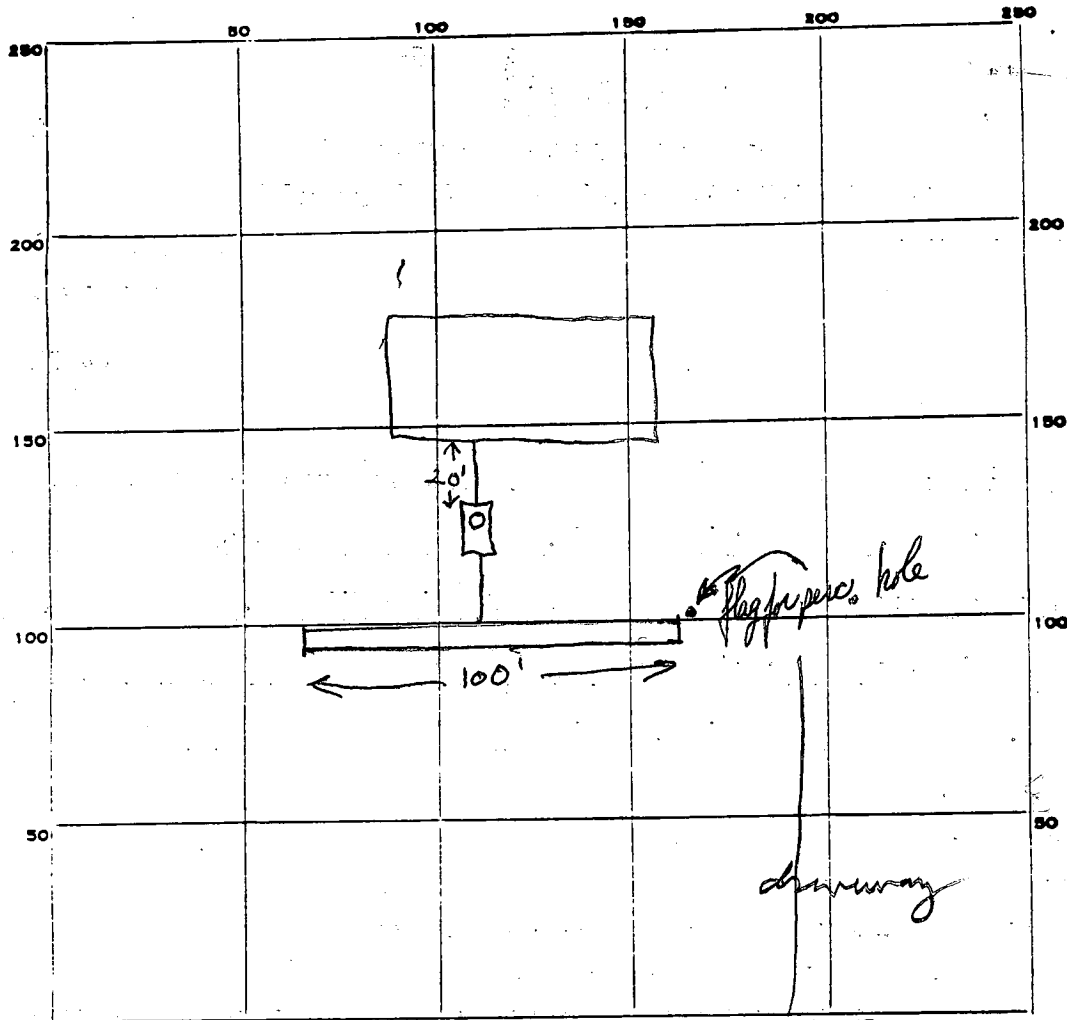

INDICATE NORTH. - NAME ADJOINING ROADWAY AS BASE LINE.

*Luna Keln Rd*

PERMIT CARD

SEPTIC TANK, LEVEL

CLEANOUTS 5T

DISTRIBUTION BOX, LEVEL N/A

manhole

TILE FIELD, DEPTH 10 FT. TRENCH WIDTH 2 FT.

GRAVEL DEPTH 6 IN. TOTAL LENGTH 100 FT.

NUMBER OF TRENCHES 1 TOTAL BOTTOM AREA 600

SEEPAGE PITS, INSIDE DIAMETER \_\_\_\_\_ FT. DEPTH BELOW INLET \_\_\_\_\_ FT.

ABSORBENT AREA 600 SQ. FT.

REMARKS 5/20/82 OK to add stone in trench. JTCW  
5-21-82, OK to cover trench & outlet end of tank, call when cleanout & vent  
pipe installed J.F.  
11/20/84 Water test done from house to septic OK  
Final OK JF + CW

DATE SYSTEM APPROVED 11/20/84

INSPECTOR J. Shini

5 systems first.

5 stages 316,179

LGT NUMBER # 5 Robin Ley

Absorbant Area/bedroom 195

SEPTIC TANK ~~1250 gal~~ 1500 gal  
3 bdrms 4 bdrms 5 bdrms  
~~228~~ garbage grinder

DRY WELL 4  
inlet 10  
Max. depth

Abs. Area

Located 220' from left property line & 150' from back property line as seen from Lurie Kuhn Rd.

<input checked="" type="checkbox"/> TRENCH	<u>4</u> Inlet	<u>10</u> Max. depth	# bedrooms	Length	Abs. Area
			<u>3</u>	<u>35</u>	<u>210</u>
			<u>4</u>	<u>60</u>	<u>240</u>

Trench to follow contour of land and run toward left property line as seen from Lurie Kuhn Rd.

- If dry well and trench are used leave a 5' earth buffer between them.
- If septic tank is 3' or more below grade, use manhole type cleanout to grade.
- If more than one trench is used space them parallel, twice their depth apart.
- Call office for inspection of trench before placing stone in trench & after stone added
- All pipe from house to disposal area cast iron.
- Install standpipe (6" min.) on septic tank and dry well. Cast iron, concrete, terra cotta ok. Trench distribution lines may be clay, asbestos cement, orangburg type, open joint cast iron or heavy duty plastic. (Commercial standard Cs228-61).

3 B.R. with Garbage Grinder O.K to use 100 ft long trench 10' deep inlet

# APPLICATION

A 29229

SEWAGE DISPOSAL TESTING

STATE OF MARYLAND - DEPARTMENT OF HEALTH AND MENTAL HYGIENE

P \_\_\_\_\_

HOWARD COUNTY HEALTH DEPARTMENT  
ENVIRONMENTAL HEALTH SERVICES

System first

P.O. BOX 476 ELLICOTT, MARYLAND 21043  
TELEPHONE: 992-2330

Septic Tank { 3 bedroom 1000 gal  
4 bedroom 1250 gal

DISTRICT 5th

DATE 11/15/78

BLDG. PERMIT SIGNED  
AND RETURNED 3/9/81  
Sheet # 43472  
20' x 20' trap sheet

TO: THE COUNTY HEALTH OFFICER  
ELLICOTT CITY, MARYLAND

I, HEREBY, APPLY FOR THE NECESSARY TEST IN ORDER TO CONSTRUCT (OR RECONSTRUCT) A SEWAGE DISPOSAL SYSTEM.

PROPERTY OWNER Robin Ley Agent: James Moxley 465-4242

ADDRESS \_\_\_\_\_ PHONE \_\_\_\_\_

PROPERTY LOCATION:

SUBDIVISION Ley Property LOT NO. 5

ROAD AND DESCRIPTION Lime Kiln Road

SIZE OF LOT \_\_\_\_\_ TYPE BLDG. (3) or 4 bedrooms

THE SYSTEM INSTALLED UNDER THIS APPLICATION IS ACCEPTABLE ONLY UNTIL PUBLIC FACILITIES BECOME AVAILABLE.

I FULLY UNDERSTAND THE FEE CONNECTED WITH THE FILING OF THIS PERC TEST APPLICATION IS NON-REFUNDABLE UNDER

ANY CIRCUMSTANCES.

SIGNATURE OF APPLICANT /s/ James Moxley, Security Enterprises

APPROVED BY J. Stayer FOR depth of trench DATE 1/8/79

REJECTED BY \_\_\_\_\_ FOR \_\_\_\_\_ DATE \_\_\_\_\_

HOLD PENDING FURTHER TESTS Dig more holes DATE 12/26/78

REASONS FOR REJECTION OR HOLDING Mr. Monaghan says there are not funds for  
perc test to use as high holes for 12/29

# THIS IS NOT A PERMIT

LOT 5

SOIL PROFILE

① ② ③ ④ ⑤


0 - 5 FT  
CLAY, SAND

5 - 13 FT  
SAND, CLAY  
SLATE ROCK

④

0 - 4 FT  
CLAY, SAND

5 - 10 FT  
CLAY, SAND  
SLATE ROCK

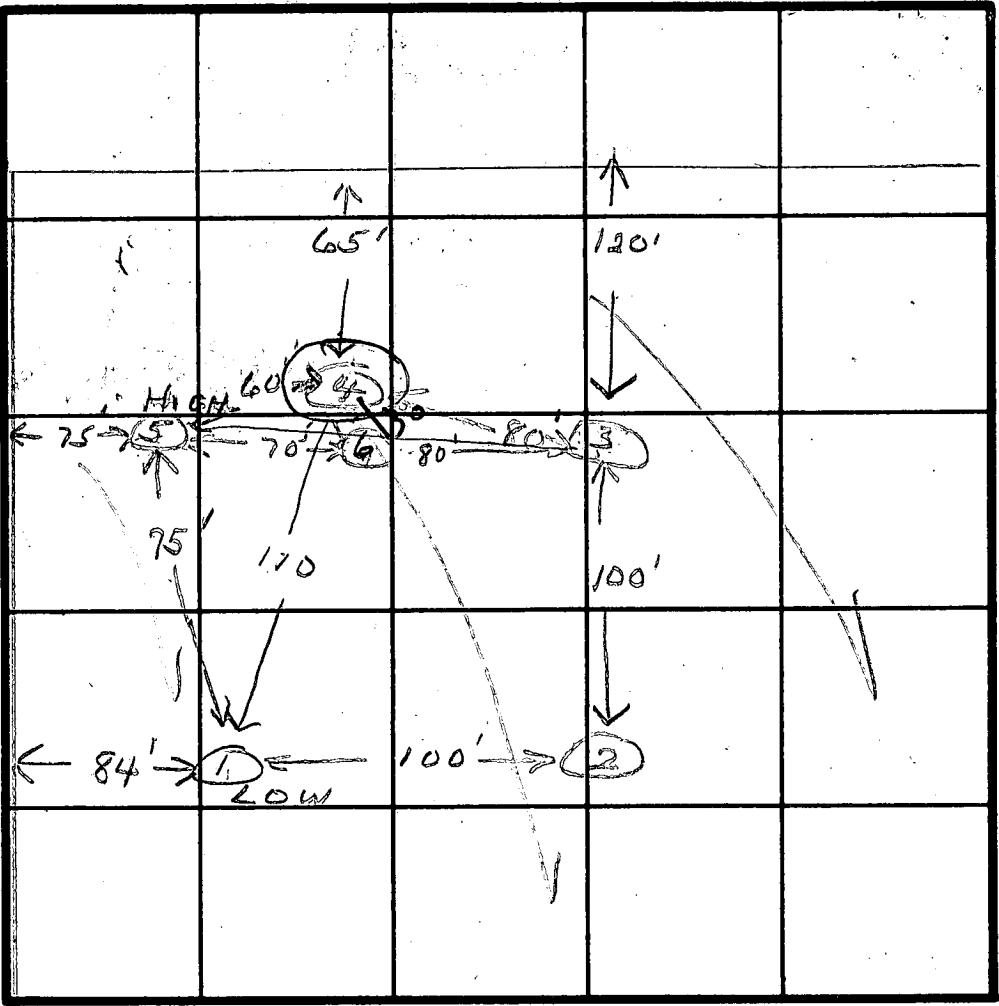

13 mm avg  
156-

INDICATE NORTH - NAME ADJOINING ROADWAY AS BASE LINE.  
LINE HIGH RD


DATE	TEST NO.	DEPTH	PRE-WET		TEST - 1" DROP		TIME
			START	STOP	START	STOP	
12/26/78	1 S	3	10:25	10:25 - FAILED	10:25	10:25	
	1 D	13	10:26	10:29	10:29	10:50	21
	2 S	4	10:48	10:56	10:56	11:02	6
	2 S	13	10:48	11:04	11:04	11:16	12
	3	12	VISUAL				
	4	10	Heavy slate rock				
	5 S	4	12:05	12:04	12:04	12:09	5
	5 S	13	12:05	12:10	12:10	12:21	11
	1 M	4	12:06	12:20	12:20	12:42	22
	1/5/79	6	12	VISUAL			


REMARKS Lot 1M WOODS - Both 3 & 5 holes are the same elevation

TYPE OF SOIL \_\_\_\_\_

TESTED BY *JM*

ALSO PRESENT *J. Moylan*

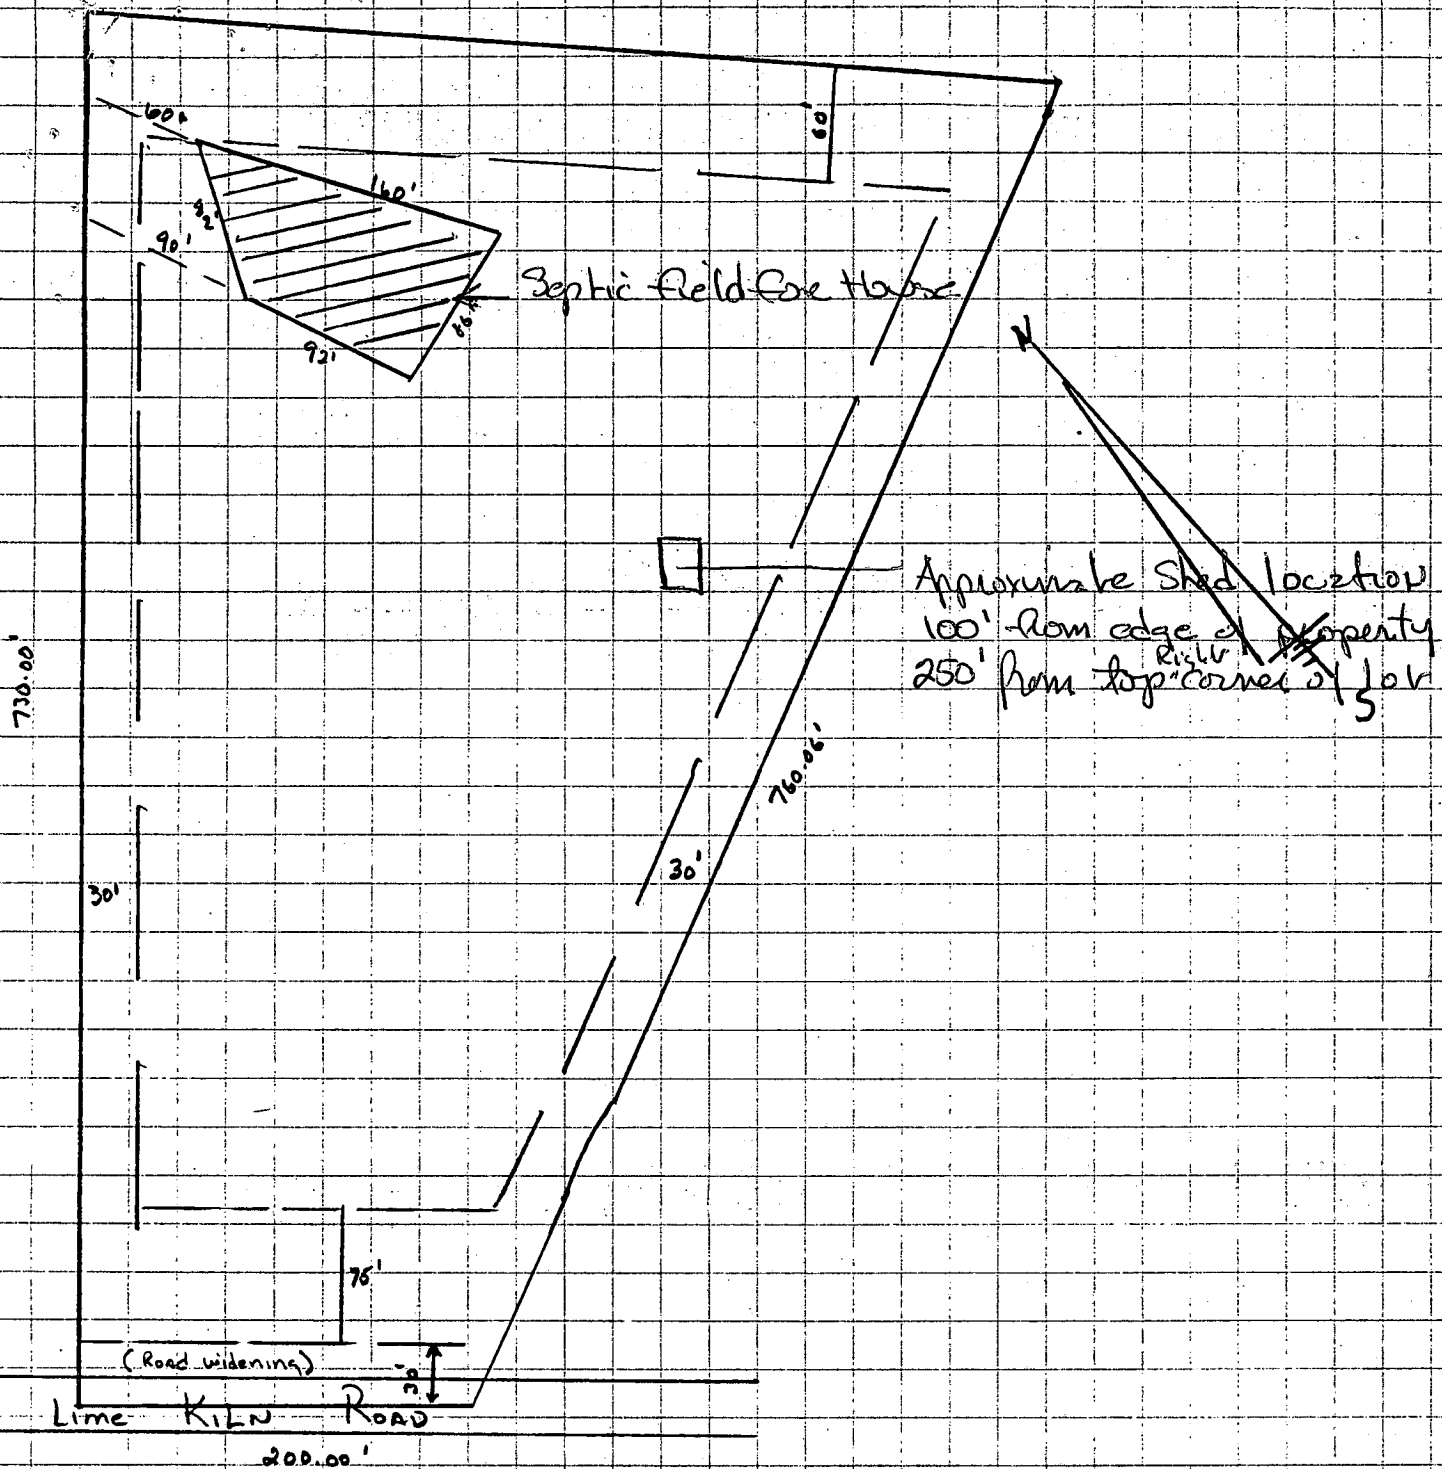

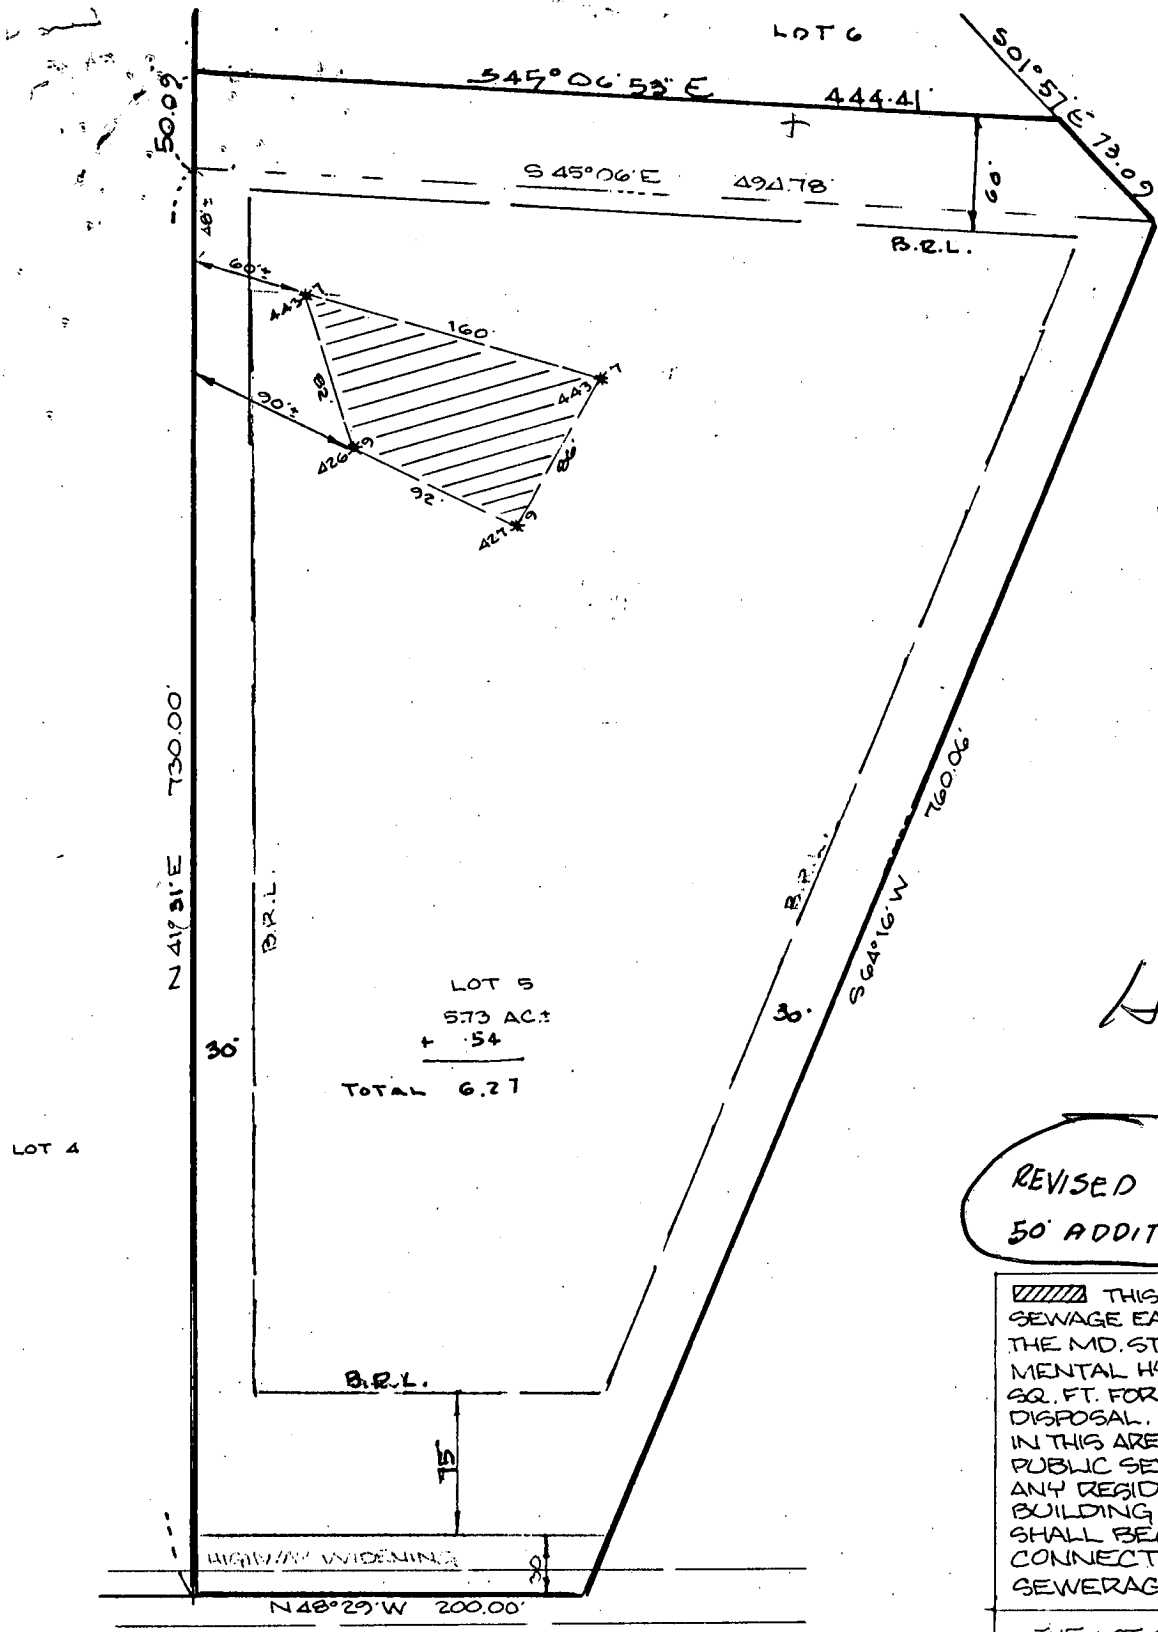

LOT 5  
5.73 AC ±  
+ .54  
TOTAL 6.27

*Health Dept*

REVISED 4/28/1981  
50' ADDITION IN REAR

THIS AREA DESIGNATES A PRIVATE SEWAGE EASEMENT (AS REQUIRED BY THE MD. STATE DEPT. OF HEALTH & MENTAL HYGIENE) OF APPROX. 10,000 SQ. FT. FOR INDIVIDUAL SEWAGE DISPOSAL. IMPROVEMENTS OF ANY KIND IN THIS AREA ARE RESTRICTED UNTIL PUBLIC SEWER IS AVAILABLE & SERVICING ANY RESIDENTIAL STRUCTURE ON THIS BUILDING SITE. THIS EASEMENT SHALL BECOME NULL & VOID UPON CONNECTION TO A PUBLIC SEWERAGE SYSTEM.

THE LOT SHOWN HEREON COMPLIES WITH THE MINIMUM OWNERSHIP WIDTH & LOT AREA AS REQUIRED BY THE MD. STATE DEPT. OF HEALTH & MENTAL HYGIENE.

TAX MAP 40, PARCEL 396

FIELD-LOCATED PERC HOLES  
LOT 5 PROPERTY OF ROBIN JOHN LEY  
6<sup>TH</sup> ELECTION DISTRICT  
HOWARD COUNTY, MARYLAND  
1/29/1979 SCALE: 1" = 100'



WALTER PARK *Walter Park*  
REG. L.S. # 5539  
HUDKINS ASSOCIATES, INC.  
231 JOSEPH SQUARE  
COLUMBIA, MD. 21044

APPROVED: FOR PRIVATE WATER & PRIVATE SEWERAGE SYSTEMS. HOWARD CO. HEALTH DEPT.  
*Joseph Byler* 3-5-79  
COUNTY HEALTH OFFICER DATE

\* DENOTES FIELD-LOCATED PERC HOLES AND ELEVATIONS.

4/29/81  
USE THIS  
G.S.

*Solomon Const. Co.*

<b>B 1</b>	<b>7206</b>	SEQUENCE NO. (OEP USE ONLY)	<b>STATE OF MARYLAND PERMIT TO DRILL WELL</b> <i>please print or type</i>	OEP PERMIT NUMBER <b>HO-73-4170</b> <i>fill in this form completely</i>
------------	-------------	--------------------------------	--	---

(THIS NUMBER IS TO BE PUNCHED IN COLS. 3-6 ON ALL CARDS)  
*11.00.00 pump test 3 hr.*

Date Received 5/14/82 11.00  
(OEP Use Only)

**OWNER INFORMATION**

Last Name 15 EDMONDSON, WARREN C. Owner 34 Name  
 Street or RFD 36 1038 N RANDOLPH ST 55  
 Town 57 ARLINGTON MA State 76 Zip 02201

**B 3** LOCATION OF WELL

COUNTY HOWARD 21  
 SUBDIVISION LEY PROPERTY 42  
 SECTION 5 LOT 5 50  
 NEAREST TOWN FULTON 52  
 MILES FROM TOWN (enter 0 if in town) 2 73 2 76 77 78 79

**B 1 Continued** **DRILLER INFORMATION**

Driller's Name George F. FASTERMAN 77 License No. 80 40  
 Firm Name L.F. FASTERMAN, Inc.  
 Address 92105 Brown Church Rd. Mt. Airy, Md.  
 Signature George F. FASTERMAN Date 4/5/82

**B 4** DIRECTION OF WELL FROM TOWN (CIRCLE BOX)

LIME KILN RD. NEAR WHAT ROAD 30

ON WHICH SIDE OF ROAD (CIRCLE APPROPRIATE BOX) WEST EAST SOUTH NORTH

DISTANCE FROM ROAD 500 34 37 38 39

**B 2** WELL INFORMATION

APPROX. PUMPING RATE (GAL. PER MIN.) 5 12  
 AVERAGE DAILY QUANTITY NEEDED (GAL. PER DAY) 600 14 20

**USE FOR WATER** (CIRCLE APPROPRIATE BOX)

HOME (SINGLE OR DOUBLE HOUSEHOLD UNIT ONLY)  
 FARMING (LIVESTOCK WATERING & AGRICULTURAL IRRIGATION)  
 INDUSTRIAL, COMMERCIAL, STATE AND FEDERAL GOV. OTHER (REQUIRES APPROPRIATION PERMIT)  
 PUBLIC OR PRIVATE WATER COMPANY (REQUIRES APPROPRIATION PERMIT AND STATE HEALTH DEPARTMENT APPROVAL)  
 TEST, OBSERVATION, MONITORING (MAY REQUIRE APPROPRIATION PERMIT)

SHOW MAJOR FEATURES OF BOX & LOCATE WELL WITH AN X

SOURCES OF DRILLING WATER

1. 40' casing  
 2. 1 1/2' above gr.  
 3. 38' open

WRITE THE BOX NUMBER FROM THE MAP HERE

810 4  
480 1


Location OK  
5/14/82 JS  
X CW

APPROXIMATE DEPTH OF WELL 150 FEET 24 28

APPROXIMATE DIAMETER OF WELL 6 NEAREST INCH

**METHOD OF DRILLING** (circle one)

BORED (OR AUGERED)  JETTED  JETTED & DRIVEN  
 AIR ROTARY  AIR PERCUSSION  ROTARY (HYDRAULIC ROTARY)  
 CABLE  REVERSE ROTARY  DRIVE POINT  
 other \_\_\_\_\_

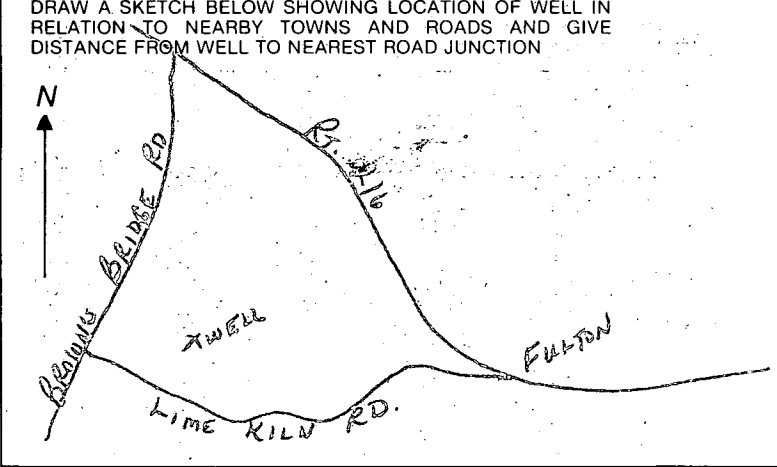

**REPLACEMENT OR DEEPEINED WELLS** (CIRCLE APPROPRIATE BOX)

THIS WELL WILL NOT REPLACE AN EXISTING WELL THIS WELL WILL REPLACE A WELL THAT WILL BE ABANDONED AND SEALED  
 THIS WELL WILL REPLACE A WELL THAT WILL BE USED AS A STANDBY  
 THIS WELL WILL DEEPEIN AN EXISTING WELL PERMIT NUMBER OF WELL TO BE REPLACED OR DEEPEINED (IF AVAILABLE) 41 \_\_\_\_\_ 52

**B 4** NOT TO BE FILLED IN BY DRILLER HEALTH DEPARTMENT APPROVAL

COUNTY NAME HOWARD COUNTY NO. AD1220

OEP SIGNATURE \_\_\_\_\_ STATE HEALTH CIRCLE BOX  41  
 DATE ISSUED 5/17/82 CO SIGNATURE Frank Thomas  
 NORTH GRID 491 EAST GRID 0814 EXPIRES 11/17/82


*Not to be filled in by driller (OEP USE ONLY)*

APPROP. PERMIT NUMBER \_\_\_\_\_ 54 G A P 63

FORCE  S WRITE INITIALS IN BOX PERMIT NO. HO-73-4170 70 71 72 73 74 75 76 77 78 79

**B 5** SPECIAL CONDITIONS 8-63



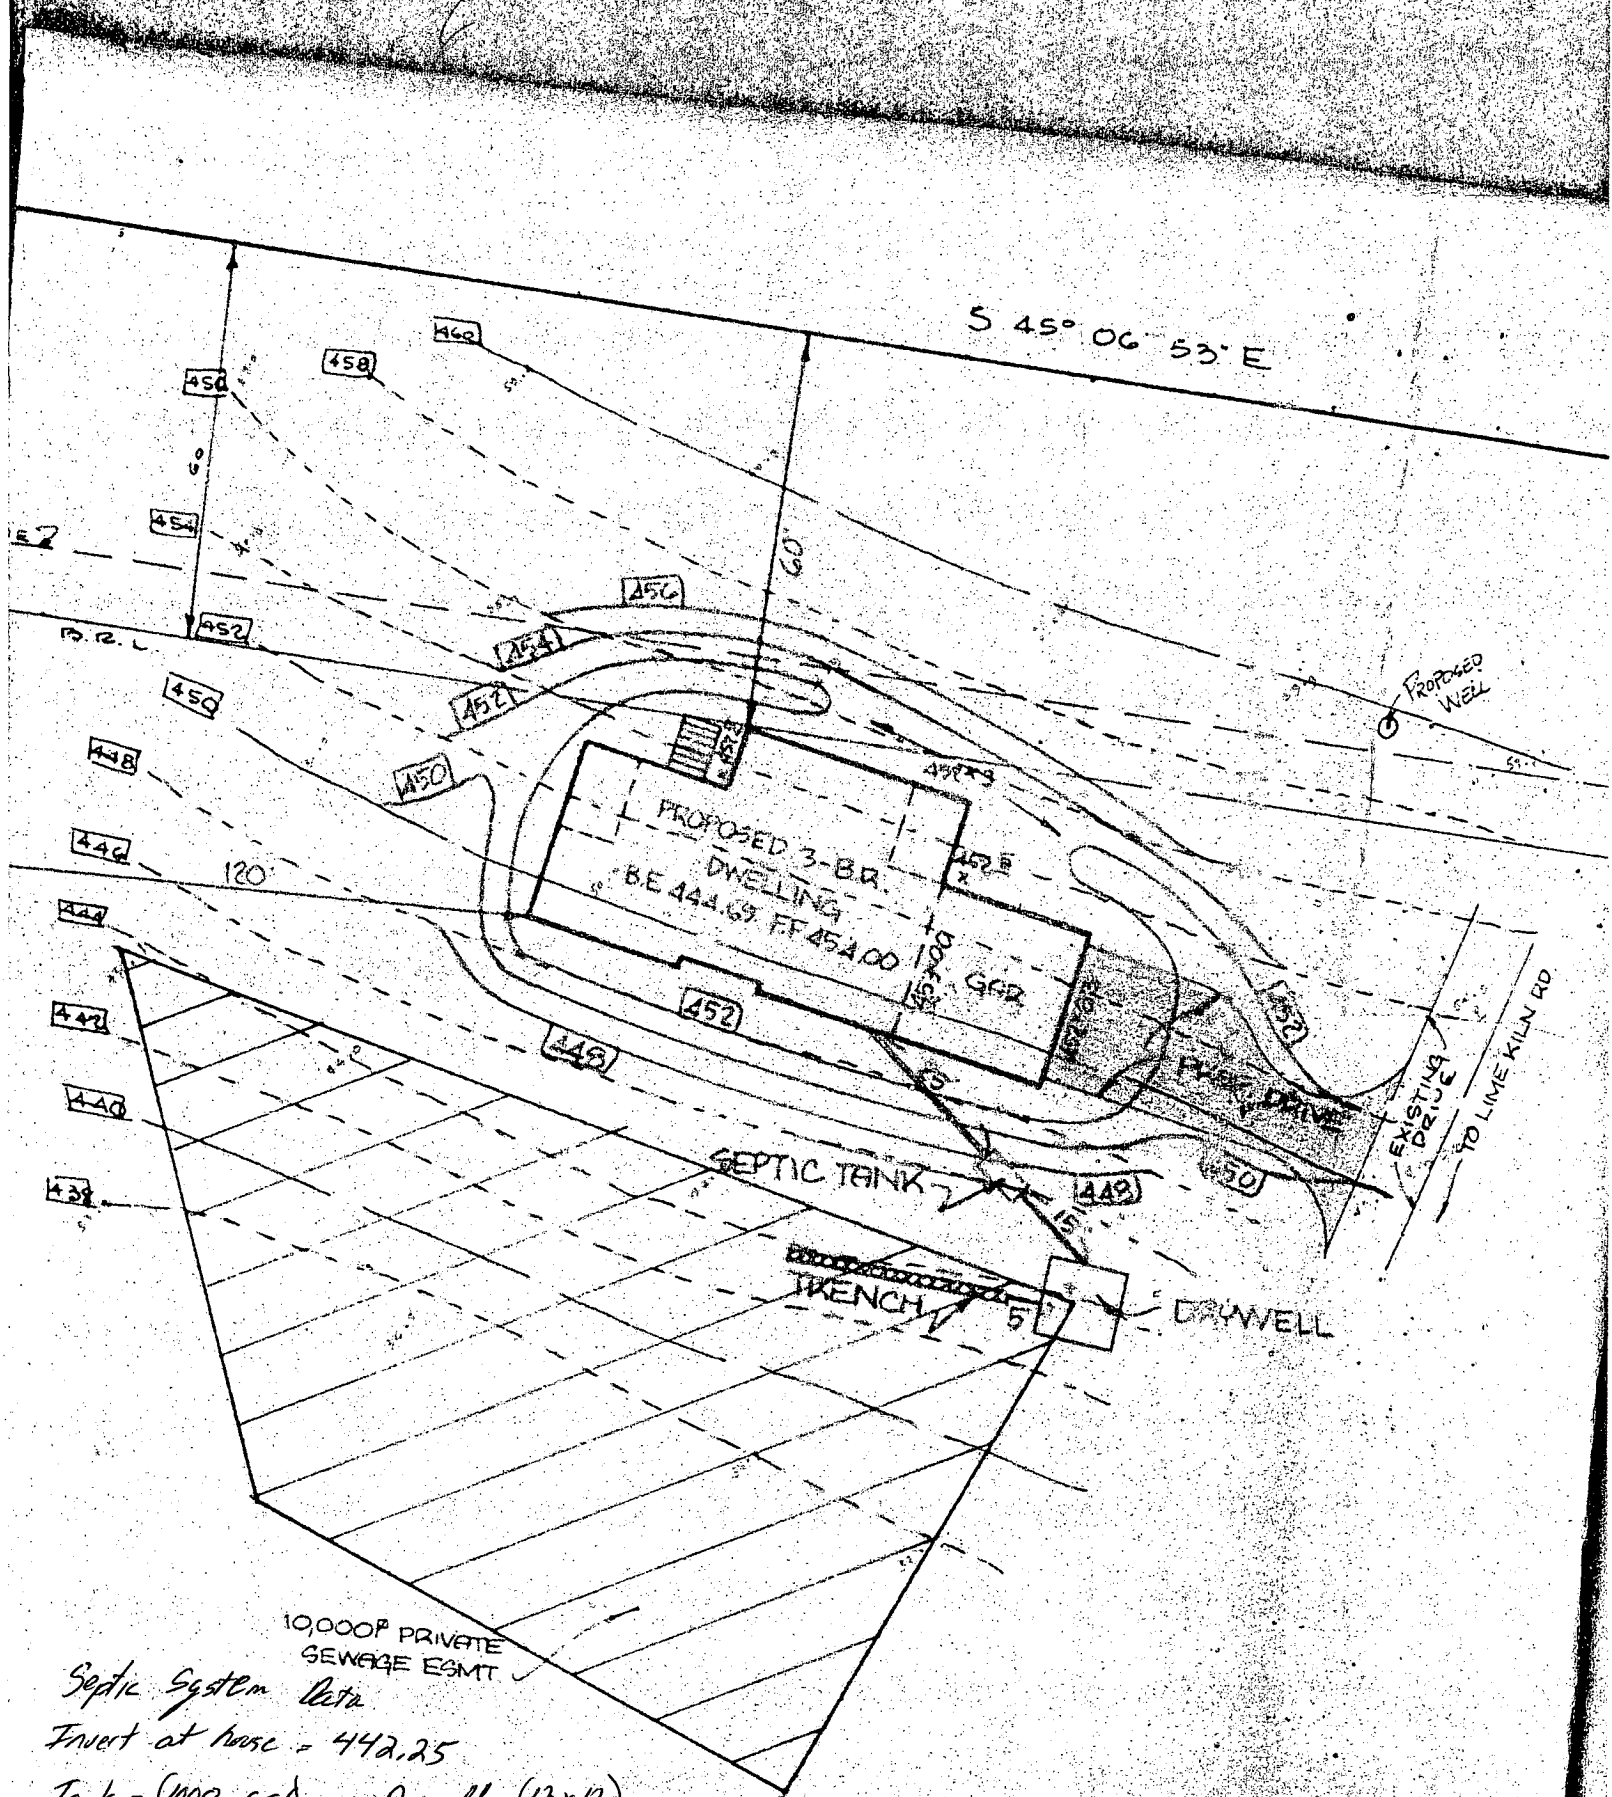

10,000 PRIVATE SEWAGE EGMT

*Septic System Data*

Invert at house = 442.25

Tank - (1000 gal)

ex br = 446.3

Fin. br 447

Invt in = 441.75

In. out = 441.50

Drywell (12x12)

Ex gr. = 444

Fin gr. = 444

Invt. In = 440.00

Bottom = 434

Trench

Ex gr. = 443.8

Fin gr. = 442.8

Invt. In 439.8

top of stone 440.3

Bottom of stone 433.80

6/4/82  
Sketch OK J.S.

3168

SEQUENCE NO. (OEP USE ONLY)

STATE OF MARYLAND WELL COMPLETION REPORT

THIS REPORT MUST BE SUBMITTED WITHIN 45 DAYS AFTER WELL IS COMPLETED.

(THIS NUMBER IS TO BE PUNCHED IN SPACES 3-6 ON ALL CARDS)

COUNTY NUMBER A 21229

Date Received (OEP use only)

DATE WELL COMPLETED

5/14/82

Depth of Well

160

(TO NEAREST FOOT)

PERMIT NO.

FROM "PERMIT TO DRILL WELL"

HO-73-4170

OWNER Edmonds

Warren

C

STREET OR RFD Limekiln

first name

TOWN Fulton

SUBDIVISION Lev Property

SECTION

LOT

5

WELL LOG

Not required for driven wells

STATE THE KIND OF FORMATIONS PENETRATED, THEIR COLOR, DEPTH, THICKNESS AND IF WATER BEARING

DESCRIPTION (Use additional sheets if needed)	FEET		Check if water bearing
	FROM	TO	
TOP SOIL	0	2	
SHALEY	2	10	
MICA	10	15	
SAND STONE	15	30	✓
MICA	30	45	
SAND STONE	45	55	✓
MICA	55	60	
FLINT	60	65	✓
MICA	65	110	
FLINT	110	115	
MICA	115	160	

GROUTING RECORD

WELL HAS BEEN GROUTED (Circle Appropriate Box) YES  NO

TYPE OF GROUTING MATERIAL CEMENT  BENTONITE CLAY

NO. OF BAGS 11 NO. OF POUNDS 1100

GALLONS OF WATER 55

DEPTH OF GROUT SEAL (to nearest foot) from 0 ft to 3 ft

CASING RECORD

caseing types insert appropriate code below

STEEL  CONCRETE

PLASTIC  OTHER

MAIN CASING TYPE ST

Nominal diameter top/main casing (nearest inch) 6

Total depth of main casing (nearest foot) 41

OTHER CASING (if used)

diameter inch depth (feet) to

EACH CASING

SCREEN RECORD

screen type or open hole insert appropriate code below

STEEL  BRASS  OPEN HOLE

PLASTIC  OTHER

DEPTH (nearest ft.)

EACH SCREEN

1 HO 39 160

2

3

SLOT SIZE

DIAMETER OF SCREEN (NEAREST INCH)

C 3 (Seq. no.)

PUMPING TEST

HOURS PUMPED (nearest hour) 3

PUMPING RATE (gal. per min. to nearest gal.) 8

METHOD USED TO MEASURE PUMPING RATE BUCKET

WATER LEVEL (distance from land surface)

BEFORE PUMPING 31

WHEN PUMPING 132

TYPE OF PUMP USED (for test)

A air P piston T turbine

C centrifugal R rotary O other (describe below)

J jet S submersible

PUMP INSTALLED

DRILLER WILL INSTALL PUMP (CIRCLE APPROPRIATE BOX) YES  NO

IF DRILLER INSTALLS PUMP, THIS SECTION MUST BE COMPLETED FOR ALL WELLS EXCEPT HOME USE

TYPE OF PUMP (WRITE APPROPRIATE LETTER IN BOX - SEE ABOVE: (A, C, J, P, R, S, T, O))

CAPACITY: GALLONS PER MINUTE (to nearest gallon)

PUMP HORSE POWER

PUMP COLUMN LENGTH (nearest ft.)

CASING HEIGHT (circle appropriate box and enter casing height)

above

below

LAND SURFACE

2 (nearest foot)

CIRCLE APPROPRIATE BOX

- A WELL WAS ABANDONED AND SEALED WHEN THIS WELL WAS COMPLETED
- E ELECTRIC LOG OBTAINED
- P TEST WELL CONVERTED TO PRODUCTION WELL

I HEREBY CERTIFY THAT THIS WELL HAS BEEN CONSTRUCTED IN ACCORDANCE WITH COMAR 10.17.13 "WELL CONSTRUCTION" AND IN CONFORMANCE WITH ALL CONDITIONS STATED IN THE ABOVE CAPTIONED PERMIT, AND THAT THE INFORMATION PRESENTED HEREIN IS ACCURATE AND COMPLETE TO THE BEST OF MY KNOWLEDGE.

DRILLERS IDENT NO. 40

DRILLERS SIGNATURE

SITE SUPERVISOR (sign of driller or journeyman responsible for sitework if different from permittee)

GRAVEL PACK


IF WELL DRILLED WAS FLOWING WELL CIRCLE BOX

OEP USE ONLY (NOT TO BE FILLED IN BY DRILLER)


TELESCOPE CASING

LOG INDICATOR

OTHER DATA

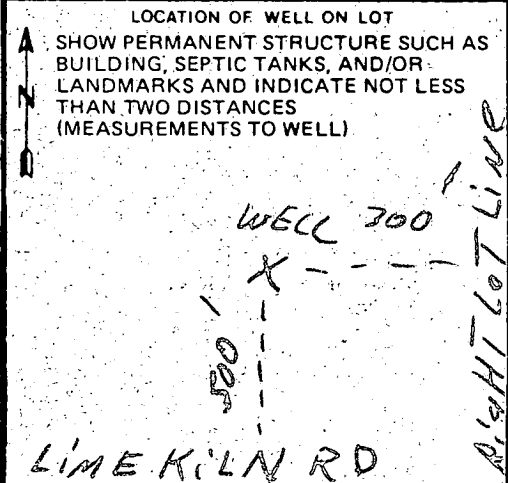



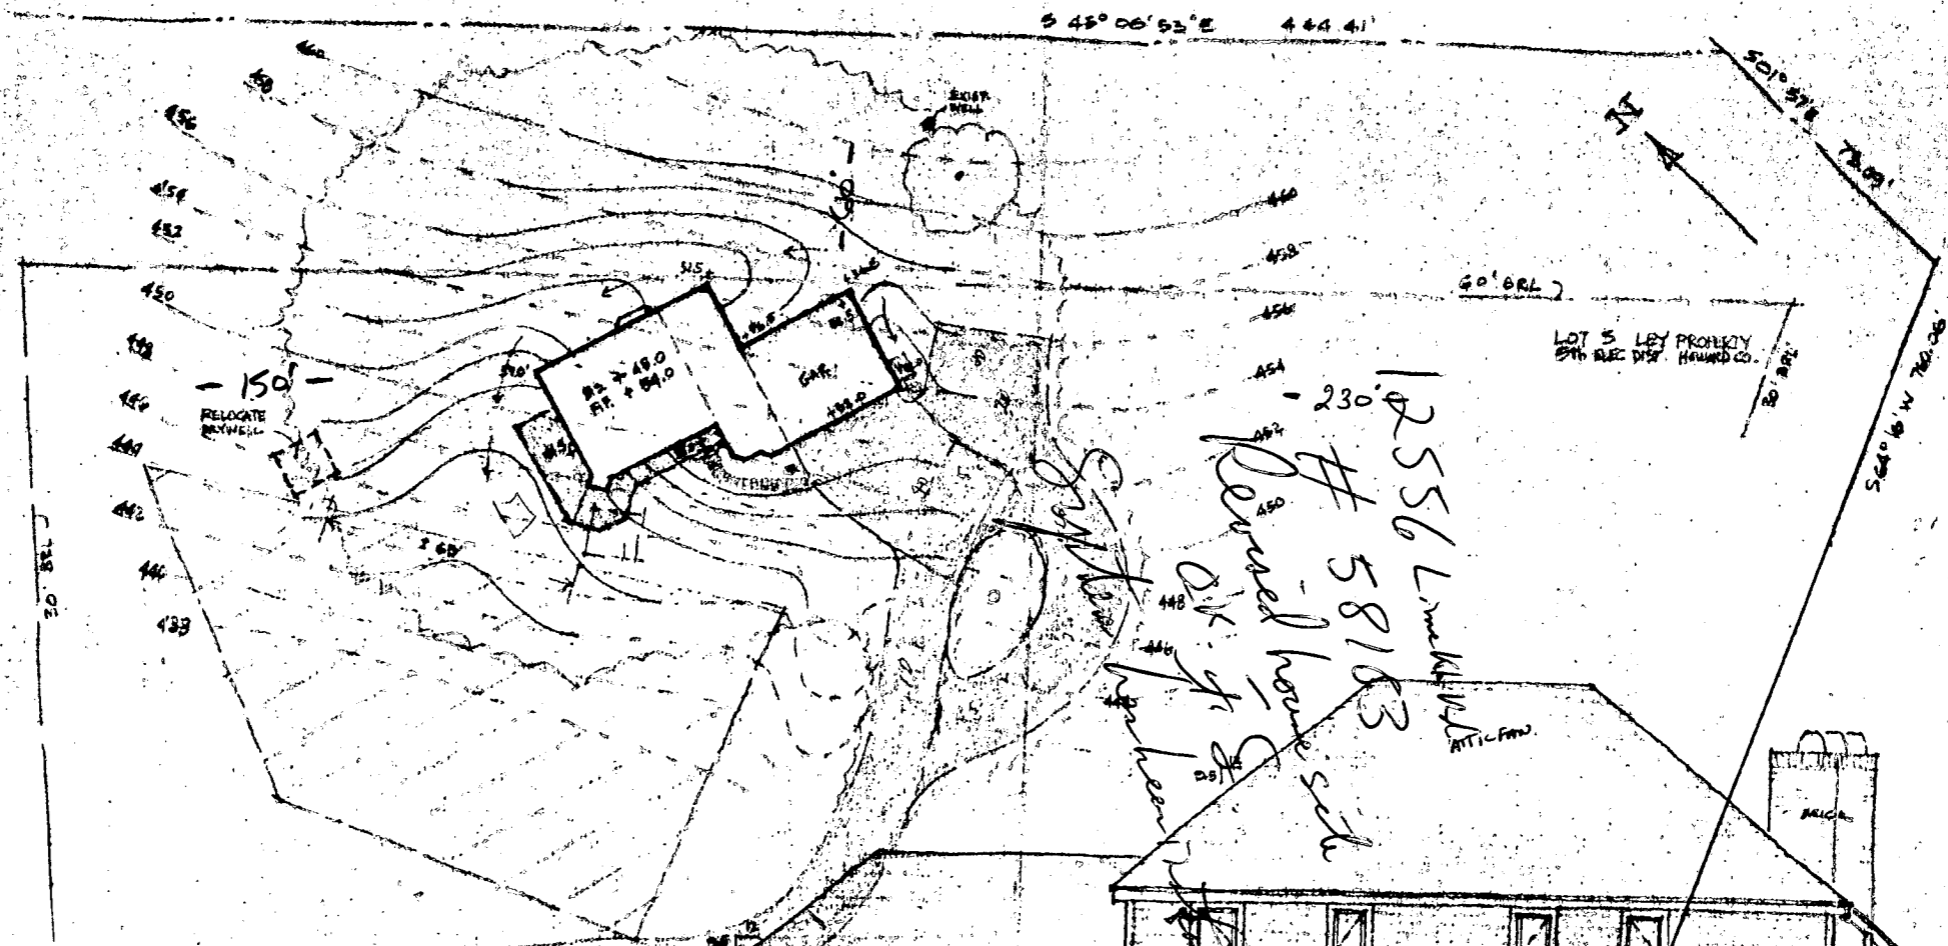

BOOYE/EDMUNDS RESIDENCE  
SOLMON CONST. CO. INC. BUILDERS

ROBERT KAPLAN & ASSOCIATES

ARCHITECTS  
2425 BANNEYER ROAD, COLUMBIA, MARYLAND 21044

19 JAN 83

3 of 3



NORTH ELEVATION



792 4220 INSPECTIONS

DEPARTMENT OF PUBLIC WORKS  
BUREAU OF INSPECTIONS LICENSES AND PERMITS  
3430 COURT HOUSE DRIVE, ELLICOTT CITY, MD. 21043  
(PLEASE PRINT)

9/5/84  
1100 N. 58183

PERMIT SERIAL NO	SEWER NO	WATER NO
------------------	----------	----------

PLUMBING ADDRESS (HOUSE NO., STREET, TOWN, ZIP CODE)  
12536 Limestone Road  
Fulton, Md 20759

APPLICATION IS HEREBY MADE TO PERFORM THE WORK HEREIN DESCRIBED:

NO	BLOCK NO	SECTION	CENSUS TRACT	PLUMBER (GAS FITTER) CONTRACTOR	NAME & ADDRESS, PHONE NO
5	23		6051	Arthur M. Black	15814 Bond Mill Road 776-7520 Laurel, Md 20707
OWNER	TYPE OF STRUCTURE (BE SPECIFIC)			NEW	EXISTING

OWNER NAME & ADDRESS	PHONE NO	OCCUPANT'S NAME & ADDRESS	PHONE #
Warren Edmunds + Sherry Booge 577 Piping Rock Dr Montgomery, Md 20904			

TYPE OF FIXTURE	FLOOR							TYPE OF FIXTURE	FLOOR							
	B	1	2	3	4	5	6		7	B	1	2	3	4	5	6
BATHUBS																
SHOWERS																
UPINALS																
LAVATORIES																
WATER CLOSETS																
KITCHEN SINKS																
2 OR 3 COMPARTMENT SINKS																
DISHWASHERS																
WASHING MACHINE CONN																
LAUNDRY TRAYS																
TOTAL																

© \$10.00 FOR 1ST FIXTURE & \$1.50 FOR EACH ADDITIONAL FIXTURE: \$

SEWER PIPE SIZE(S)	MATERIAL(S)	LENGTH	\$
CLEAR WATER WASTE PIPE SIZE(S)	MATERIAL(S)	LENGTH	\$
WATER PIPE SIZE(S)	MATERIAL(S)	LENGTH	\$
			\$
			\$
MECHANICAL (GAS, OIL, SOLAR) (BOILER, APPL, REFRIG, HEAT)			
TYPE OF PIPE ( ) PIPE SIZE(S)	RANGES NO	BOILERS NO	NO
NATURAL ( ) PIPE SIZE(S)	UNIT HEATERS NO	FURNACES NO	NO
PIPE SIZE(S)	FURNACES NO	UNIT HEATERS NO	NO
	BOILERS NO		NO
SOLAR: FURNACES NO			NO
	NO		NO


I hereby certify that this application and those the same is true and correct and that I am a duly licensed plumber in the State of Maryland and I will be responsible for the work done and for the payment of the same in advance of the work to be done. I have also paid the fee for this application and that the same has been received by the Bureau of Inspections and Permits.

1557  
LICENSE REGISTRATION NUMBER

PLUMBER APPLICANT SIGNATURE

PLEASE MAKE CHECKS PAYABLE TO DIRECTOR OF FINANCE OF HOWARD COUNTY

TOTAL	\$
ISSUED BY	
DATE	
CUSTOMER	

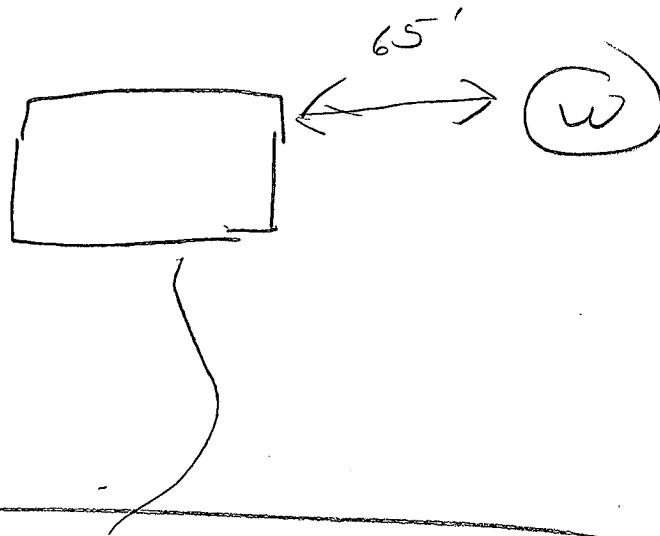

9/5/84 P.R.V. assembled to pipe & tank. No  
other work complete inside.  
Pitless, Pump & line installed - 4 ft below grade

# HOWARD COUNTY HEALTH DEPARTMENT

JOYCE M. BOYD, M.D., M.P.H.  
COUNTY HEALTH OFFICER



Bureau of Environmental Health  
3525 Ellicott Mills Drive  
Ellicott City, Maryland 21043

Director - 461-9956  
Water & Sewerage, Permits - 461-9933  
Community Environmental Health - 461-9944  
Technical Services - 461-9955

May 7, 1986

Mr. Warren C. Edmunds  
12556 Lime Kiln Road  
Fulton, Maryland 21759

Dear Mr. Edmunds:

Enclosed is a refund check for the well permit application fee that you had submitted on April 12, 1985, the permit was not issued.

I am sorry for any inconvenience this delay may have caused.

Very truly yours,

*Craig Williams F.S.*


Craig Williams, Director  
Water and Sewerage Program

CW/fs

cc: Betty DeVilbiss

Enclosure



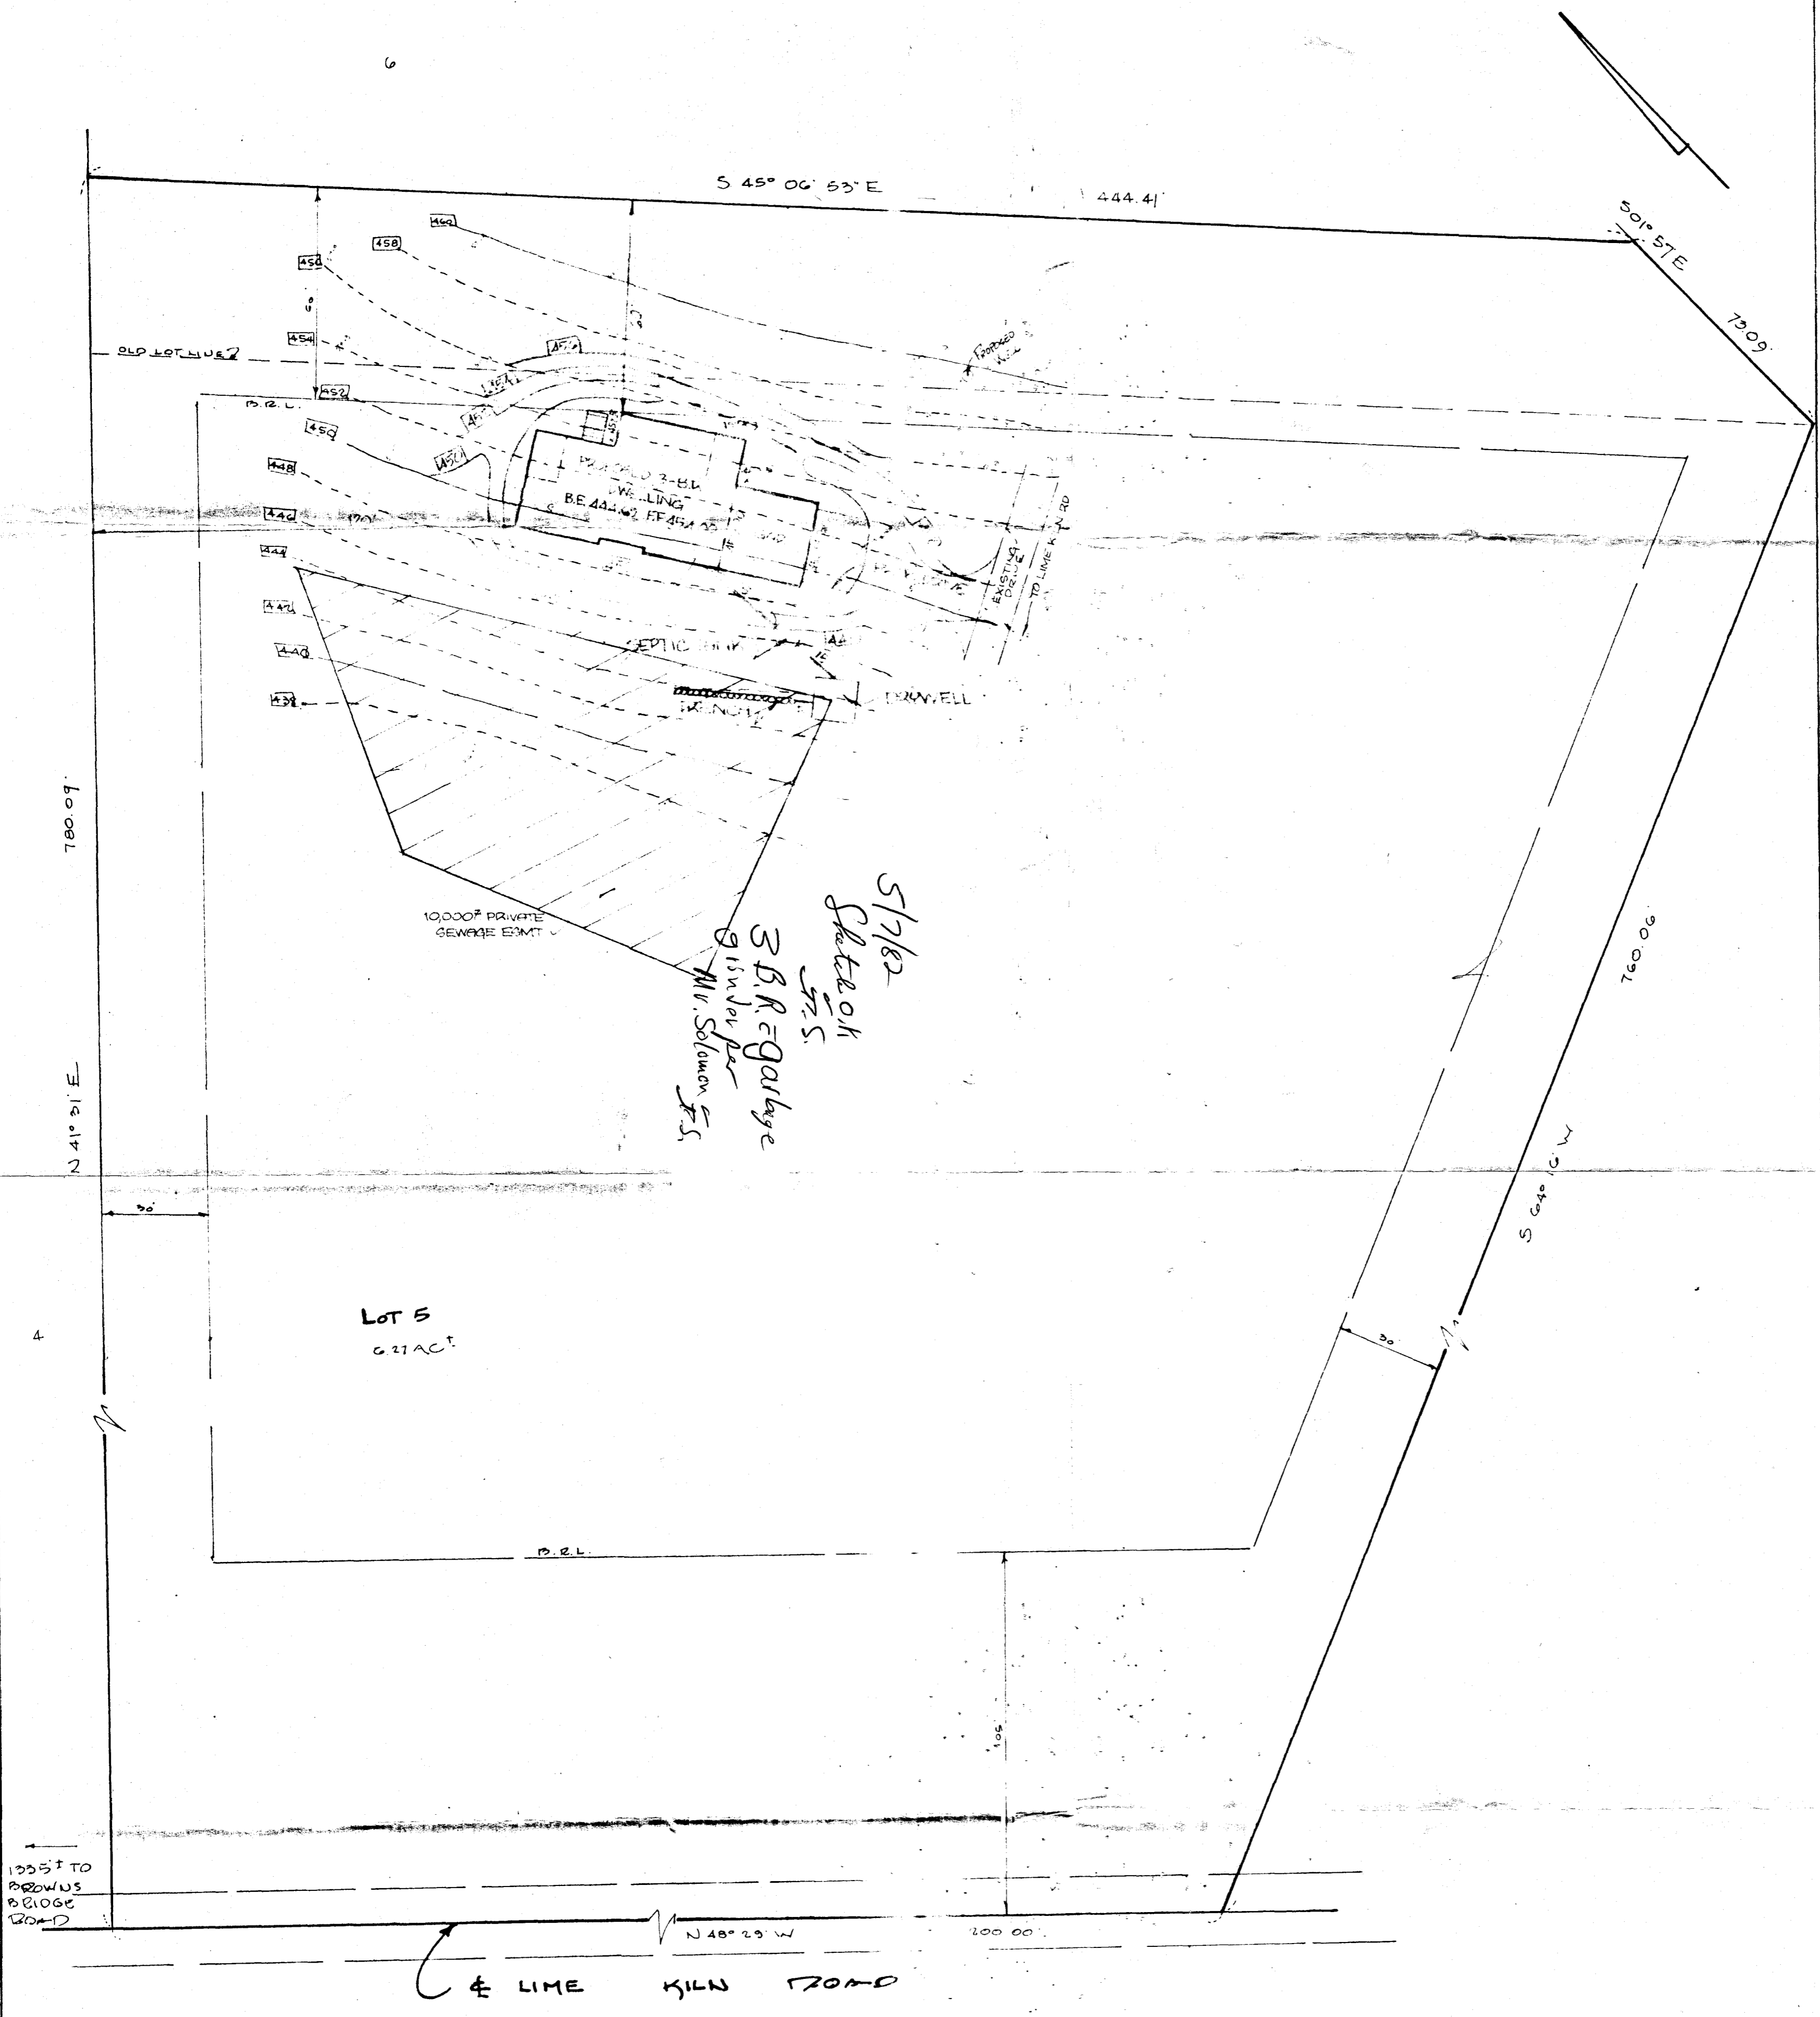

SEPTIC SYSTEM DATA

INVERT @ HOUSE : 442.75  
 SEPTIC TANK (1000 GAL.)  
 EX. GR. 446.3  
 FIN. GR. 447.0  
 INV. IN. 441.75  
 INV. OUT. 441.50  
 DRAWWELL (12x12")  
 EX. GR. 444.0  
 FIN. GR. 444.0  
 INVERT 441.00 IN (0) 440.00  
 BOTTOM 441.00

TRENCH  
 EX. GR. 443.00  
 FIN. GR. 443.00  
 INV. IN. 441.00  
 TOP OF STONE 440.30  
 BOTTOM OF STONE 433.00

LOT 5 LLEY PROPERTY  
 5TH ELECTION DISTRICT HOWARD CO., MD  
 SCALE 1" = 30'  
 TAX MAP 40  
 MARCH 23, 1982