

6/1/79

01-157759

Repair

File as per

P 29883

PERMIT

SEWAGE DISPOSAL SYSTEM

MARYLAND STATE DEPARTMENT OF HEALTH

Completed, NOT APPROVED

6/1/79

HOWARD COUNTY

ELLICOTT CITY

CBS/cw

Work NOT APPROVED AS OF 7/95

DISTRICT

INDEX AS COMPLETE

DATE 6/1/79

INDEXED (CW)

Sadler Plumbing & Heating, Inc.

IS PERMITTED TO INSTALL ALTER X

ADDRESS 3012 Benson Avenue, Baltimore, 21227

PHONE 242-2622

SUBDIVISION ROAD 6385 Lawyers Hill Road LOT

PROPERTY OWNER Al Talbott

ADDRESS 6385 Lawyers Hill Road, Elkridge, Md.

SPECIFICATIONS

SEPTIC TANK CAPACITY _____ GALLONS

DRAIN FIELD _____ DEPTH _____ FEET, BOTTOM AREA _____ SQ. FT.

DEEP TRENCH _____ DEPTH _____ FEET, BOTTOM AREA _____ SQ. FT.

SEEPAGE PITS _____ ABSORBENT SIDE-WALL AREA _____ SQ. FT.

INLET PIPE _____ FT. BELOW ORIGINAL GRADE. MAXIMUM DEPTH _____ FT. BELOW ORIGINAL GRADE

EFFECTIVE DEPTH AT _____ FT. BELOW ORIGINAL GRADE.

LOCATE DISPOSAL AREA _____ FT. FROM _____ LOT LINE AND _____ FT. FROM _____ LOT LINE AS SEEN WHEN

FACING LOT FROM Public water

REPAIR-CALL FOR INSPECTION WHEN GROUND IS OPENED UP SO SANITARIAN CAN RECOMMEND

REPAIR.

dry well location - ok just check pipe gravel
clean out

PLANS APPROVED BY Palmer F. Wine C. B. S.

DATE 6/1/79

COVER NO WORK UNTIL INSPECTED AND APPROVED.

NEITHER THE HOWARD COUNTY COUNCIL NOR THE HEALTH DEPARTMENT IS RESPONSIBLE FOR THE SUCCESSFUL OPERATION OF ANY SYSTEM.

NOTE: IF TRENCH IS USED CALL FOR INSPECTION BEFORE PLACING GRAVEL IN TRENCH.

NOTE: NO DRY WELL SHALL EXCEED 15 FOOT IN DIAMETER.


NOTE: ALL PIPE FROM HOUSE TO DISPOSAL AREA MUST BE CAST IRON.

PERMIT VOID AFTER THREE YEARS.

NOTE: INSTALL STAND PIPE ON SEPTIC TANK AND DRY WELL. STAND PIPES MUST BE 6 INCHES IN DIAMETER. CAST IRON, CONCRETE OR TERRA COTTA ACCEPTED.

*INSTALLER IS RESPONSIBLE FOR OBTAINING FINAL APPROVAL ON THIS PERMIT.

P 29883

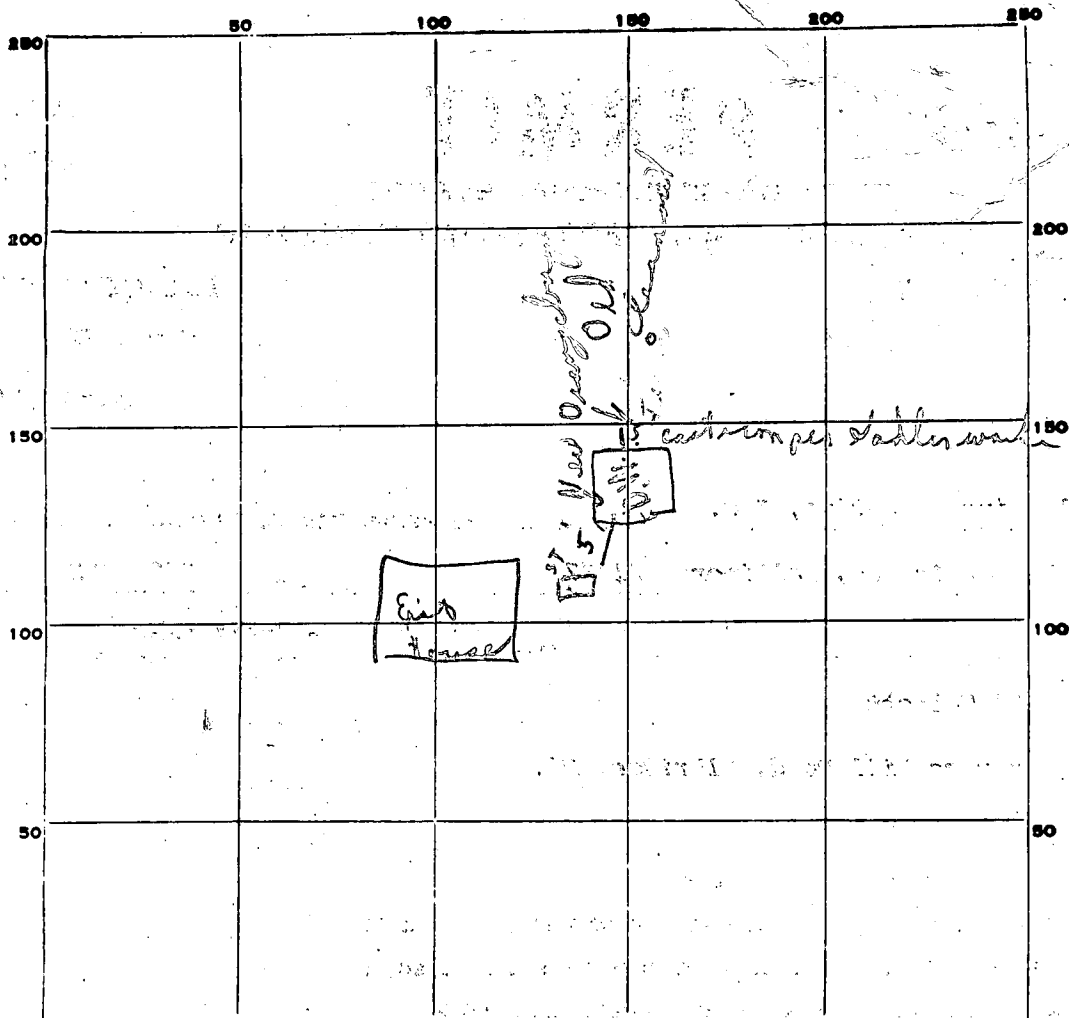

INDICATE NORTH - NAME ADJOINING ROADWAY AS BASE LINE.

PERMIT CARD _____

SEPTIC TANK, LEVEL _____

CLEANOUTS _____

DISTRIBUTION BOX, LEVEL _____

TILE FIELD, DEPTH _____ FT. TRENCH WIDTH _____ FT.

GRAVEL DEPTH _____ IN. TOTAL LENGTH _____ FT.

NUMBER OF TRENCHES _____ TOTAL BOTTOM AREA _____

SEEPAGE PITS, INSIDE DIAMETER _____ FT. DEPTH BELOW INLET _____ FT.

ABSORBENT AREA _____ SQ. FT.

REMARKS

6/1/79 checked - pipes around de well - septic
 went into dry well. Caution checked mounted
 on top of dry well. Checked as per F.F. directions
 on plan. C.B.S.

COMPLETED, NOT APPROVED

DATE SYSTEM APPROVED

6/1/79

INSPECTOR

CBS/cw

Repair permit

FILE Installing Illegal Septic System

DATE REPORTED 5/31/79

PROPERTY OWNER Talbott

P.O. ADDRESS 6385 Lawyers Hill Road, Elkridge, Md. TELEPHONE _____

DIRECTIONS TO PROPERTY _____

INFORMANT Man who called did not give name. Stated that he saw backhoe and couple of men which he believes are putting in an illegal system and that it is too close to the adjacent property owner's lot line. Stated this is approximately 1/8th of mile off Montgomery Road. White house behind a brick house with chipped driveway leading to property.

CONDITION FOUND 5/31/79 Sadies Company - Phone - 242-2622

dig well dug - no permit. Stopped work & told man to get permit for job & have job inspected. They said they would secure permit.

ACTION TAKEN _____

FINAL DISPOSITION _____