

11/01/01 AM Follow up

10/24/01 Layout ~ 1pm  
10/25/01 Follow Up Anytime  
10/26/01 1:00

1/23/02 Pump Test  
1/23/02 10:00 Pump Test

ISSUE DATE: 10/12/2001

APPROVAL DATE: 1/23/02

# PERMIT INDEXED

P 516071-D

A 511435-L

## ON-SITE SEWAGE DISPOSAL SYSTEM HOWARD COUNTY HEALTH DEPARTMENT BUREAU OF ENVIRONMENTAL HEALTH

03-334465

K & K Excavating \_\_\_\_\_ IS PERMITTED TO INSTALL  ALTER

ADDRESS: 14960 Frederick Road, Woodbine PHONE NUMBER: 410-442-1336

SUBDIVISION: The Estates at Sandhill LOT NUMBER: 12

ADDRESS: 2101 Grant Farm Court PROPERTY OWNER: Oak Hill Properties

SEPTIC TANK CAPACITY (GALLONS): 1250 (TOPSEAM) 410-984-6705

PUMP CHAMBER CAPACITY (GALLONS): 1250 (TOPSEAM) Steve Superintendent

NUMBER OF BEDROOMS: 4

SQUARE FEET PER BEDROOM: 180

LINEAR FEET OF TRENCH REQUIRED: 240

TRENCHES:	Trench to be 3.0 feet wide. Inlet 4.0 feet below original grade. Bottom maximum depth 6.0 feet below original grade. Effective area begins at 4.0 feet below original grade. 2.0 feet of stone below distribution pipe.
LOCATION:	Starting from the intersection of the 234.82' and 93.10' lot lines, place the distribution box 10' up the 93.10' lot line and 10' off this same lot line. Run (4) trenches on contour to right side of lot.
NOTES:	Install tanks in location shown on plan to reduce finished cover to approximately three feet.

PLANS APPROVED: MER OR SRK 10/10/01 DATE: 9/6/01

- NOTE: PERMIT VOID AFTER 2 YEARS
- NOTE: CONTRACTOR RESPONSIBLE FOR SCHEDULING A PRE-CONSTRUCTION INSPECTION FOR ALL INSTALLATIONS
- NOTE: WATERTIGHT SEPTIC TANKS REQUIRED
- NOTE: ALL PARTS OF SEPTIC SYSTEM SHALL BE 100 FEET FROM ANY WATER WELL
- NOTE: MANHOLE RISERS REQUIRED ON ALL SEPTIC TANKS AND PUMP CHAMBERS


NEITHER THE HOWARD COUNTY COUNCIL NOR THE HEALTH DEPARTMENT IS RESPONSIBLE FOR THE SUCCESSFUL OPERATION OF ANY SYSTEM PERMITTEE RESPONSIBLE FOR OBTAINING FINAL APPROVAL ON THIS PERMIT CALL 410-313-2640 FOR INSPECTION OF SEPTIC SYSTEM

**BUILDING PERMIT SIGNED AND RETURNED**  
7-13-05 BOO154942 SCREENED PORCH

03

111111

NOT TO SCALE

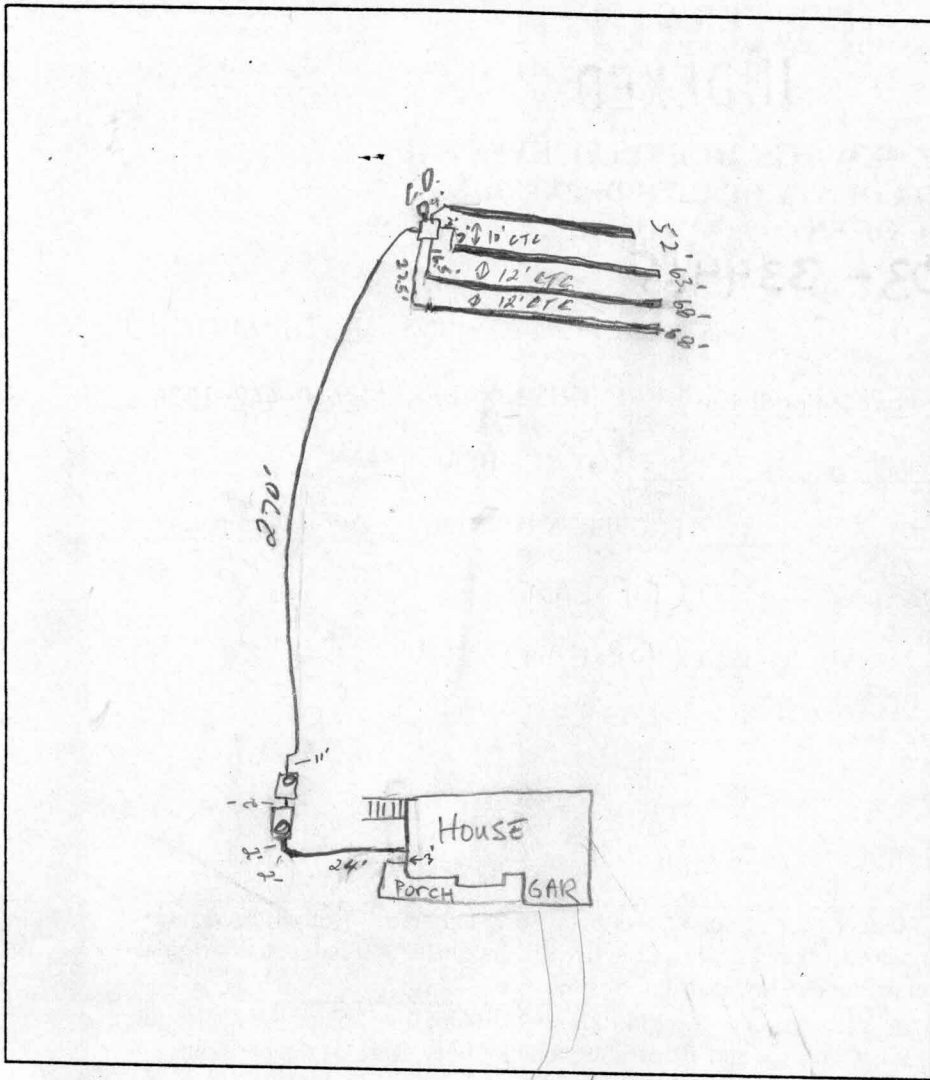

TRENCH DATA	
TRENCH WIDTH	3'
TRENCH INLET DEPTH	4'
TRENCH BOTTOM DEPTH	6'
DEPTH OF STONE	2'
NUMBER OF TRENCHES	4
TOTAL TRENCH LENGTH	251'
ABSORBENT AREA	753 #
DISTRIBUTION BOX LEVEL	<input checked="" type="checkbox"/>
BAFFLE IN DISTRIBUTION BOX	code book

SEPTIC TANK DATA	
SEPTIC TANK	1500 T.S. GALLONS
MANHOLE RISER	5'
6 INCH INSPECTION PORT	None
PUMP CHAMBER DATA	
PUMP CHAMBER GALLONS	1500 T.S.
MANHOLE RISER	42"
ALARM	Functional
PUMP PERFORMANCE TEST	OK

PRE-CONSTRUCTION INSPECTION: 10/24/01 HOUSE ELEV. REQUIRES BASEMENT PUMP.

S.T. LOCATIONS ADJUSTED TO L. SIDE OF HOUSE; OK TO START PER PLAN MR.

INSPECTION COMMENTS: 10/25/01 OK CONTINUE (KG)

10/26/01 Tanks set, no house connection, 2" sch 40 to DB. Told to put

baffle on inlet of P.T. OK to cover (S) 10/11/01 House conn. made,

trenches complete, OK to cover all work, alarm & pump test needed (S)

1/22/02 Pump NOT OPERATIONAL - Olen will call in reinspection (KG) 1/23/02 Pump

& Alarm OK (S)

BUILDING PERMIT SIGNED AND RETURNED

INSPECTOR Steve B...

DATE SYSTEM APPROVED 1/23/02