

10/14/74 File Final 5.6.

PERMIT

SEWAGE DISPOSAL SYSTEM

MARYLAND STATE DEPARTMENT OF HEALTH

HOWARD COUNTY

ELLICOTT CITY

DISTRICT 4

DATE 6/17/74

INDEXED

P 20165

A 15077

~~9/19/74~~ ~~9/25/74~~
~~9/25/74~~

10/14/74 Incomplete
No caps for cleanouts
(6" cleanouts)
10/14/74

Eugene Riggs IS PERMITTED TO INSTALL ALTER

ADDRESS 17534 New Hampshire Ave., Ashton, Md. PHONE 774-4824

A SEWAGE DISPOSAL SYSTEM LOCATED AT _____

SUBDIVISION _____ ROAD Jennings Chapel LOT 21
(see application for directions)

PROPERTY OWNER Daniel L. Barnes

ADDRESS _____

SPECIFICATIONS - 3 bedrooms

DRAIN FIELD _____ DEPTH _____ FEET, BOTTOM AREA _____ SQ. FT.

SEEPAGE PITS _____ ABSORBENT SIDE-WALL AREA _____ SQ. FT.

SEPTIC TANK CAPACITY 1,000 GALLONS

FOR GARBAGE GRINDER, INCREASE DISPOSAL AREA 22% & TANK CAPACITY 50%.

OTHER Dry well - 300 sq. ft. absorbent sidewall area to begin below the first 4 1/2 ft.

of non-absorbent ground. Max. depth permitted for dry well is 12 ft. below original grade.

Place dry well at spot 50 ft. behind point where the 270 ft. part of left side line meets

the 442.34 part of left side line as seen when facing from Jennings Chapel Road.

NOTE: ALL PIPE FROM HOUSE TO DRY WELL MUST BE CAST IRON.

PERMIT VOID AFTER THREE YEARS.


PLANS APPROVED BY D. W. Monaghan DATE 2/11/70

NOTE: INSTALL STAND ON SEPTIC TANK AND DRY WELL.
FILL SEPTIC TANK AND DISTRIBUTION BOX WITH WATER BEFORE CALLING FOR AN INSPECTION. COVER NO WORK UNTIL INSPECTED AND APPROVED.

NEITHER THE HOWARD COUNTY COMMISSIONERS NOR THE HEALTH DEPARTMENT IS RESPONSIBLE FOR THE SUCCESSFUL OPERATION OF ANY SYSTEM.

A 150

410-73-0793

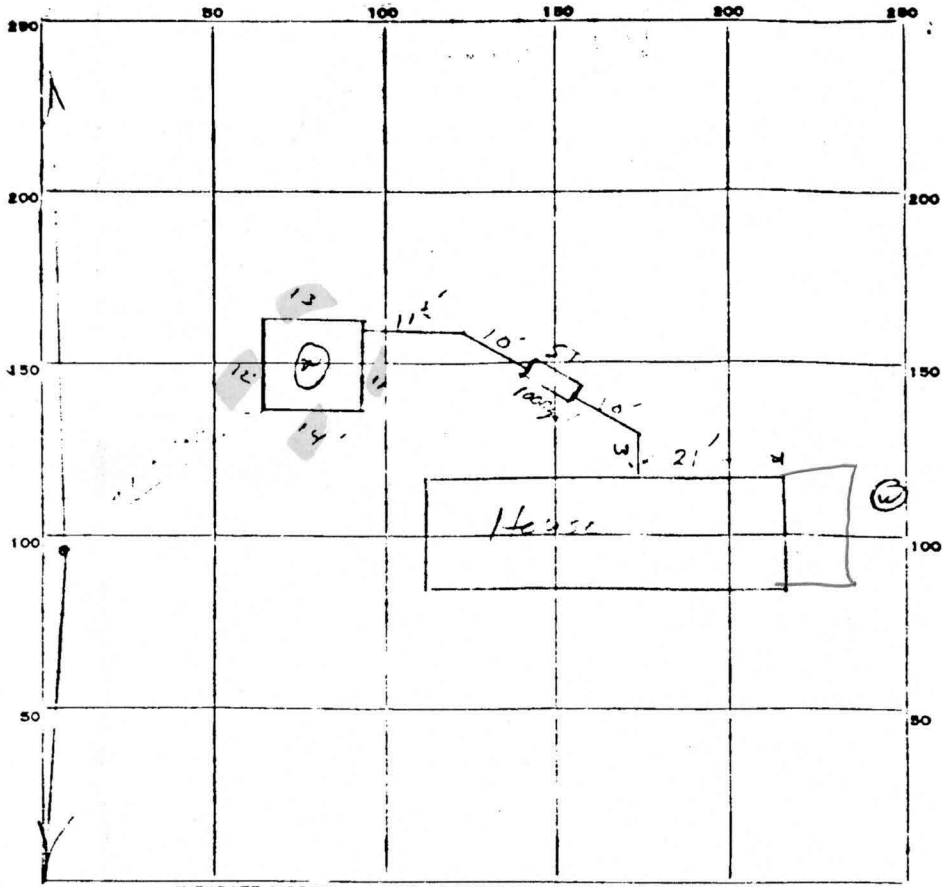

INDICATE NORTH - NAME ADJOINING ROADWAY AS BASE LINE

PERMIT CARD 20165

SEPTIC TANK LEVEL NO VENT CLEANOUTS NO VENT NO APPROVED

DISTRIBUTION BOX LEVEL _____

TILE FIELD DEPTH _____ FT. TRENCH WIDTH _____ FT.

GRAVEL DEPTH _____ IN. TOTAL LENGTH _____ FT.

NUMBER OF TRENCHES _____ TOTAL BOTTOM AREA _____

SEEPAGE PITS, INSIDE DIAMETER 50 FT. DEPTH BELOW INLET 8 1/2 FT.

ABSORBENT AREA 425 SQ. FT.

REMARKS 9/19/74 clean layer of red soil - E septic tank

2 level septic tank 9/24/74 No change

2 cleanouts at this date from West

(4) collection readers 7/77

1130 PM no 9-24-74