

# APPLICATION

A 27683

SEWAGE DISPOSAL TESTING

P \_\_\_\_\_

STATE OF MARYLAND - DEPARTMENT OF HEALTH AND MENTAL HYGIENE

DISTRICT 4th

HOWARD COUNTY HEALTH DEPARTMENT  
ENVIRONMENTAL HEALTH SERVICES

DATE 3/17/78

P. O. BOX 476, ELLICOTT CITY, MARYLAND 21043  
TELEPHONE: 465-5000, EXT. 356

*4/4/78  
9:30 A.M.  
cancelled  
4/21/78  
9:30 A.M.  
9:15  
11:30  
12:15*

TO: THE COUNTY HEALTH OFFICER  
ELLICOTT CITY, MARYLAND

I, HEREBY, APPLY FOR THE NECESSARY TEST IN ORDER TO CONSTRUCT (OR RECONSTRUCT) A SEWAGE DISPOSAL SYSTEM.

PROPERTY OWNER Robert Groves, Contract Purchaser: Stacey H. Smith *send letter*  
ADDRESS \_\_\_\_\_ 17800 Ridge Road *ZIP 20853*  
P. O. Box \_\_\_\_\_, Md. 774-4356  
office: 585-5200

PROPERTY LOCATION:

SUBDIVISION Mill Green LOT NO. 7

ROAD AND DESCRIPTION Hipsley Mill Road (on Jones Road)

SIZE OF LOT 2.160 acres TYPE BLDG. 3 or 4  
NUMBER OF BEDROOMS \_\_\_\_\_

IF NOT SINGLE RESIDENCE DESCRIBE \_\_\_\_\_

THE SYSTEM INSTALLED UNDER THIS APPLICATION IS ACCEPTABLE ONLY UNTIL PUBLIC FACILITIES BECOME AVAILABLE.

SIGNATURE OF APPLICANT Stacey H. Smith


APPROVED BY James Spilker FOR Dyeable and Transfer DATE 4/27/78  
(KIND OF SYSTEM)

REJECTED BY \_\_\_\_\_ FOR \_\_\_\_\_ DATE \_\_\_\_\_  
(KIND OF SYSTEM)

HOLD PENDING FURTHER TESTS \_\_\_\_\_ DATE \_\_\_\_\_

REASONS FOR REJECTION OR HOLDING \_\_\_\_\_

# THIS IS NOT A PERMIT

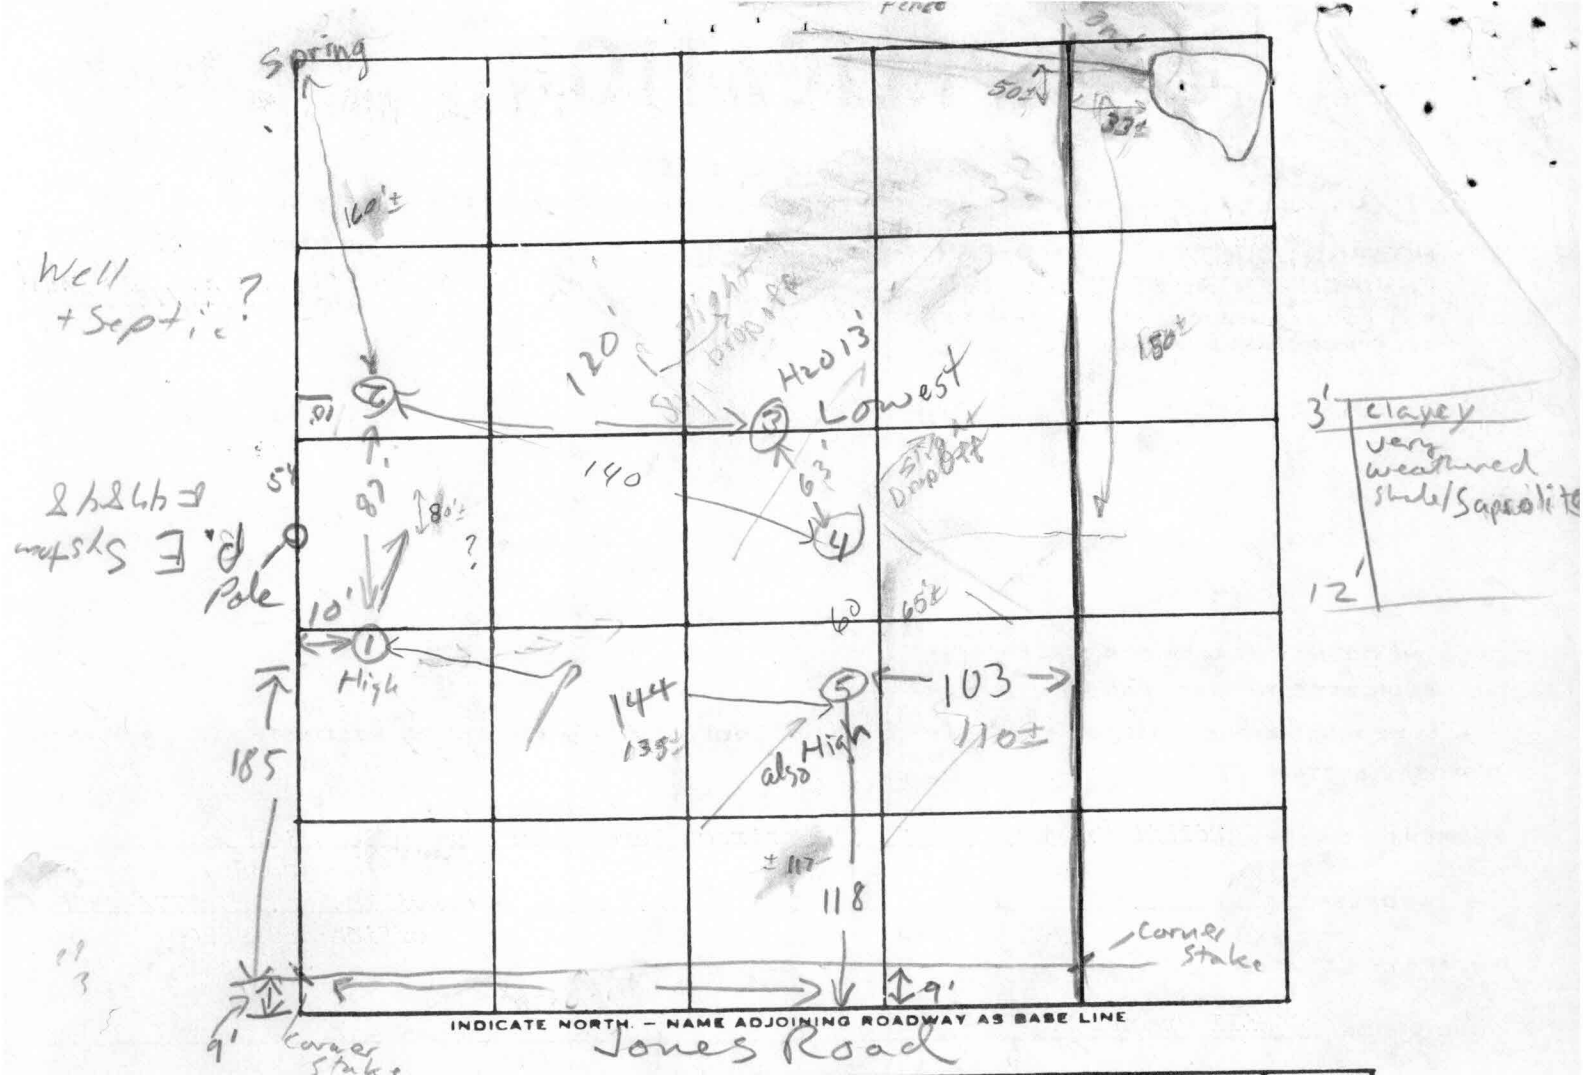

DATE	TEST NO.	DEPTH	PRE-WET		TEST - 1" DROP		TIME
			START	STOP	START	STOP	
1978 4/21	1 S	3 ft	10:00	10:08	10:08	10:18	10
4/21	1 D	12.5 ft	9:59	10:04	10:04	10:09	4
4/21	2 S	3'	10:09	10:14	10:14	10:36	22
4/21	2 D	12'	10:09	10:22	10:22	10:31	29
4/21	3	13' water					
"	4 S	3.5	10:26	10:32	10:32	10:42	10
"	4 D	12.5	10:27	10:39	10:39	10:54	15
"	5 S	3	10:42	10:44	10:44	10:48	4
"	5 D	12	10:46	11:03	11:03	11:19	16

11.25 Average  
150/BR

REMARKS \_\_\_\_\_

TYPE OF SOIL weathered shale saprolite

TESTED BY L.J. Spilker ALSO PRESENT: Oniell Mrs. Smith

120