

6-8964

DEPARTMENT OF INSPECTIONS, LICENSES AND PERMITS  
3400 COURT HOUSE DRIVE  
ELLSWORTH CITY, MD 21043  
PERMITS (410) 313-2400 INSPECTIONS (410) 313-0110  
AUTOMATED INFORMATION (410) 313-3900

# HOWARD COUNTY PERMIT APPLICATION

PERMIT NUMBER  
**B0053778** *K5B*

Building Address 13591 Julia Manor Way  
 Suite/Apt. # 04-67 SDP/WVP/Section # 04-67  
 Census Tract 603000 Subdivision Paddock EAST  
 Section 2 Area 7 Lot 8  
 Tax Map 22 Parcel 7 Grid 8  
 Zoning RA-DP Map Coordinates 958 Lot size 39,412 SF

Property Owner's Name Pulte Homes Inc  
 Address 15015 Edgewood St  
 City Bald State Md Zip Code 21037  
 Home Phone 710 644 5203 Work Phone \_\_\_\_\_  
 Applicant's Name & Mailing Address, (if other than stated hereon):  
 Phone \_\_\_\_\_ Fax \_\_\_\_\_

Existing Use VACANT LOT  
 Proposed Use SFD  
 Estimated Construction Cost \$ 250,000  
 Description of Work COMPTON - 2 story full  
bsmt, 9R, 3FB, 1FP, 2HB, 3CAR  
4BR - OPT: finished bsmt + patio

Contractor Company Same  
 Contact Person DIANNA WENZLAFF  
 Address Same  
 City \_\_\_\_\_ State \_\_\_\_\_ Zip Code \_\_\_\_\_  
 License No. 516 Phone \_\_\_\_\_ Fax \_\_\_\_\_

Occupant or Tenant \_\_\_\_\_  
 Contact Name \_\_\_\_\_  
 Address \_\_\_\_\_  
 City \_\_\_\_\_ State \_\_\_\_\_ Zip Code \_\_\_\_\_  
 Phone \_\_\_\_\_ Fax \_\_\_\_\_

Engineer or Architect Company \_\_\_\_\_  
 Contact Person \_\_\_\_\_  
 Address \_\_\_\_\_  
 City \_\_\_\_\_ State \_\_\_\_\_ Zip Code \_\_\_\_\_  
 Phone \_\_\_\_\_ Fax \_\_\_\_\_

### BUILDING DESCRIPTION - COMMERCIAL

### BUILDING DESCRIPTION - RESIDENTIAL

**Building Characteristics**  
 Height: \_\_\_\_\_  
 No. of stories: \_\_\_\_\_  
 Gross area, sq. ft. per floor: \_\_\_\_\_  
 Use group: \_\_\_\_\_  
 Construction type:  
 Reinforced Concrete  
 Structural Steel  
 Masonry  
 Wood Frame  
 State Certified Modular

**Utilities**  
 Water Supply:  
 Public  
 Private  
 Sewage Disposal:  
 Public  
 Private  
 Electric Yes  No   
 Gas Yes  No   
 Heating System:  
 Electric  Oil   
 Natural Gas   
 Propane Gas   
 Sprinkler system: N/A   
 Full  
 Partial  
 Other Suppression  
 # of Heads

**Building Characteristics**  
 SF Dwelling  SF Townhouse   
 1st floor: 64 Depth 66 Width 66  
 2nd floor: 36 66 66  
 Basement: 64 66 66  
 Finished Basement  Unfinished Basement   
 Craw space  Slab on Grade   
 No. of Bedrooms 4  
 Height: \_\_\_\_\_  
 Multi-family dwellings:  
 No. of efficiency units: \_\_\_\_\_  
 No. of 1 BR units: \_\_\_\_\_  
 No. of 2 BR units: \_\_\_\_\_  
 No. of 3 BR units: \_\_\_\_\_  
 Other Structure: \_\_\_\_\_  
 Dimensions: \_\_\_\_\_  
 Footings: \_\_\_\_\_  
 Roof Height: \_\_\_\_\_  
 State Certified Modular  
 Manufactured Home

**Utilities**  
 Water Supply:  
 Public  
 Private  
 Sewage Disposal:  
 Public  
 Private  
 Electric Yes  No   
 Gas Yes  No   
 Heating System:  
 Electric  Oil   
 Natural Gas   
 Propane Gas   
 Sprinkler system: N/A   
 NFPA #13D  
 NFPA #13R  
 Other:

THE UNDERSIGNED HEREBY CERTIFIES AND AGREES AS FOLLOWS: (1) THAT HE/SHE IS AUTHORIZED TO MAKE THIS APPLICATION; (2) THAT THE INFORMATION IS CORRECT; (3) THAT HE/SHE WILL COMPLY WITH ALL REGULATIONS OF HOWARD COUNTY WHICH ARE APPLICABLE THERETO; (4) THAT HE/SHE WILL PERFORM NO WORK ON THE ABOVE REFERENCED PROPERTY NOT SPECIFICALLY DESCRIBED IN THIS APPLICATION; (5) THAT HE/SHE GRANTS COUNTY OFFICIALS THE RIGHT TO ENTER ONTO THIS PROPERTY FOR THE PURPOSE OF INSPECTING THE WORK PERMITTED AND POSTING NOTICES.


Applicant's Signature Dianna Wenzlaff  
 Title/Company Pulte Homes

Print Name DIANNA WENZLAFF  
 Date 5.25.00

Checks payable to: **DIRECTOR OF FINANCE OF HOWARD COUNTY**  
 \*\* PLEASE WRITE NEATLY AND LEGIBLY. \*\*  
 - FOR OFFICE USE ONLY -

AGENCY	DATE	SIGNATURE	APPROVAL
Land Development DPZ			
State Highway			
Building Official			
Env. Engineering DPZ			
Health			
Fire Protection			
Is Seismic Control approval required prior to assistance?			
YES <input checked="" type="checkbox"/> NO <input type="checkbox"/>			
CONTINGENCY CONSTRUCTION START: <input type="checkbox"/>			
ONE STOP SHOP: <input type="checkbox"/>			
Distribution of Copies	White: Building Official	Green: LDD, DPZ	Yellow: DED, DPZ
			Pink: Health
			Gold: SHA

DEPT SETBACK INFORMATION	PROPERTY ID#
Front: _____	Filing fee \$ <u>100</u>
Rear: _____	Permit fee \$ _____
Side: _____	Excise tax \$ _____
Side St: _____	Add'l per. fee \$ _____
All minimum setbacks met?	TOTAL FEES \$ _____
YES <input type="checkbox"/> NO <input type="checkbox"/>	Sub-total paid \$ _____
Is Entrance Permit required?	Balance due \$ _____
YES <input type="checkbox"/> NO <input type="checkbox"/>	Check # <u>105410</u>
Fast-track District?	Validation # <u>21473</u>
YES <input type="checkbox"/> NO <input type="checkbox"/>	
Lot Coverage for NewTown Zone _____	
SDP/Red-line approval date _____	Accepted by _____

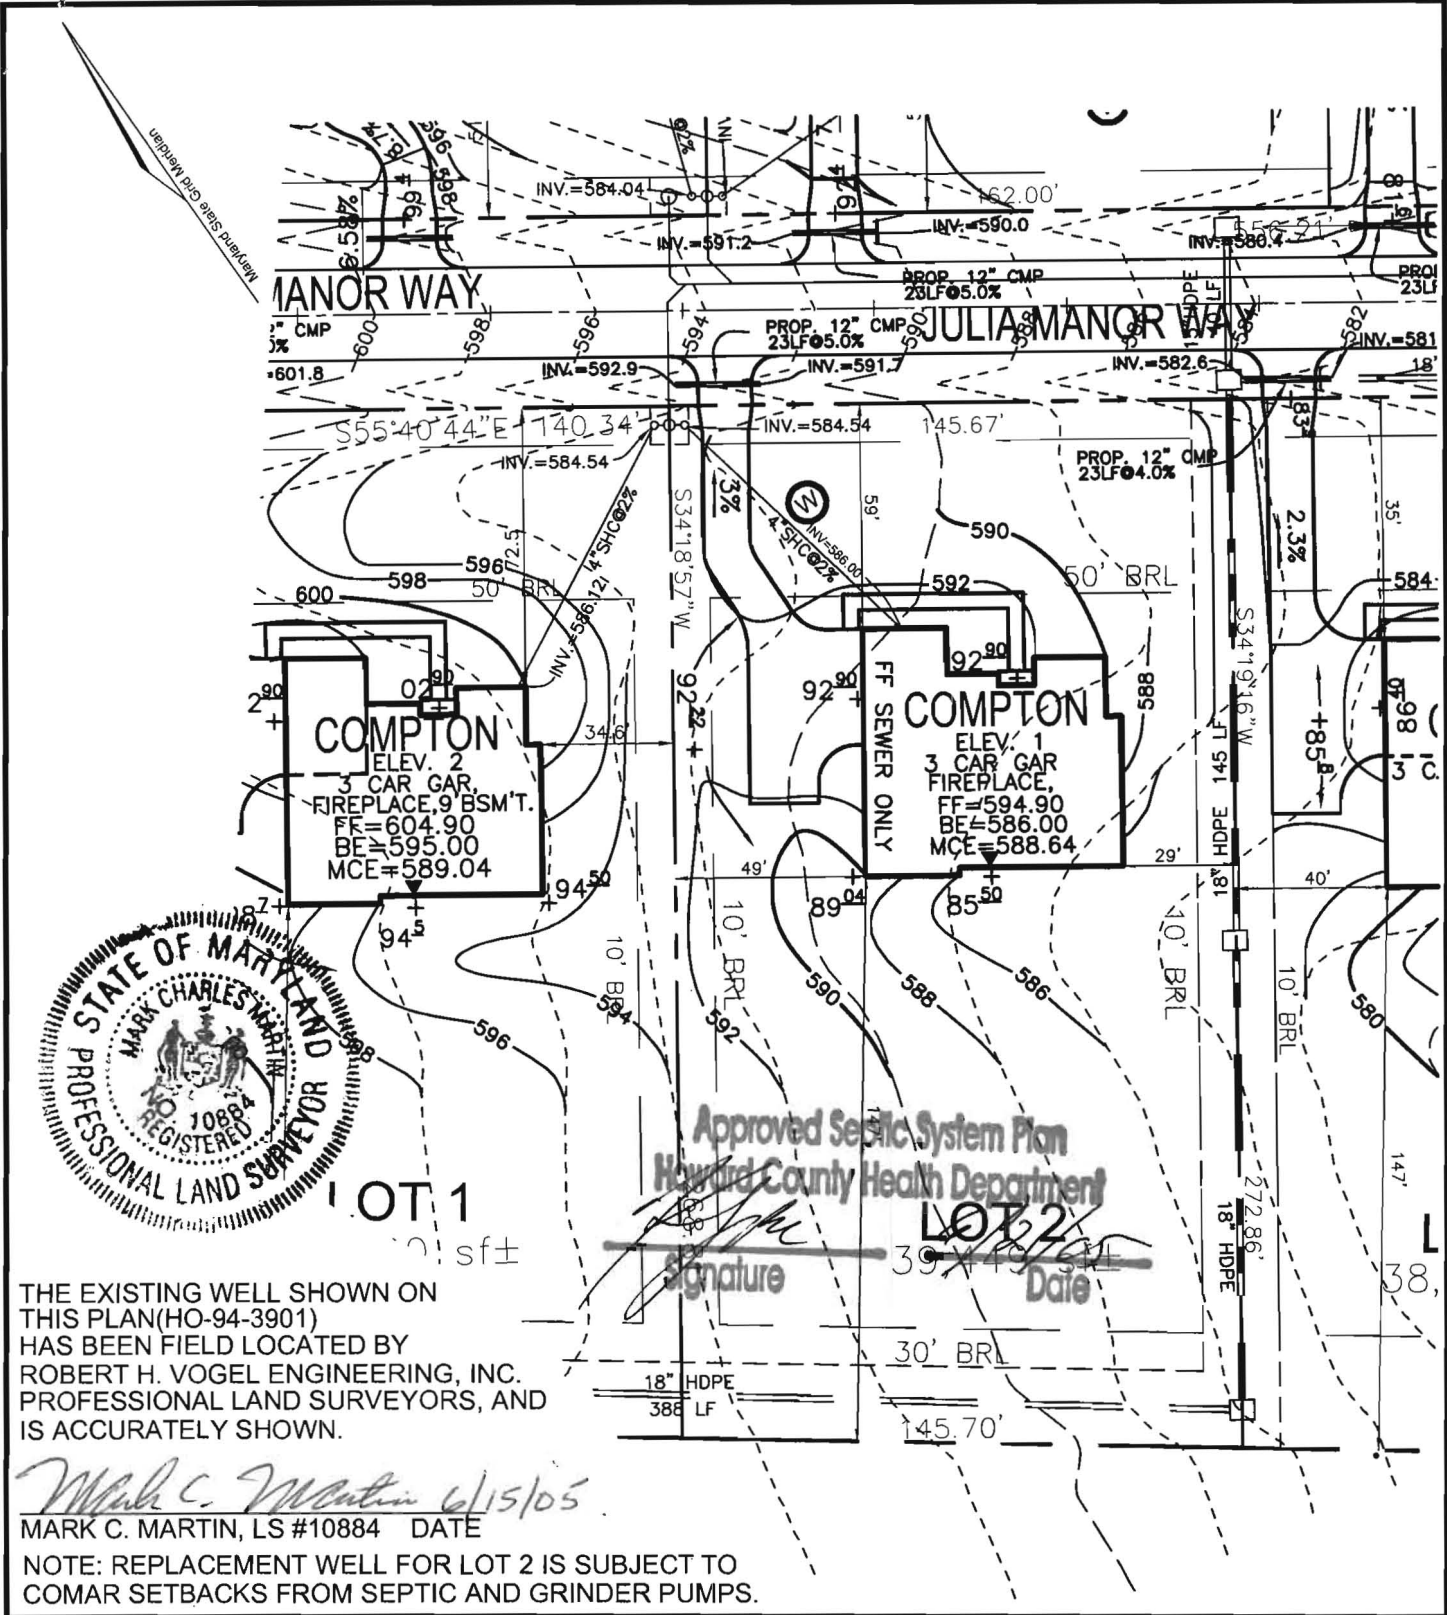

THE EXISTING WELL SHOWN ON THIS PLAN (HO-94-3901) HAS BEEN FIELD LOCATED BY ROBERT H. VOGEL ENGINEERING, INC. PROFESSIONAL LAND SURVEYORS, AND IS ACCURATELY SHOWN.

*Mark C. Martin 6/15/05*  
 MARK C. MARTIN, LS #10884 DATE

NOTE: REPLACEMENT WELL FOR LOT 2 IS SUBJECT TO COMAR SETBACKS FROM SEPTIC AND GRINDER PUMPS.

SCALE	1"=50'	<b>PULTE HOMES</b> <b>PADDOCKS EAST</b> LOT 2 <b>ROBERT H. VOGEL</b> <b>ENGINEERING, INC.</b> ENGINEERS • SURVEYORS • PLANNERS 8407 MAIN STREET ELLICOTT CITY, MD 21043 TEL: 410.461.7666 FAX: 410.461.8961	PARCEL 7
DRAWN BY	JCO		HOWARD COUNTY, MARYLAND
CHECKED BY	JCO		
DATE	MAY, 2005		
W. O. #	2034058		
SHEET#	1 OF 1		