

# APPLICATION

A 25069

## SEWAGE DISPOSAL TESTING

STATE OF MARYLAND - DEPARTMENT OF HEALTH AND MENTAL HYGIENE

P. \_\_\_\_\_

HOWARD COUNTY HEALTH DEPARTMENT  
ENVIRONMENTAL HEALTH SERVICES  
P. O. BOX 476, ELLICOTT CITY, MARYLAND 21043  
TELEPHONE: 465-5000, EXT. 356

DISTRICT 4<sup>th</sup>

DATE 12/28/76

TO: THE COUNTY HEALTH OFFICER  
ELLICOTT CITY, MARYLAND

I, HEREBY, APPLY FOR THE NECESSARY TEST IN ORDER TO CONSTRUCT (OR RECONSTRUCT) A SEWAGE DISPOSAL SYSTEM.

PROPERTY OWNER Gladys McDermott

ADDRESS Old Frederick Road Cooksville, Maryland PHONE \_\_\_\_\_

PROPERTY LOCATION:

SUBDIVISION Justifiable LOT NO. 4

ROAD AND DESCRIPTION Old Frederick Road

SIZE OF LOT 3 acre TYPE BLDG. 3  
NUMBER OF BEDROOMS

IF NOT SINGLE RESIDENCE DESCRIBE \_\_\_\_\_

THE SYSTEM INSTALLED UNDER THIS APPLICATION IS ACCEPTABLE ONLY UNTIL PUBLIC FACILITIES BECOME AVAILABLE.

SIGNATURE OF APPLICANT H. Thomas Quinn 747-1283  
Fairground Assoc.


APPROVED BY \_\_\_\_\_ FOR \_\_\_\_\_ DATE \_\_\_\_\_  
(KIND OF SYSTEM)

REJECTED BY \_\_\_\_\_ FOR \_\_\_\_\_ DATE \_\_\_\_\_  
(KIND OF SYSTEM)

HOLD PENDING FURTHER TESTS \_\_\_\_\_ DATE \_\_\_\_\_

REASONS FOR REJECTION OR HOLDING \_\_\_\_\_

# THIS IS NOT A PERMIT

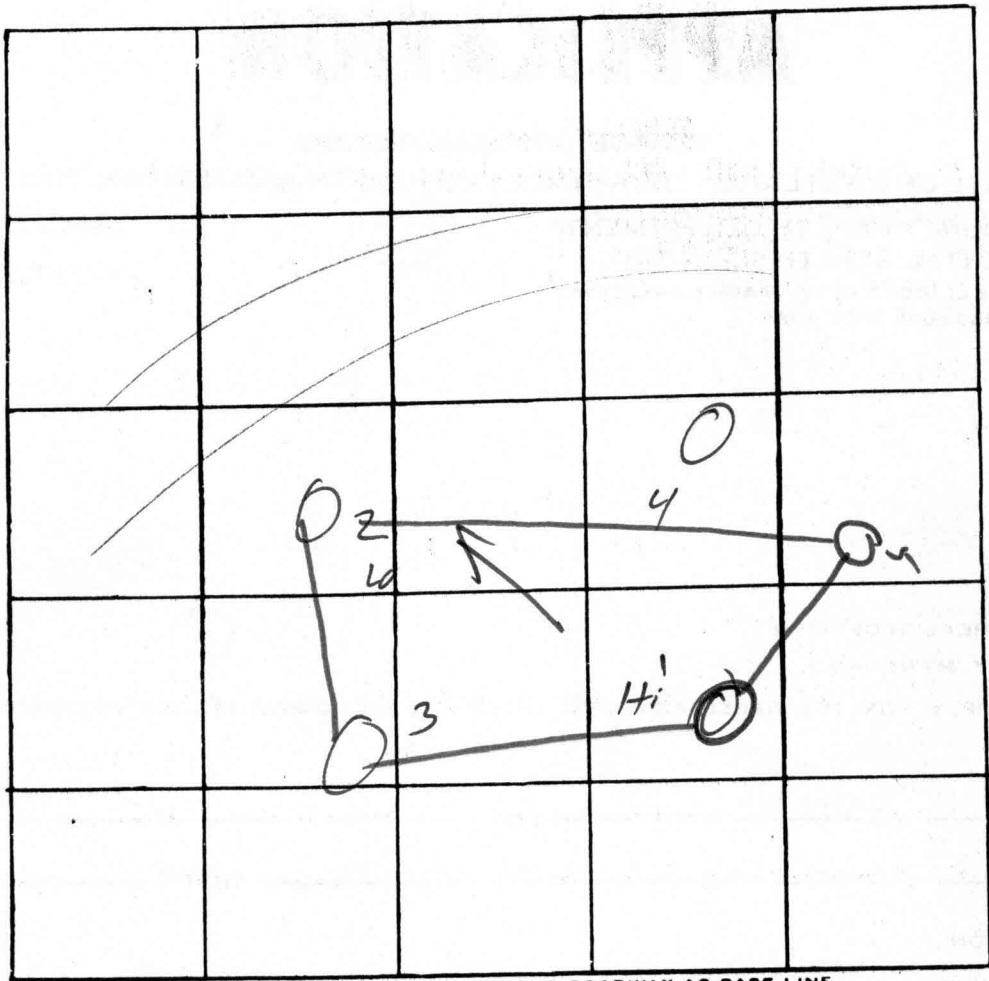

→  
RW  
↓

4  
Orig  
Specs  
Inv 4'  
Bot 10'  
X=12

INDICATE NORTH. - NAME ADJOINING ROADWAY AS BASE LINE


DATE	TEST NO.	DEPTH	PRE-WET		TEST - 1" DROP		TIME
			START	STOP	START	STOP	
12 May 77	1	4 1/2	142	148	145	200	12
		13	143	150	150	202	12
	2	4 1/2	140	150	150	210	20
		13				202	12
16 Aug 77	3	4	10 26	10 31	10 31	10 39	8
		13		10 26.5	10 26.5	10 28	1.5
	4	<del>X</del>					
	5	4	10 52	10 57	10 57	11 05	8
		13 1/2		11 05	11 05	11 30	25

REMARKS \_\_\_\_\_

TYPE OF SOIL \_\_\_\_\_

TESTED BY M ALSO PRESENT: \_\_\_\_\_

JUSTIFIABLE NEW Lot NEW 4

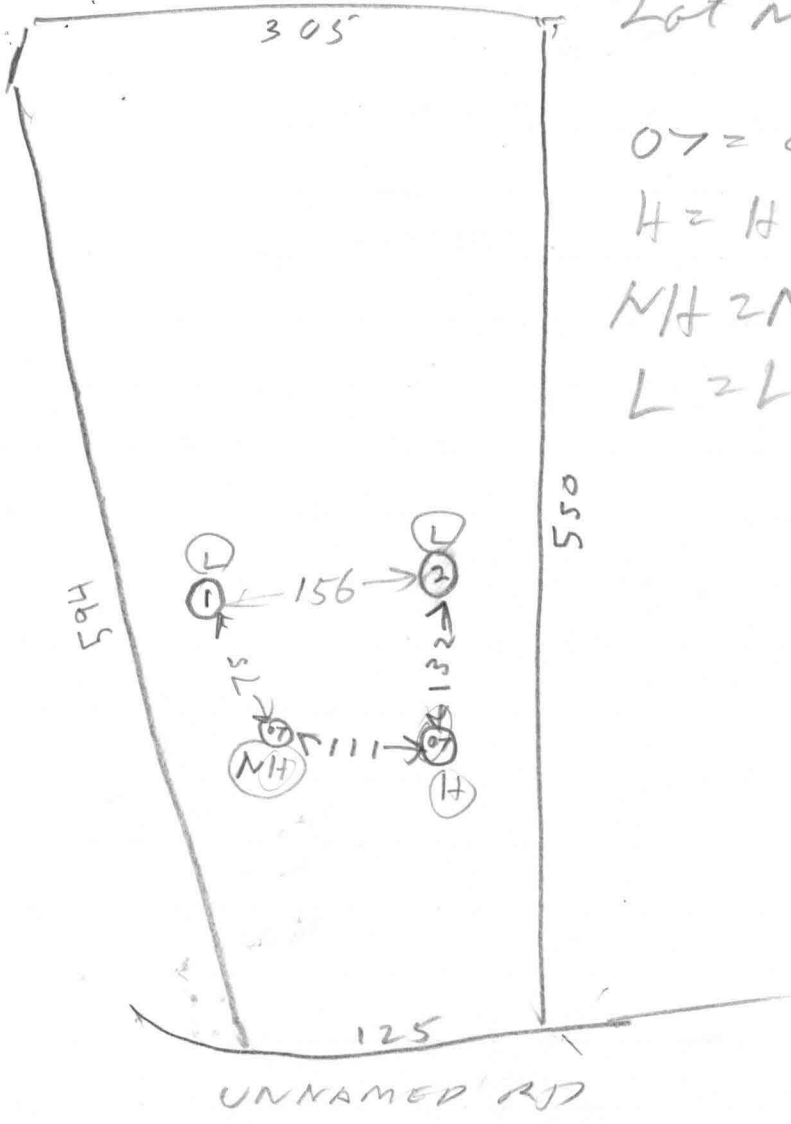

OT = OLD TEST  
 H = Highest Hole  
 MH = Next Highest  
 L = Lowest

40  
 3  
 172

32  
 1  
 1

Date	#	Depth	Start	Stop & Start	Stop	Time
29/7	15	5 1/2	754	215	240	25
	17	13	754	159	206	5
	20	12	701	20 1/2	203	1 1/2
29/7	25	4	159	212	240	28

Test by R Hodger 7/29/77  
 John of Schell Co

N/F Baxter  
289/556

89°05'58"E

1273.20

60' Roadway Reserve

425.00

235.00

444.00

Restriction Line

50' Bldg. Restriction Line

20' Bldg. Restriction Line

EASEMENT

*DW here*

*S Kinser  
Certe  
sewage area  
shown  
wrong  
per  
test*

*RH Approve  
Moonfield*

2.03 Ac.

20' Bldg. Restriction Line

589°05'58"W

442.88

217.88

225.0

5

6.47 Ac.

DRAINAGE EASEMENT

81°29'49"E 560.53'

*N 44° 35' 37" E  
199.41'*

4

2.67 Ac.

50' Building Restriction Line

50' Building Restriction Line

*RH Approve  
Moonfield*

3

2.00 Ac.

2

2.10 Ac

ORIG PLAT  
F-78-87

Lot Later  
Resubdivided

*RH Approve  
Moonfield  
Spec DW  
12/14/77*

75' Building Restriction Line

75' Building Restriction Line

75' Building Restriction Line

19' Restriction Line

44" W 427.54

18

17

16

R=50'  
L=241.17

R=25'  
L=21.03

R=1125.49

R=1075.49

240.18

284.83

272.18

198.62

197.00

217.00

217.00

217.00

217.00

19' Restriction Line

20' WIDE DRAINAGE EASEMENT

JUSTIFIABLE

COURT

*11/17/78  
Consult with  
DM  
about spec*

6

5.53 Ac.

19

20

21

508°31'47"E

180.00

160.00

150.00

140.00

130.00

120.00

110.00

100.00

90.00

80.00

70.00

60.00

50.00

*Water spec  
11/17/78 RH  
use for DW*

8

2.34 Ac.

El. 583.0

7

# HOWARD COUNTY HEALTH DEPARTMENT

JOYCE M. BOYD, M.D., M.P.H.  
DEPUTY STATE AND  
COUNTY HEALTH OFFICER



P.O. BOX 476  
ELLCOTT CITY, MARYLAND 21043  
TELEPHONE: ~~912-2330~~  
992-2330

March 30, 1978

Richard P. Browne Associates  
10227 Wincopin Circle  
American City Building  
Suite 212  
Columbia, Maryland 21044


ATTENTION: Liz Calia

RE: Resubdivision of Lot 4 -  
Justifiable

Dear M's Calia:

Please be advised that the 10,000 sq. ft. private sewer easement for the above referenced lot can be extended towards Lot 5's easement area to within 10 ft. of the property line, as per our telephone conversation of March 21, 1978 and March 29, 1978. Please send us a revised print for review before submitting original plat for approval.

Very truly yours,

  
Frank Skinner,  
Sanitarian

FS:hs