

APPLICATION

PERCOLATION TESTING

A 39581

P _____

HOWARD COUNTY HEALTH DEPARTMENT
BUREAU OF ENVIRONMENTAL HEALTH
P.O. BOX 476 ELLICOTT CITY, MARYLAND 21043
TELEPHONE: 461-9933

DISTRICT 5TH

DATE 6-12-87

TO: THE COUNTY HEALTH OFFICER
ELLICOTT CITY, MARYLAND

I, HEREBY, APPLY FOR THE NECESSARY TEST IN ORDER TO CONSTRUCT (OR RECONSTRUCT) A SEWAGE DISPOSAL SYSTEM.

PROPERTY OWNER Kennard Worfield Jr. Crystal Clear General Partnership

ADDRESS 14663 Tridelphia Rd Glenely 21737 PHONE 670-9114
442-2337

PROSPECTIVE BUYER N/A

ADDRESS _____ PHONE _____

PROPERTY LOCATION:

SUBDIVISION Crystal Clear LOT NO. 28 **LOT 23 Preliminary**

ROAD AND DESCRIPTION West side Ivory Rd North side Tridelphia Rd
13865 Kennard Drive

TAX MAP 22 PARCEL # 533

SIZE OF LOT 3 1/2 acres TYPE BLDG SFD
(SINGLE FAMILY DWELLING OR COMMERCIAL)

THE SYSTEM INSTALLED UNDER THIS APPLICATION IS ACCEPTABLE ONLY UNTIL PUBLIC FACILITIES BECOME AVAILABLE. I FULLY UNDERSTAND THE FEE CONNECTED WITH THE FILING OF THIS PERC TEST APPLICATION IS NON-REFUNDABLE UNDER ANY CIRCUMSTANCES. I ALSO AGREE TO COMPLY WITH ALL M.O.S.H.A. REQUIREMENTS IN TESTING THIS LOT.

Malden
(SIGNATURE OF APPLICANT)

APPROVED BY _____ FOR _____ DATE _____

REJECTED BY _____ FOR _____ DATE _____

HOLD PENDING FURTHER TESTS _____ DATE _____


REASONS FOR REJECTION OR HOLDING 7/20/87 Perc Satisfactory hold for Subd. Plat SFD

BLDG. PERMIT SIGNED
AND RETURNED 9/11/89
Serial # 28939 - SFD
5 Bedrooms with garb-chop

THIS IS NOT A PERMIT

① → ④
SOIL PROFILE

0"	AP
8"	Yellow BR Silty CLAY LOAM
3.5-4.0'	10% FRAGS SANDY (SILT) GRAVEL Tan/BR Silty SAND LOAM
12-13'	15-25% FRAGS MICACEOUS (Slightly)

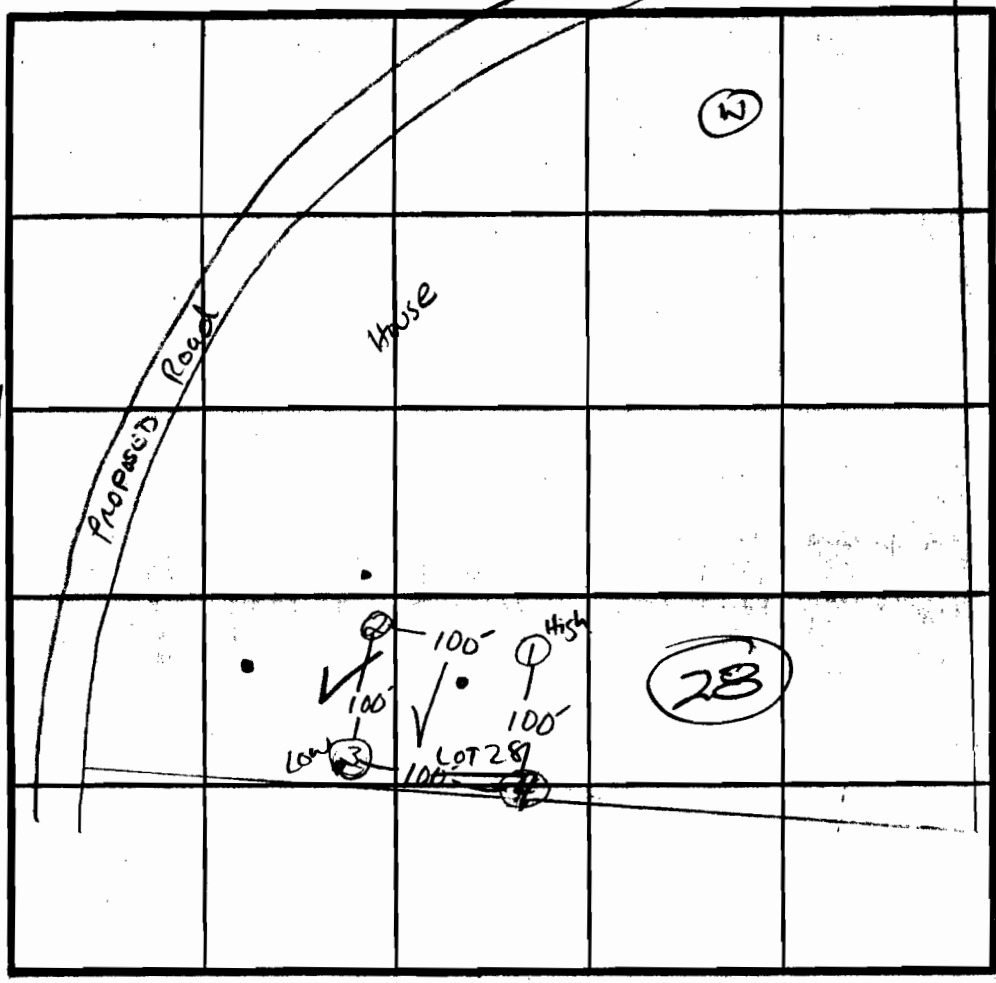

X PERC 4 min
160 φ 1BA
INLET 3.5'
BOTTOM 8.5'

3+4 on 4AP
Holes

INDICATE NORTH - NAME ADJOINING ROADWAY AS BASE LINE.

DATE	TEST NO.	DEPTH	PRE-WET		TEST - 1" DROP		TIME
			START	STOP	START	STOP	
7/28/67	1S	4'	10:53	10:55	10:55	10:58	3min
	1V	13'	UNIFORM	SOIL	below	3.5-4.0'	
	2S	4.5'	10:59	11:02	11:02	11:08	6min
	2V	12.5'	SAME AS	#1	UNIFORM	below	4.0'
	3V	13'	SAME AS	#1	MORE	gravelly	3-4' FRAGS 20-25%
	4S	4.5'	10:56	10:58	10:58	11:01	3min
	4M	8.0'	10:56	10:57	10:57	11:00	3min
	4V	12.5'	UNIFORM	SOIL	below ~	3.5'	SIMILAR TO #142

REMARKS Holes Diff Than PLAT

TYPE OF SOIL Cherty lm. → Gravelly lm.

TESTED BY S. Abel ALSO PRESENT MARK, KITTAMAN

EH 12-1079