

APPLICATION

FOR PERCOLATION TESTING AND SITE EVALUATION

TEST DATE(S) _____ TEST TIME _____

AP 525567
DATE 9/22/06

AGENCY REVIEW: _____

DO NOT WRITE ABOVE THIS LINE

I HEREBY APPLY FOR THE NECESSARY TESTING/EVALUATION PRIOR TO ISSUANCE OF SEWAGE DISPOSAL SYSTEM PERMIT(S) TO:

- CHECK AS NEEDED:
- CONSTRUCT NEW SEPTIC SYSTEM(S)
 - REPAIR/ADD TO AN EXISTING SEPTIC SYSTEM
 - REPLACE AN EXISTING SEPTIC SYSTEM

- CHECK AS NEEDED:
- NEW STRUCTURE(S)
 - ADDITION TO AN EXISTING STRUCTURE
 - REPLACE AN EXISTING STRUCTURE

- CHECK ONE:
- CREATE NEW LOT(S)
 - BUILD ON AN EXISTING LOT IN A SUBDIVISION
 - BUILD ON AN EXISTING PARCEL OF RECORD

- IS THE PROPERTY WITHIN 2500' OF ANY RESERVOIR?
- YES
 - NO

- THE TYPE OF STRUCTURE IS:
- RESIDENTIAL WITH unknown PROPOSED BEDROOMS IN THE COMPLETED STRUCTURE (NOTE **UNKNOWN** IF APPROPRIATE)
 - COMMERCIAL (PROVIDE DETAIL OF NUMBERS AND TYPES OF EMPLOYEES/ CUSTOMERS ON ACCOMPANYING PLAN)
 - INSTITUTIONAL/GOVERNMENT (PROVIDE DETAIL OF NUMBERS AND TYPES OF EMPLOYEES/USERS ON ACCOMPANYING PLAN)

PROPERTY OWNER(S) Estate of Robert H. Kittleman
 % Allan Kittleman
 DAYTIME PHONE 301-717-5728 CELL 301-717-5728 FAX [REDACTED]
 MAILING ADDRESS 3102 Fox Valley Dr. West Friendship MD 21794
 STREET CITY/TOWN STATE ZIP

APPLICANT Laura Kittleman Yeatts
 DAYTIME PHONE 301-785-5889 CELL 301-785-5889 FAX 206-333-0164
 MAILING ADDRESS Po Box 1017 Poolesville MD 20837
 STREET CITY/TOWN STATE ZIP

APPLICANT'S ROLE: DEVELOPER BUILDER BUYER RELATIVE/FRIEND REALTOR CONSULTANT

PROPERTY LOCATION
 SUBDIVISION/PROPERTY NAME Friendship Farm LOT NO. 3
 PROPERTY ADDRESS 3104 Fox Valley Dr. West Friendship, MD 21794
 STREET TOWN/POST OFFICE
 TAX MAP PAGE(S) 15 GRID 14,15,20,21 PARCEL(S) 117 PROPOSED LOT SIZE 1 acre

AS APPLICANT, I UNDERSTAND THE FOLLOWING: THE SYSTEM INSTALLED SUBSEQUENT TO THIS APPLICATION IS ACCEPTABLE ONLY UNTIL PUBLIC SEWERAGE IS AVAILABLE. THIS APPLICATION IS COMPLETE WHEN ALL APPLICABLE FEES AND A SUITABLE SITE PLAN HAVE BEEN RECEIVED. I ACCEPT THE RESPONSIBILITY FOR COMPLIANCE WITH ALL M.O.S.H.A. AND "MISS UTILITY" REQUIREMENTS. APPROVAL IS BASED UPON SATISFACTORY REVIEW OF A PERC CERTIFICATION PLAN.

TEST RESULTS WILL BE MAILED TO APPLICANT. _____
 SIGNATURE OF APPLICANT


HOWARD COUNTY HEALTH DEPARTMENT, BUREAU OF ENVIRONMENTAL HEALTH, WELL AND SEPTIC PROGRAM
 7178 COLUMBIA GATEWAY DRIVE COLUMBIA, MARYLAND 21046 (410) 313-2640 FAX (410) 313-2648
 TDD (410) 313-2323 TOLL FREE 1-877-4MD-DHMH

AP 525567

1
 1' RD BR
 gravelly
 CL
 2' multi-color
 micaceous
 FSL
 WK cem
 Saprolite
 7' LT BR
 FSL
 St. Cem
 Saprolite
 20% gravels
 11'

2
 4" BR gravelly
 L
 2' RD BR
 gravelly
 CL
 2' multi-color
 micaceous
 FSL
 WK cem
 Saprolite
 7.5' 30% St cem
 Saprolite
 11.5'

3
 2.5' RD BR
 gravelly
 CL
 multi-color
 micaceous
 FSL
 WK cem
 Saprolite
 7' LT BR
 FSL
 30%
 St cem
 Saprolite
 11'

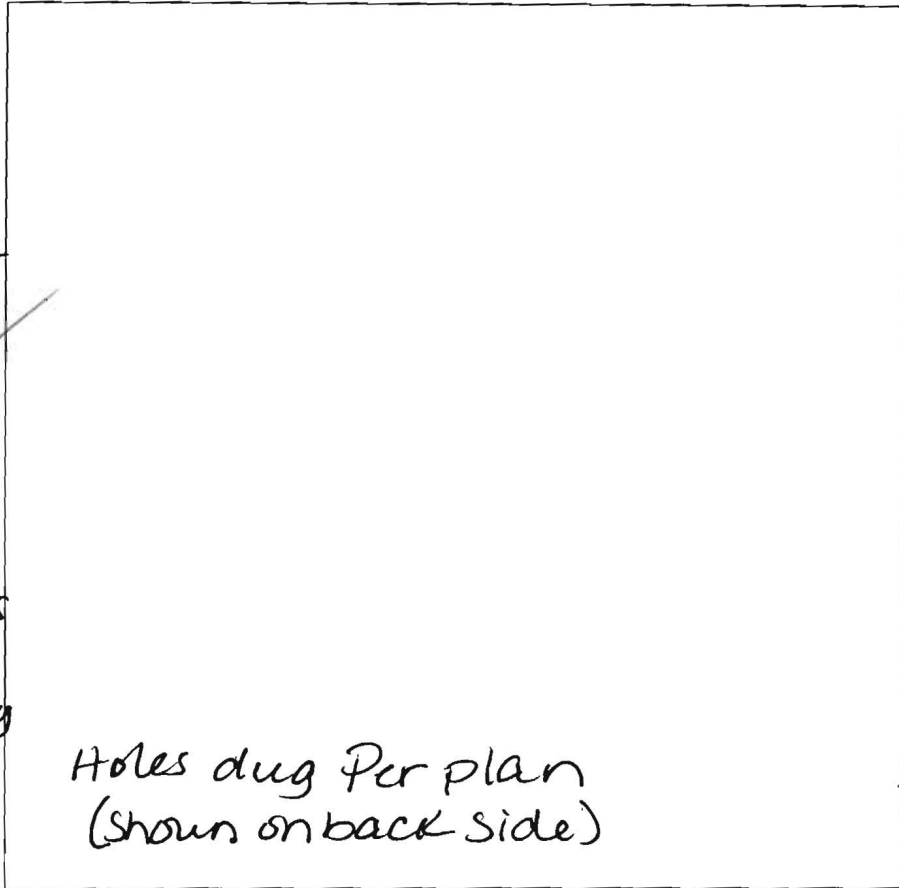

4
 1' BR gravelly
 L
 2' RD BR
 gravelly
 CL
 multi-color
 micaceous
 FSL
 WK cem
 Saprolite
 7' 80% St cem
 Saprolite
 11' 15% gravels

5
 5" BR gravelly
 L
 2' BR gravelly
 CL
 multi-color
 micaceous
 FSL
 WK cem
 Saprolite
 7' 40% St cem
 Saprolite
 11' 20% P laggy

7
 2' RD BR
 gravelly
 CL
 multi-color
 micaceous
 FSL
 WK cem
 Saprolite
 10.5'

DATE	TEST #	DEPTH	START	BREAK 1" DROP	STOP 2" DROP	TIME OF 2ND INCH	P/F/H
11/9/06	1	3.5' 4'	11:12	11:27	11:55	28	P
		4' 11'	2:54	2:56	3:00	4	P
	2	VISUAL					P
	3	VISUAL					P
	4	3.5' 11'	10:43	10:50	11:01	11	P
	5	4.5' 11'	10:12	10:14	10:17	3	P
		3' 11'	11:06	11:09	11:14	5	P
	7	3.5' 10.5'	10:31	10:34	10:37	3	P

REMARKS LOT 3
 SANITARIAN AT BACKHOE _____ OTHERS _____
 TEST HOLES USED IN SDA _____ AVG. PERC TIME 4.5 SQ. FT/BR 125
 TRENCH WIDTH _____ INLET DEPTH 2 MAX. BOT DEPTH 7 EFFECTIVE SAW near @ 4'

SS EASEMENT
TO BE MAINTAINED
ON LOT 4



RESIDUE OF MAP 15 GRID
15 PARCEL 117
(AGRICULTURAL
PRESERVATION EASEMENT
HO-92-09-E) PROPERTY
OF ROBERT H KITTLEMAN
ZONED RC-DEO L
4853/ F 467

KITTLEMAN PROPERTY
LOT 2 PLAT # 15769
MAP 15 GRID 15
PARCEL 271
ZONED RC-DEO


KITTLEMAN PROPERTY
LOT 1 PLAT #13357
MAP 15 GRID 15 PARCEL 2
ZONED RC-DEO

EXISTING 24' PRIVATE
USE-IN-COMMON
ACCESS EASEMENT (PLAT
#13357) F-99-24, TO BE
ABANDONED BY THIS PLAT

*copy Kittleman Property
Lots 1, 3, 4 & 5
Signed Perc
4/23/2009*

342
538
WELL

538

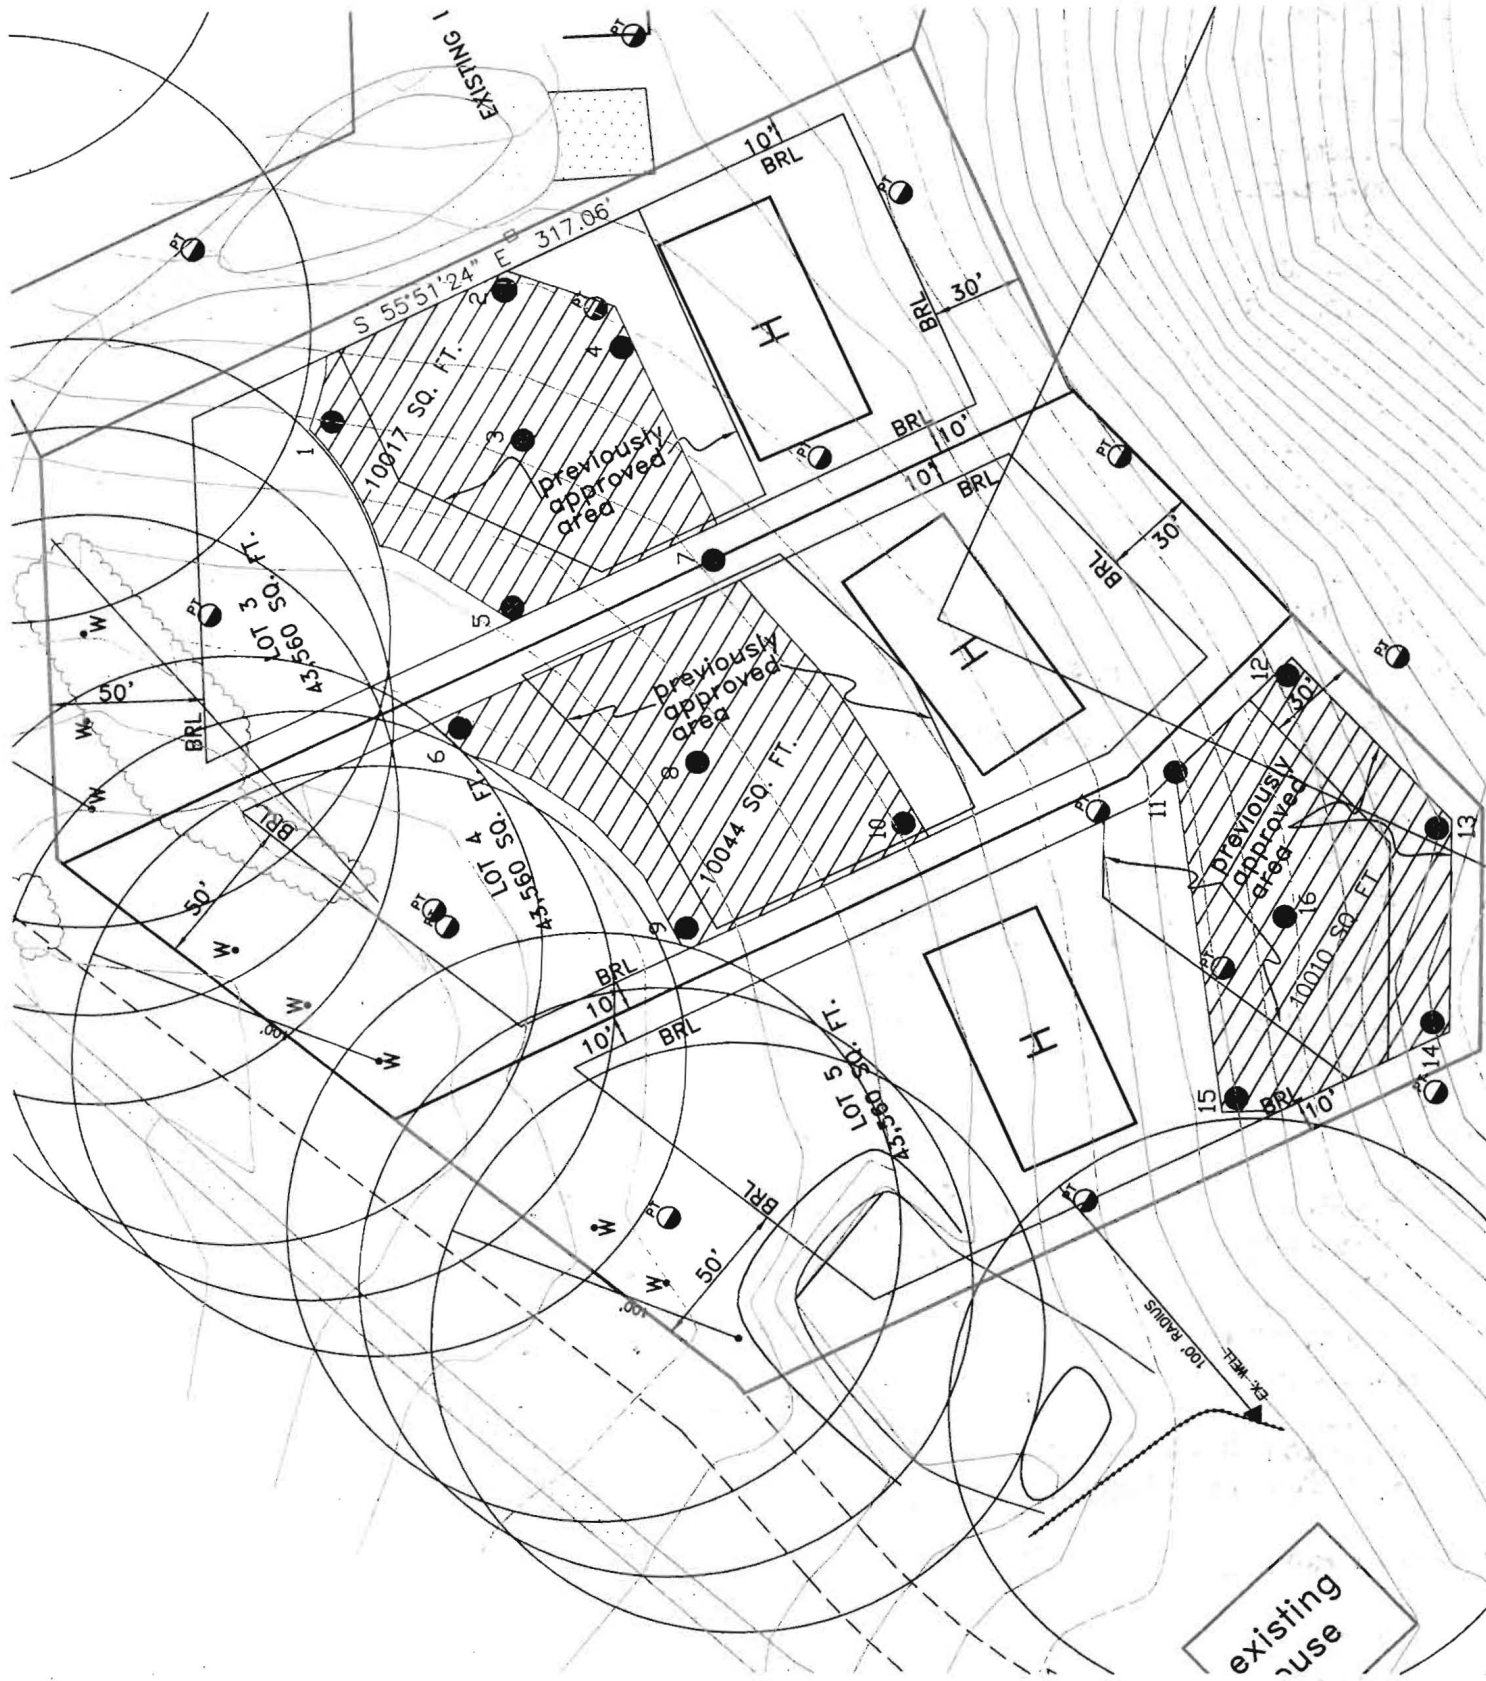

EXISTING 1

10' BRL

S 55°51'24" E 317.06'

10017 SQ. FT.

previously approved area

I

30' BRL

10' BRL

10' BRL

43,560 SQ. FT. LOT 3

50'

50'

50'

BRL

BRL

BRL

BRL

43,560 SQ. FT. LOT 4

10044 SQ. FT.

previously approved area

H

30' BRL

10' BRL

10' BRL

30' BRL

10' BRL

10' BRL

12

11

10

9

8

7

6

5

4

3

2

1

15

14

13

16

17

18

19

20

previously approved area

10010 SQ. FT.

10' BRL

10' BRL

EX-WELL
100' RADIUS

existing
house