

2/20/01 1pm LAYOUT
2/21/01 - PM
2/26/01 - am
2/27/01 - ASAP

PERMIT

SEWAGE DISPOSAL SYSTEM

HOWARD COUNTY HEALTH DEPARTMENT
BUREAU OF ENVIRONMENTAL HEALTH
410-313-2640

P 514932
A 49918-K
ISSUE DATE 2/13/2001
APPROVAL DATE 2/27/01

INDEXED RPS# 358872

Jim Boone _____ IS PERMITTED TO INSTALL ALTER _____

ADDRESS 190 Camp Harmison Drive, Berkley Springs WV 25411 PHONE 304-258-2152
SUBDIVISION Royal Hollow LOT NUMBER 13 ADDRESS 16004 Lady Camarin Court
PROPERTY OWNER Larry & Samantha Thompson PROPERTY OWNER'S ADDRESS 3702 Bonny Bride Place
SEPTIC TANK CAPACITY 1250 GALLONS Ellicott City, MD 21043
PUMP CHAMBER CAPACITY N/A GALLONS LAYOUT INSPECTION REQUIRED PRIOR TO SEPTIC
NUMBER OF BEDROOMS 4 TANK PLACEMENT
SQUARE FEET PER BEDROOM 210
LINEAR FEET OF TRENCH REQUIRED 210

TRENCHES: Trenches to be 2 feet wide. Inlet 3.5 feet below original grade. Bottom maximum depth
7.5 feet below original grade. 4 feet of stone below distribution box.
LOCATION: Place the distribution box 50 feet from left (386') lot line and 140 feet from
rear (125') lot line as viewed from Lady Camarin Court. Install trenches on contour in
both directions away from distribution box.

BUILDING PERMIT SIGNED AND RETURNED

0-403 B00142247-FINISH BASEMENT

PLANS APPROVED Amy McMillen OR SRU 8/13/00 DATE 7/24/2000


PERMIT VOID AFTER 2 YEARS

- NOTE: CONTRACTOR RESPONSIBLE FOR SCHEDULING A PRE-CONSTRUCTION INSPECTION FOR ALL INSTALLATIONS
- NOTE: TOP OF SEPTIC TANKS ARE TO BE NO DEEPER THAN 3.0 FEET BELOW FINISH GRADE
- NOTE: WATERTIGHT SEPTIC TANKS REQUIRED
- NOTE: CLEANOUT REQUIRED EVERY 70 FEET OF SEWER LINE AND/OR AT 90° SWEEPS IN LINES FROM HOUSE TO DRAIN FIELDS, 90° ELBOWS ARE NOT ACCEPTABLE
- NOTE: ALL PARTS OF SEPTIC SYSTEMS (I.E. TANK, DISTRIBUTION BOX, DRAINFIELDS) TO BE 100 FEET FROM ANY WATER WELL UNLESS OTHERWISE SPECIFICALLY AUTHORIZED
- NOTE: NO ABSORPTION TRENCH TO EXCEED 100 FEET IN LENGTH UNLESS SPECIFICALLY AUTHORIZED
- NOTE: ALL PIPE FROM HOUSE TO SEPTIC TANK MUST BE CAST IRON OR SCHEDULE 35/40 PVC OR ABS
- NOTE: MANHOLE RISERS REQUIRED ON ALL SEPTIC TANKS AND PUMP CHAMBERS
- NOTE: DISTRIBUTION BOXES MUST HAVE BAFFLES
- NOTE: IF PUMPED SEPTIC SYSTEM REQUIRED, (1) SEPTIC PUMP DETAIL TO BE PROVIDED BY INSTALLER PRIOR TO ISSUANCE OF SEPTIC PERMIT (2) PUMP PERFORMANCE TEST IS NECESSARY PRIOR TO HEALTH DEPARTMENT APPROVAL OF SEPTIC PERMIT

NEITHER THE HOWARD COUNTY COUNCIL NOR THE HEALTH DEPARTMENT IS RESPONSIBLE FOR THE
SUCCESSFUL OPERATION OF ANY SYSTEM
PERMITTEE RESPONSIBLE FOR OBTAINING FINAL APPROVAL ON THIS PERMIT
CALL 410-313-2640 FOR INSPECTION OF SEPTIC SYSTEM

514932

NOT TO SCALE

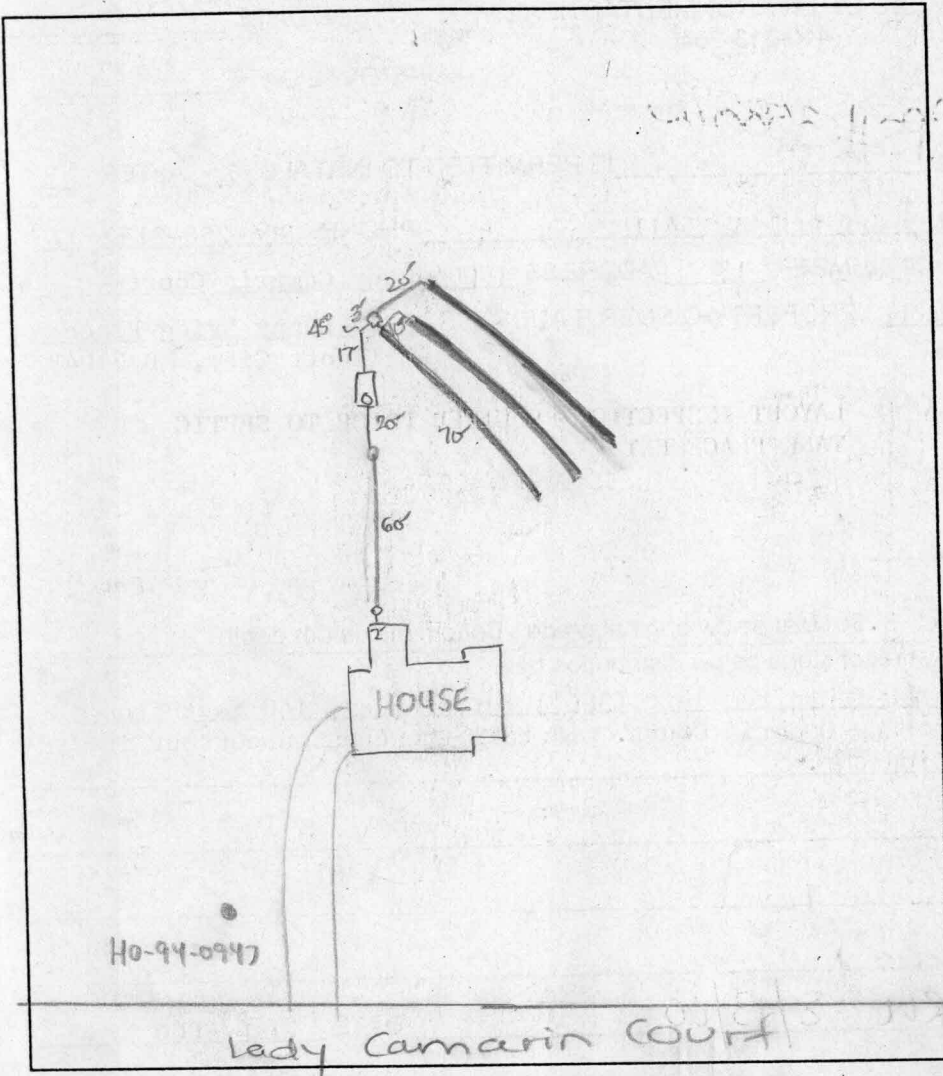

TRENCH DATA

TRENCH WIDTH 2
 TRENCH INLET DEPTH 3.5
 TRENCH BOTTOM DEPTH 7.5
 DEPTH OF STONE 4
 NUMBER OF TRENCHES 3
 TOTAL TRENCH LENGTH 210
 ABSORBENT AREA 840
 DISTRIBUTION BOX LEVEL
 BAFFLE IN DISTRIBUTION BOX

SEPTIC TANK DATA

SEPTIC TANK 1250 GALLONS
 MANHOLE RISER N/A
 6 INCH INSPECTION PORT

PUMP CHAMBER DATA

~~PUMP CHAMBER GALLONS _____
 MANHOLE RISER _____
 ALARM _____
 PUMP PERFORMANCE TEST _____~~

PRE-CONSTRUCTION INSPECTION: 2/20/01 layout confirmed - SDA staked -

OK to run trenches in one direction. DKC

INSPECTION COMMENTS: 2/21/01 - NO ONE PRESENT, NO WORK DONE - (SRK)

2/26/01 A.M. OK to cover from house to septic tank and first trench. Need to install 6" cleanout on septic tank. DKC

2/27/01 FINAL INSP - OK to cover all septic work. DKC

INSPECTOR DKC

DATE SYSTEM APPROVED 2/27/01