

APPLICATION

PERCOLATION TESTING

A _____

P _____

HOWARD COUNTY HEALTH DEPARTMENT
BUREAU OF ENVIRONMENTAL HEALTH
3525-H ELLICOTT MILLS DRIVE/ELLICOTT CITY, MARYLAND 21043
TELEPHONE: 313-2640

DISTRICT _____

DATE 8/5/95

TO: THE COUNTY HEALTH OFFICER
ELLICOTT CITY, MARYLAND

I HEREBY APPLY FOR THE NECESSARY TEST PRIOR TO APPLICATION FOR PERMIT TO CONSTRUCT (OR RECONSTRUCT) A SEWAGE DISPOSAL SYSTEM.

PROPERTY OWNER Feaga Family

ADDRESS _____ PHONE _____

AGENT OR PROSPECTIVE BUYER Land Marketing Inc. c/o Tim Feaga

ADDRESS 3243 Bethany Lane Ellicott City 21042 PHONE 313-8808

PROPERTY LOCATION:

SUBDIVISION Feaga Property LOT NO. 82 86 30

ROAD AND DESCRIPTION Rt 144 + Folly Quarter Rd

TAX MAP 16 + 23 PARCEL # 34 + 63

SIZE OF LOT 1 acre +/- TYPE BLDG. SFD
(SINGLE FAMILY DWELLING OR COMMERCIAL)

THE SYSTEM INSTALLED UNDER THIS APPLICATION IS ACCEPTABLE ONLY UNTIL PUBLIC FACILITIES BECOME AVAILABLE. I FULLY UNDERSTAND THE FEE CONNECTED WITH THE FILING OF THIS PERC TEST APPLICATION IS NON-REFUNDABLE UNDER ANY CIRCUMSTANCES. I ALSO AGREE TO COMPLY WITH ALL M.O.S.H.A. REQUIREMENTS IN TESTING THIS LOT. Mark A. Reil
(SIGNATURE OF APPLICANT)

APPROVED BY _____ FOR _____ DATE _____

DISAPPROVED BY _____ FOR _____ DATE _____

HOLD PENDING FURTHER TESTS _____

REASONS FOR REJECTION OR HOLDING _____

PERCOLATION TEST PLAT/PRELIMINARY PLAT - TITLE OR I.D. # _____ DATE _____

SITE DEVELOPMENT PLAN/FINAL PLAT - TITLE OR I.D. # _____ DATE _____


THIS IS NOT A PERMIT

COUNTY #


SOIL PROFILE
1260
1257 1258

0'
1.5'
2'
11.5'

lgt tan
clay
loam
reddish
pink
Salm
micaceous
very
decayed
Shale
25%

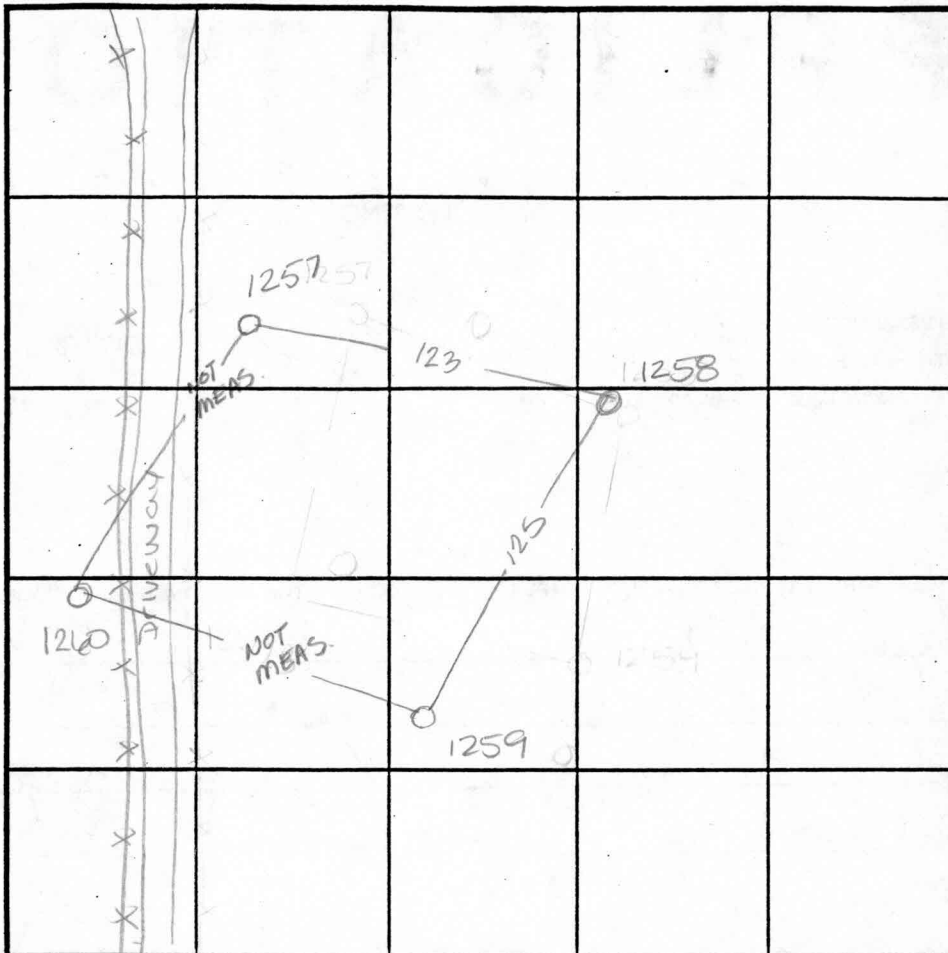

SOIL PROFILE

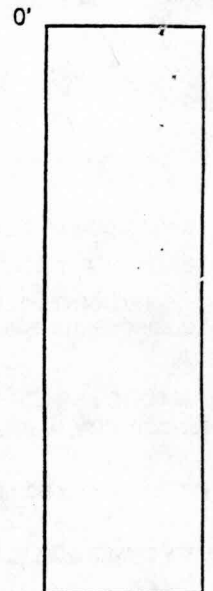

1859
2.5'
12'
orange
brn
SiCLM
reddish
pink
Salm
horizontal
layers
of white
decayed
quartzite

INDICATE NORTH - NAME ADJOINING ROADWAY AS BASE LINE. MD RT 144

DATE	TEST NO.	DEPTH	PRE-WET		TEST - 1" DROP		TIME
			START	STOP	START	STOP	
9-19-95	1257	2.5 VIII'	12:12	12:15	12:15	12:20	5min
	1258	2.5 VII	1:25	1:26	1:26	1:27	1min
	1259	4.5 VII	1:27	1:28 ³⁰	1:28 ³⁰	1:33	4 1/2 min
	1260	Visual	to 120 - see profile		-		OK

REMARKS _____

TYPE OF SOIL _____


TESTED BY Amy McMillan ALSO PRESENT Mark Reich

TRENCH DESIGN DATA: AVERAGE PERCOLATION TIME _____ TRENCH WIDTH _____

INLET DEPTH _____ MAXIMUM BOTTOM DEPTH _____ SQ. FT./BEDROOM _____

MARYLA

See Note 26, Sheet No. 1
To Be Dedicated To
Home Owners
Association

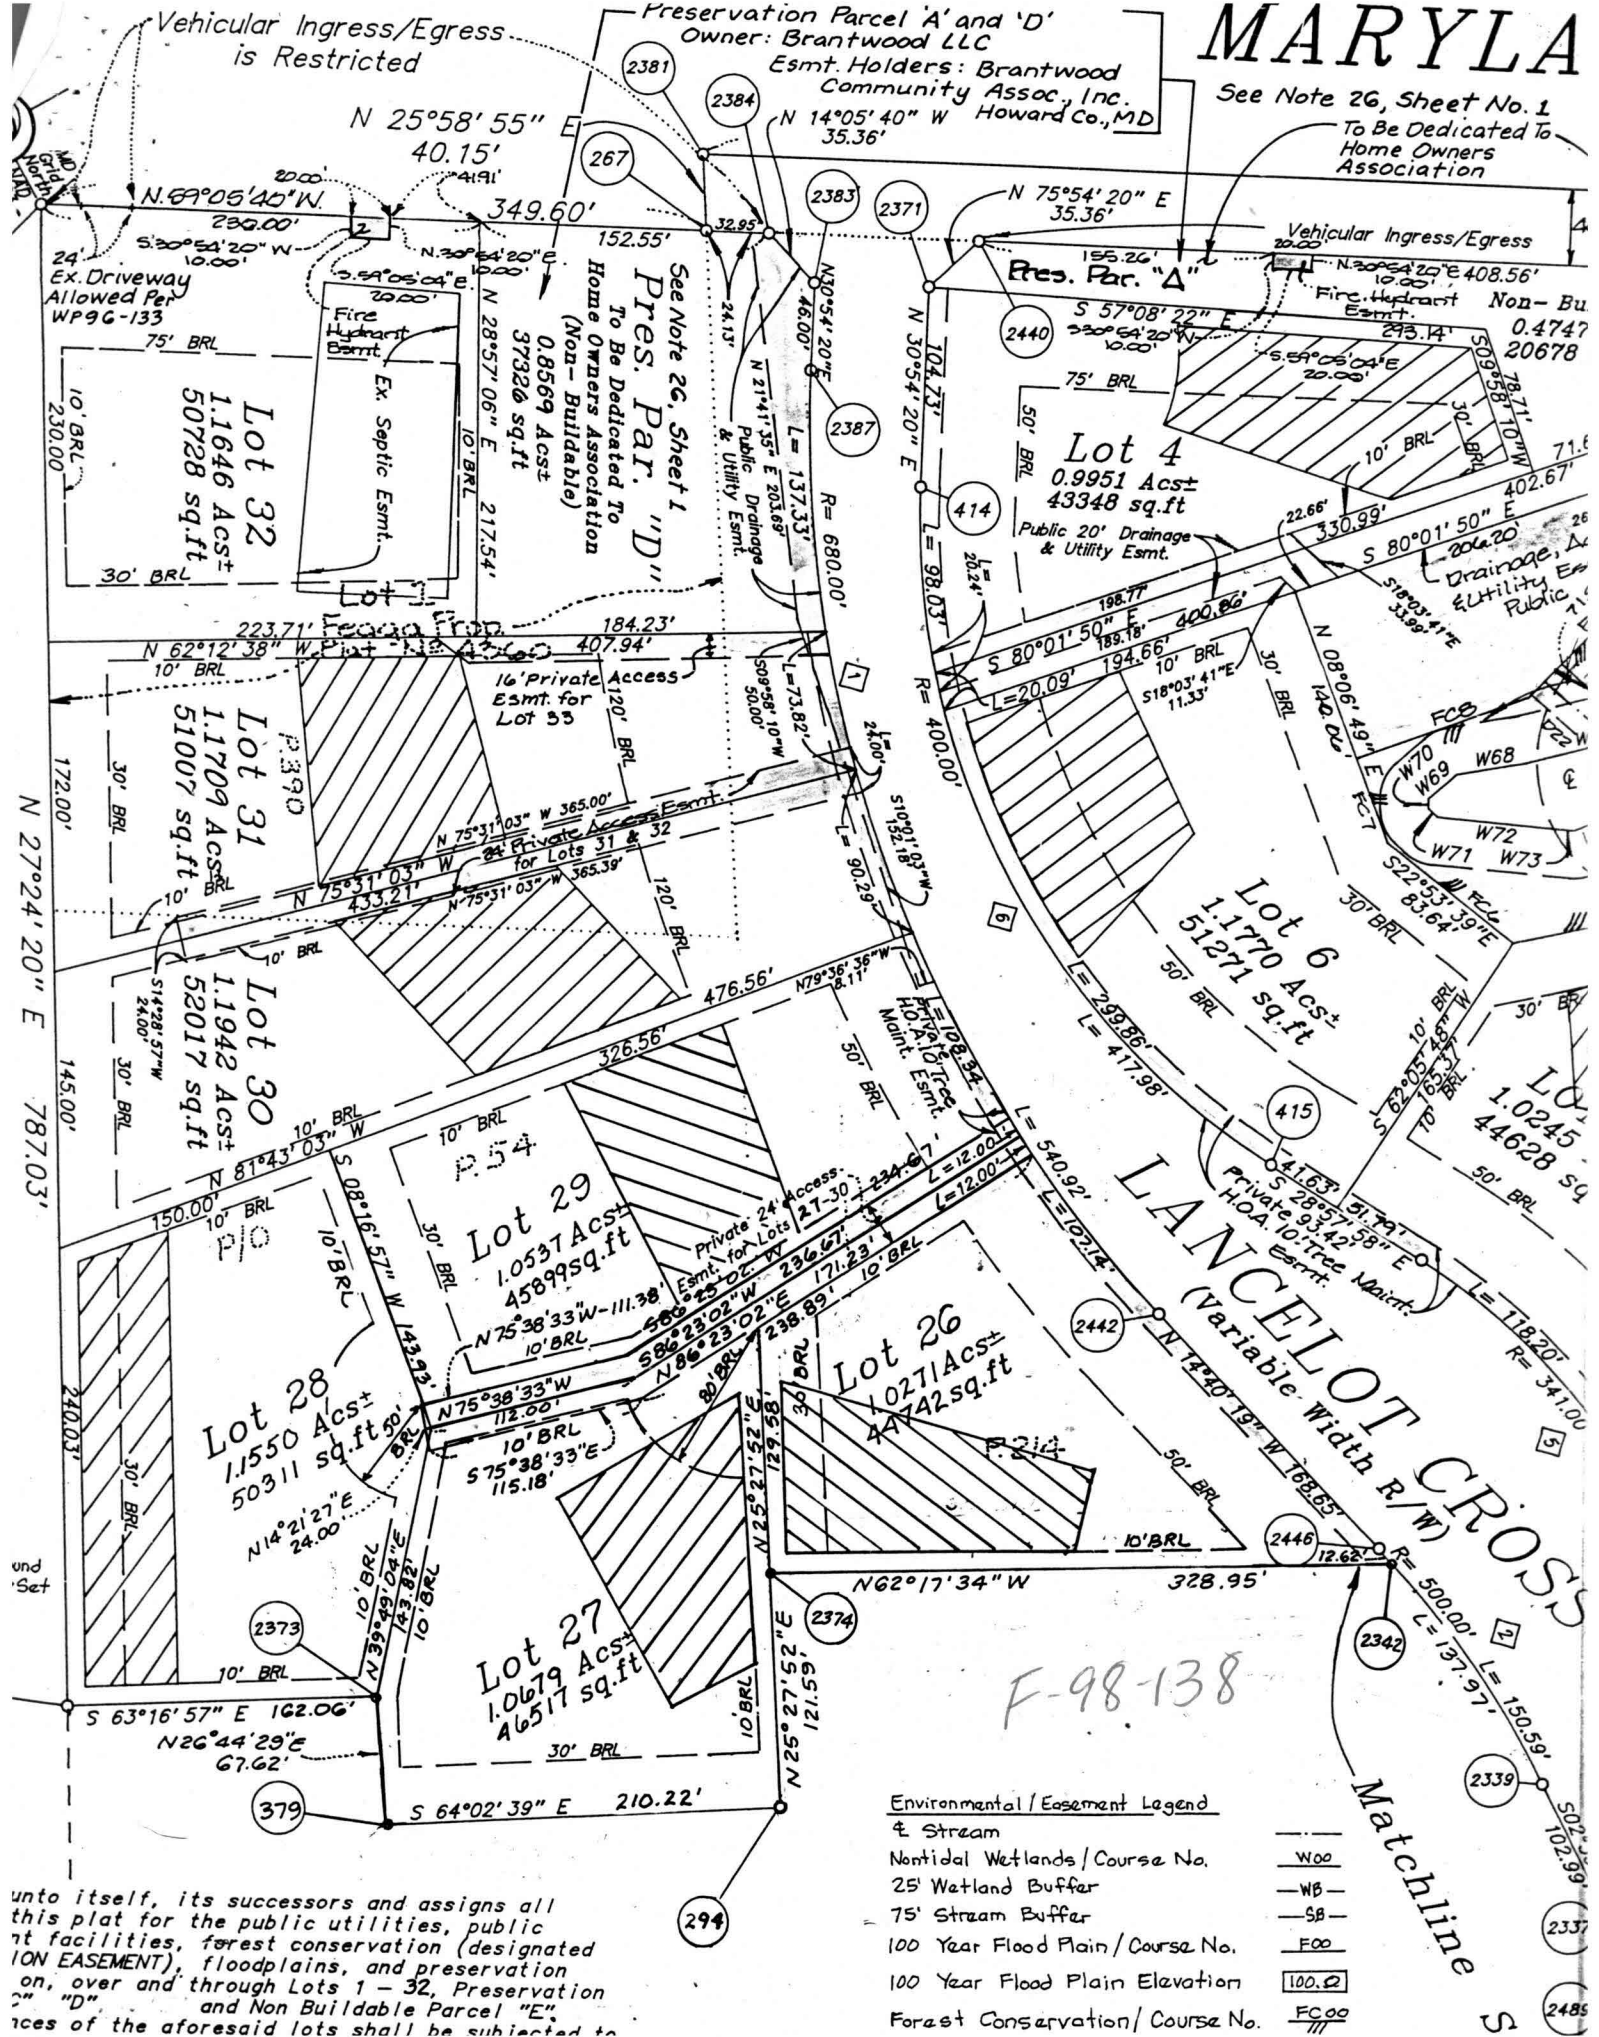

unto itself, its successors and assigns all this plat for the public utilities, public facilities, forest conservation (designated NON EASEMENT), floodplains, and preservation on, over and through Lots 1 - 32, Preservation and Non Buildable Parcel "E". The covenants of the aforesaid lots shall be subjected to

Environmental/Easement Legend

- Stream ---
- Nontidal Wetlands/Course No. W00
- 25' Wetland Buffer -WB-
- 75' Stream Buffer -SB-
- 100 Year Flood Plain/Course No. F00
- 100 Year Flood Plain Elevation 100.0
- Forest Conservation/Course No. FC00

F-98-138

Matchline

2339
2337
2485