

2/01
out
811
01

ISSUE DATE: 8/24/2001
APPROVAL DATE: 9/27/01

PERMIT INDEXED

P 516001
A 50830-BB

ON-SITE SEWAGE DISPOSAL SYSTEM HOWARD COUNTY HEALTH DEPARTMENT BUREAU OF ENVIRONMENTAL HEALTH

03-330761

South Carroll Backhoe, Inc IS PERMITTED TO INSTALL ALTER

ADDRESS: 4410 Salem Bottom Road, Westminster PHONE NUMBER: 410-875-4197
SUBDIVISION: Brantwood I LOT NUMBER: 29

ADDRESS: 3016 Lancelot Cross PROPERTY OWNER: NVHomes

SEPTIC TANK CAPACITY (GALLONS): 1250
PUMP CHAMBER CAPACITY (GALLONS): N/A
NUMBER OF BEDROOMS: 4
SQUARE FEET PER BEDROOM: 180
LINEAR FEET OF TRENCH REQUIRED: 180

| | |
|-----------|---|
| TRENCHES: | Trench to be 2.0 feet wide. Inlet 3.0 feet below original grade. Bottom maximum depth 7.0 feet below original grade. Effective area begins at 3.0 feet below original grade. 4.0 feet of stone below distribution pipe. |
| LOCATION: | Begin trenches <u>190</u> feet up the right lot line and 70 feet off that same lot line as seen when facing the lot from Lancelot Cross. Run 3, 60 foot trenches on contour in both directions. |
| NOTES: | |

PLANS APPROVED: Amy Mc Millen 5/22/01 OK BE DATE: 5-11-01

- NOTE: PERMIT VOID AFTER 2 YEARS
- NOTE: CONTRACTOR RESPONSIBLE FOR SCHEDULING A PRE-CONSTRUCTION INSPECTION FOR ALL INSTALLATIONS
- NOTE: WATERTIGHT SEPTIC TANKS REQUIRED
- NOTE: ALL PARTS OF SEPTIC SYSTEM SHALL BE 100 FEET FROM ANY WATER WELL
- NOTE: MANHOLE RISERS REQUIRED ON ALL SEPTIC TANKS AND PUMP CHAMBERS


NEITHER THE HOWARD COUNTY COUNCIL NOR THE HEALTH DEPARTMENT IS RESPONSIBLE FOR THE SUCCESSFUL OPERATION OF ANY SYSTEM PERMITTEE RESPONSIBLE FOR OBTAINING FINAL APPROVAL ON THIS PERMIT CALL 410-313-2640 FOR INSPECTION OF SEPTIC SYSTEM

BUILDING PERMIT SIGNED AND RETURNED
8-15-01
4/7/04 B00138604 - DECK W/ HOT TUB
5/26/04 B00147301 - IG POOL
4/13/07 B07001253 - Finish Basement

P 10001

NOT TO SCALE

INDEXED

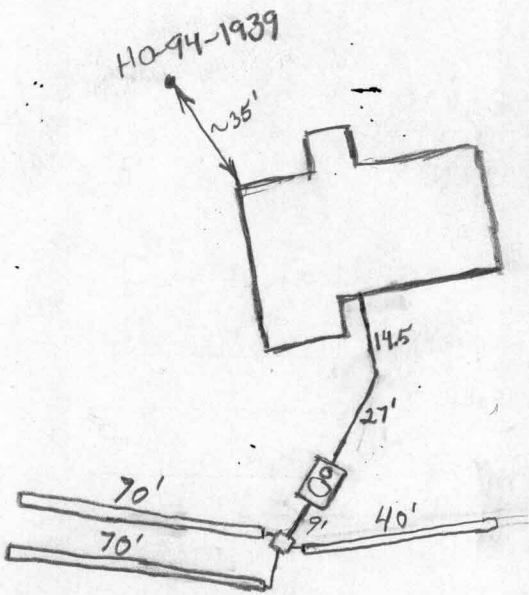

TRENCH DATA

TRENCH WIDTH 3'
 TRENCH INLET DEPTH 3'
 TRENCH BOTTOM DEPTH 7'
 DEPTH OF STONE 4'
 NUMBER OF TRENCHES 3
 TOTAL TRENCH LENGTH 180'
 ABSORBENT AREA 720 sq ft
 DISTRIBUTION BOX LEVEL yes
 BAFFLE IN DISTRIBUTION BOX yes

SEPTIC TANK DATA

SEPTIC TANK 1250 TS GALLONS
 MANHOLE RISER Yes
 6 INCH INSPECTION PORT Yes

PUMP CHAMBER DATA N/A

~~PUMP CHAMBER GALLONS _____~~
~~MANHOLE RISER _____~~
~~ALARM _____~~
~~PUMP PERFORMANCE TEST _____~~

Lancelot

PRE-CONSTRUCTION INSPECTION: Cross 9/12/01 To install as per B.P. plan.

Part of easement lost due to location of septic tank. O.K. (BB)

INSPECTION COMMENTS: 9/13/01 Had house connection for final approval.

O.K. to cover. (BB) 9/27/01- HOUSE CONN. VERIFIED TO HAVE BEEN MADE.

THRY T/C W/BUILDER (ROB - SUPERINTENDENT OF NV) - (SRR)

BUILDING PERMIT SIGNED

INSPECTOR Steven R. Krieg

DATE SYSTEM APPROVED 9/27/01