

C 1 14517

SEQUENCE NO. (MDE USE ONLY)

STATE OF MARYLAND WELL COMPLETION REPORT

THIS REPORT MUST BE SUBMITTED WITHIN 45 DAYS AFTER WELL IS COMPLETED.

COUNTY NUMBER 510158

(THIS NUMBER IS TO BE PUNCHED IN COLS. 3-6 ON ALL CARDS)

ST/CO USE ONLY DATE RECEIVED

DATE WELL COMPLETED 07 08 02

Depth of Well 22 300 26 (TO NEAREST FOOT)

PERMIT NO. FROM "PERMIT TO DRILL WELL" HO-94-3405

OWNER Huber STREET OR RFD 4078 Roxbury Mill Rd TOWN Glenwood SUBDIVISION NA SECTION LOT

WELL LOG table with columns: DESCRIPTION, FEET (FROM, TO), check if water bearing. Includes entries for Red Clay, Wet Silty sand, gravel, and rock encountered.

GROUTING RECORD form with fields for WELL HAS BEEN GROUTED, TYPE OF GROUTING MATERIAL (CEMENT, BENTONITE CLAY), NO. OF BAGS, NO. OF POUNDS, GALLONS OF WATER, DEPTH OF GROUT SEAL.

CASING RECORD form with fields for casing types (STEEL, CONCRETE, PLASTIC, OTHER), MAIN CASING TYPE, Nominal diameter, Total depth.

OTHER CASING (if used) form with fields for diameter, depth.

SCREEN RECORD form with fields for screen type (STEEL, BRASS, BRONZE, PLASTIC, OPEN HOLE, OTHER), DEPTH (nearest ft.).

NUMBER OF UNSUCCESSFUL WELLS: none. WELL HYDROFRACTURED: Y.

CIRCLE APPROPRIATE LETTER A, E, P. A WELL WAS ABANDONED AND SEALED WHEN THIS WELL WAS COMPLETED. ELECTRIC LOG OBTAINED. TEST WELL CONVERTED TO PRODUCTION WELL.

I HEREBY CERTIFY THAT THIS WELL HAS BEEN CONSTRUCTED IN ACCORDANCE WITH COMAR 26.04.04 "WELL CONSTRUCTION" AND IN CONFORMANCE WITH ALL CONDITIONS STATED IN THE ABOVE CAPTIONED PERMIT...


DRILLERS NO. 1336. DRILLERS SIGNATURE (Michael W. Huber). LIC. NO. 1 D

Table with columns for casing height (A, C, H, S, R, E, N) and slot size (1, 2, 3). Includes diameter of screen (56, 60) and gravel pack information.

MDE USE ONLY (NOT TO BE FILLED IN BY DRILLER) form with fields for T, W, Q, TELESCOPE CASING, LOG INDICATOR, OTHER DATA.

PUMPING TEST form with fields for HOURS PUMPED, PUMPING RATE, METHOD USED TO MEASURE PUMPING RATE, WATER LEVEL (before and when pumping), TYPE OF PUMP USED.

PUMP INSTALLED form with fields for DRILLER INSTALLED PUMP, TYPE OF PUMP INSTALLED, CAPACITY: GALLONS PER MINUTE, PUMP HORSE POWER, PUMP COLUMN LENGTH, CASING HEIGHT.

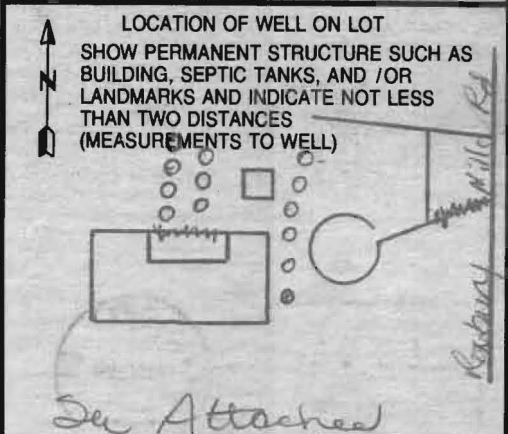

B 1 7495  
2 3 6

SEQUENCE NO.  
(MDE USE ONLY)

STATE OF MARYLAND  
PERMIT TO DRILL WELL

STATE PERMIT NUMBER

HO-94-3405

fill in this form completely

W51676 Please print or type.

Date Received (APA)

05 06 02

OWNER INFORMATION

8 MM DD YY 13

Huber

15 Last Name Owner First Name 34

4078 Roxbury Mill Road

36 Street or RFD 55

Glenwood, MD 20833

57 Town 70 State 72 Zip 76

DRILLER INFORMATION

Michael W. Huber

M W D 336

76 License No. 81

CHESAPEAKE GEOSYSTEMS, INC.

Firm Name

6720 Ft. Smallwood Rd Balto., MD 21226

Address

5/2/02

Signature

Date

WELL INFORMATION

APPROX. PUMPING RATE  
(GAL. PER MIN.)

NA

8 12

AVERAGE DAILY QUANTITY NEEDED  
(GAL. PER DAY)

NA

14 20

USE FOR WATER (CIRCLE APPROPRIATE BOX)

- D DOMESTIC POTABLE SUPPLY & RESIDENTIAL IRRIGATION
- F FARMING (LIVESTOCK WATERING & AGRICULTURAL IRRIGATION)
- I INDUSTRIAL, COMMERCIAL, DEWATERING
- P PUBLIC WATER SUPPLY WELL
- T TEST, OBSERVATION, MONITORING
- G GEO-THERMAL Vertical (Closed) 12 bores

B 3

LOCATION OF WELL

Howard

8 COUNTY 21

23 SUBDIVISION 42

SECTION 44 46

LOT 48 50


Glenwood

52 NEAREST TOWN 71

MILES FROM TOWN (enter 0 if in town) 0  
73 76 77 78

B 4

1 2  
DIRECTION OF WELL FROM TOWN (CIRCLE BOX)

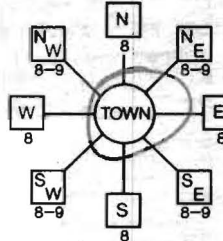

4078 Roxbury Mills Road

11 NEAR WHAT ROAD 30

ON WHICH SIDE OF ROAD (CIRCLE APPROPRIATE BOX)



34 600 37  
DISTANCE FROM ROAD FT

ENTER FT OR MI 38 39

TAX MAP: 21 BLK: 8 PARCEL 13

NOT TO BE FILLED IN BY DRILLER  
HEALTH DEPARTMENT APPROVAL

Howard

510158

COUNTY NAME

COUNTY NO.

STATE SIGNATURE

INSERT S

DATE ISSUED

41

05 23 02

Steven R. King

05 23 03

43 MM DD YY 48

CO SIGNATURE

EXP. DATE

NORTH GRID 520 0 0 0  
50 55

EAST GRID 784 0 0 0  
57 63

APPROXIMATE DEPTH OF WELL 400 FEET  
24 28

APPROXIMATE DIAMETER OF WELL 1 INCH NEAREST INCH

METHOD OF DRILLING (circle one)

BORED (or Augered) JETTED Jetted & DRIVEN

30 AIR-ROtary AIR-PERcussion ROTARY (Hydraulic Rotary)

37 CABLE REVerse-ROtary DRive-POINT

other

REPLACEMENT OR DEEPEMED WELLS  
(CIRCLE APPROPRIATE BOX)

- N THIS WELL WILL NOT REPLACE AN EXISTING WELL
- Y THIS WELL WILL REPLACE A WELL THAT WILL BE ABANDONED AND SEALED
- S THIS WELL WILL REPLACE A WELL THAT WILL BE USED AS A STANDBY-CONTACT LOCAL APPROVING AUTHORITY FOR POLICY ON STANDBY WELLS
- D THIS WELL WILL DEEPEM AN EXISTING WELL

PERMIT NUMBER OF WELL TO BE REPLACED OR DEEPEMED (IF AVAILABLE) 41 52

Not to be filled in by driller (MDE OR COUNTY USE ONLY)

APPROP. PERMIT NUMBER

PERMIT No. HO-94-3405  
70 71 72 73 74 75 76 77 78 79

SPECIAL CONDITIONS

Attach well tag to heating unit

SHOW MAJOR FEATURES OF BOX & LOCATE WELL WITH AN X

SOURCES OF DRILLING WATER


- 1.
- 2.
- 3.

WRITE THE BOX NUMBER FROM THE MAP HERE

E 784  
N 520

DRAW A SKETCH BELOW SHOWING LOCATION OF WELL IN RELATION TO NEARBY TOWNS AND ROADS AND GIVE DISTANCE FROM WELL TO NEAREST ROAD JUNCTION

N

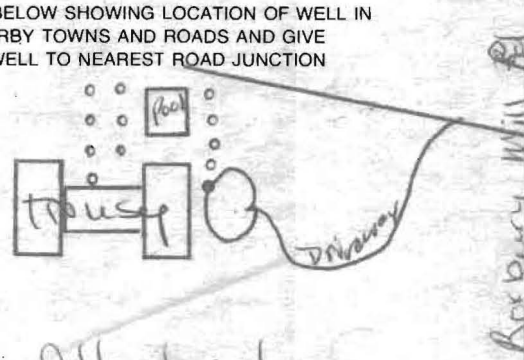

See Attached



E TENNIS  
COURT

DISTRIBUTION BOX  
EX. GROUND=483.0  
INV. OUT=480.0

PROPOSED 10,000 SQ. FT.  
PRIVATE SEWAGE DISPOSAL  
CARETAKERS HOUSE

DISTRIBUTION BOX  
EX. GROUND=485.0  
INV. OUT=482.0

PROPOSED 20,000 SQ. FT.  
PRIVATE SEWAGE DISPOSAL  
MANOR HOUSE

EX. DRIVEWAY

MIB2

EXISTING  
SEPTIC EASEMENT  
APPROVED 12/...

EXISTING  
WELL

EXISTING  
DWELLING

EX.  
POOL

EX.  
SHED

MIB2

