

Building Address: 105 E. Lincoln Rd. #200
 Suite/Apt. #: _____ SDP/WP/BA #: _____
 Census Tract: _____ Subdivision: _____
 Section: _____ Area: _____ Lot: 85
 Tax Map: 100 Parcel: 114 Grid: 21
 Zoning: _____ Map Coordinates: _____ Lot Size: 3,000

Existing Use: Warehouse
 Proposed Use: Warehouse
 Estimated Construction Cost: \$ 1,500,000
 Description of Work: Warehouse expansion and interior finish

Occupant or Tenant: _____
 Was tenant space previously occupied? Yes No
 Contact Name: _____
 Address: _____
 City: _____ State: _____ Zip Code: _____
 Phone: _____ Fax: _____
 Email: _____

Property Owner's Name: 105 E. Lincoln Rd. #200
 Address: _____
 City: _____ State: VA Zip Code: 22161
 Home Phone: 703-297-1592 Work Phone: _____
 Applicant's Name & Mailing Address, (If other than stated herein):

 Phone: 703-297-1592 Fax: _____
 Email: 105el@comcast.net

Contractor Company: Central Building Co. Inc.
 Contact Person: Michael J. Smith
 Address: 1570 N. Lee St. #100
 City: Leesville, VA State: VA Zip Code: 22111
 License No.: 1151-1166
 Phone: 703-297-1592 Fax: _____
 Email: _____

Engineer/Architect Company: _____
 Responsible Design Prof.: _____
 Address: _____
 City: _____ State: _____ Zip Code: _____
 Phone: _____ Fax: _____
 Email: _____

BUILDING DESCRIPTION - COMMERCIAL

Building Characteristics	Utilities
Height:	<u>Water Supply</u>
No. of stories:	<input type="checkbox"/> Public
Gross area, sq. ft./floor:	<input type="checkbox"/> Private
	<u>Sewage Disposal</u>
Area of construction (sq. ft.):	<input type="checkbox"/> Public
	<input type="checkbox"/> Private
Use group:	Electric: <input type="checkbox"/> Yes <input type="checkbox"/> No
	Gas: <input type="checkbox"/> Yes <input type="checkbox"/> No
Construction type:	Heating System
<input type="checkbox"/> Reinforced Concrete	<input type="checkbox"/> Electric <input type="checkbox"/> Oil
<input type="checkbox"/> Structural Steel	<input type="checkbox"/> Natural Gas <input type="checkbox"/> Propane Gas
<input type="checkbox"/> Masonry	Sprinkler System:
<input type="checkbox"/> Wood Frame	<input type="checkbox"/> N/A
<input type="checkbox"/> State Certified Modular	<input type="checkbox"/> Full
<input checked="" type="checkbox"/> Roadside Tree Project Permit	<input type="checkbox"/> Partial
<input type="checkbox"/> Yes <input type="checkbox"/> No	<input type="checkbox"/> Other Suppression
Roadside Tree Project Permit #	No. of Heads:

BUILDING DESCRIPTION - RESIDENTIAL

Building Characteristics	Utilities
<input type="checkbox"/> SF Dwelling <input type="checkbox"/> SF Townhouse	<u>Water Supply</u>
Depth Width	<input type="checkbox"/> Public
1 st floor: <u>26</u> <u>84</u>	<input type="checkbox"/> Private
2 nd floor: <u>52</u> <u>84</u>	<u>Sewage Disposal</u>
Basement: <u>62</u> <u>84</u>	<input type="checkbox"/> Public
<input type="checkbox"/> Finished Basement	<input type="checkbox"/> Private
<input type="checkbox"/> Unfinished Basement	Electric: <input type="checkbox"/> Yes <input type="checkbox"/> No
<input type="checkbox"/> Crawl Space	Gas: <input type="checkbox"/> Yes <input type="checkbox"/> No
<input type="checkbox"/> Slab on Grade	Heating System
No. of Bedrooms: <u>5</u>	<input type="checkbox"/> Electric
Multi-family Dwelling	<input type="checkbox"/> Oil
No. of efficiency units:	<input type="checkbox"/> Natural Gas
No. of 1 BR units:	<input type="checkbox"/> Propane Gas
No. of 2 BR units:	
No. of 3 BR units:	
Other Structure:	
Dimensions:	
Footings:	<input checked="" type="checkbox"/> Roadside Tree Project Permit
Roof:	<input type="checkbox"/> Yes <input type="checkbox"/> No
<input type="checkbox"/> State Certified Modular	Roadside Tree Project Permit #
<input type="checkbox"/> Manufactured Home	

THE UNDERSIGNED HEREBY CERTIFIES AND AGREES AS FOLLOWS: (1) THAT HE/SHE IS AUTHORIZED TO MAKE THIS APPLICATION; (2) THAT THE INFORMATION IS CORRECT; (3) THAT HE/SHE WILL COMPLY WITH ALL REGULATIONS OF HOWARD COUNTY WHICH ARE APPLICABLE THERETO; (4) THAT HE/SHE WILL PERFORM NO WORK ON THE ABOVE REFERENCED PROPERTY NOT SPECIFICALLY DESCRIBED IN THIS APPLICATION; (5) THAT HE/SHE GRANTS COUNTY OFFICIALS THE RIGHT TO ENTER ONTO THIS PROPERTY FOR THE PURPOSE OF INSPECTING THE WORK PERMITTED AND POSTING NOTICES.

Applicant's Signature: _____
 Email Address: _____
 Title/Company: _____

Print Name: _____
 Date: _____


Checks Payable to: DIRECTOR OF FINANCE OF HOWARD COUNTY
 PLEASE WRITE NEATLY & LEGIBLY
 -FOR OFFICE USE ONLY-

AGENCY	DATE	SIGNATURE OF APPROVAL
State Highways		
Building Officials		
PSZA (Zoning)		
PSZA (Engineering)		
Health	<u>6-23-11</u>	<u>D. Bevard</u>
Fire Protection		

DPZ SETBACK INFORMATION

Front: _____
 Rear: _____
 Side: _____
 Side St.: _____
 All minimum setbacks met? Yes No
 Is Entrance Permit Required? Yes No
 Historic District? Yes No
 Lot Coverage for New Town Zone: _____
 SDP/Red-line approval date: _____

Filing Fee	\$
Permit Fee	\$
Tech Fee	\$
Excise Tax	\$
PSFS	\$
Guaranty Fund	\$
Add'l per Fee	\$
Total Fees	\$
Sub- Total Paid	\$
Balance Due	\$

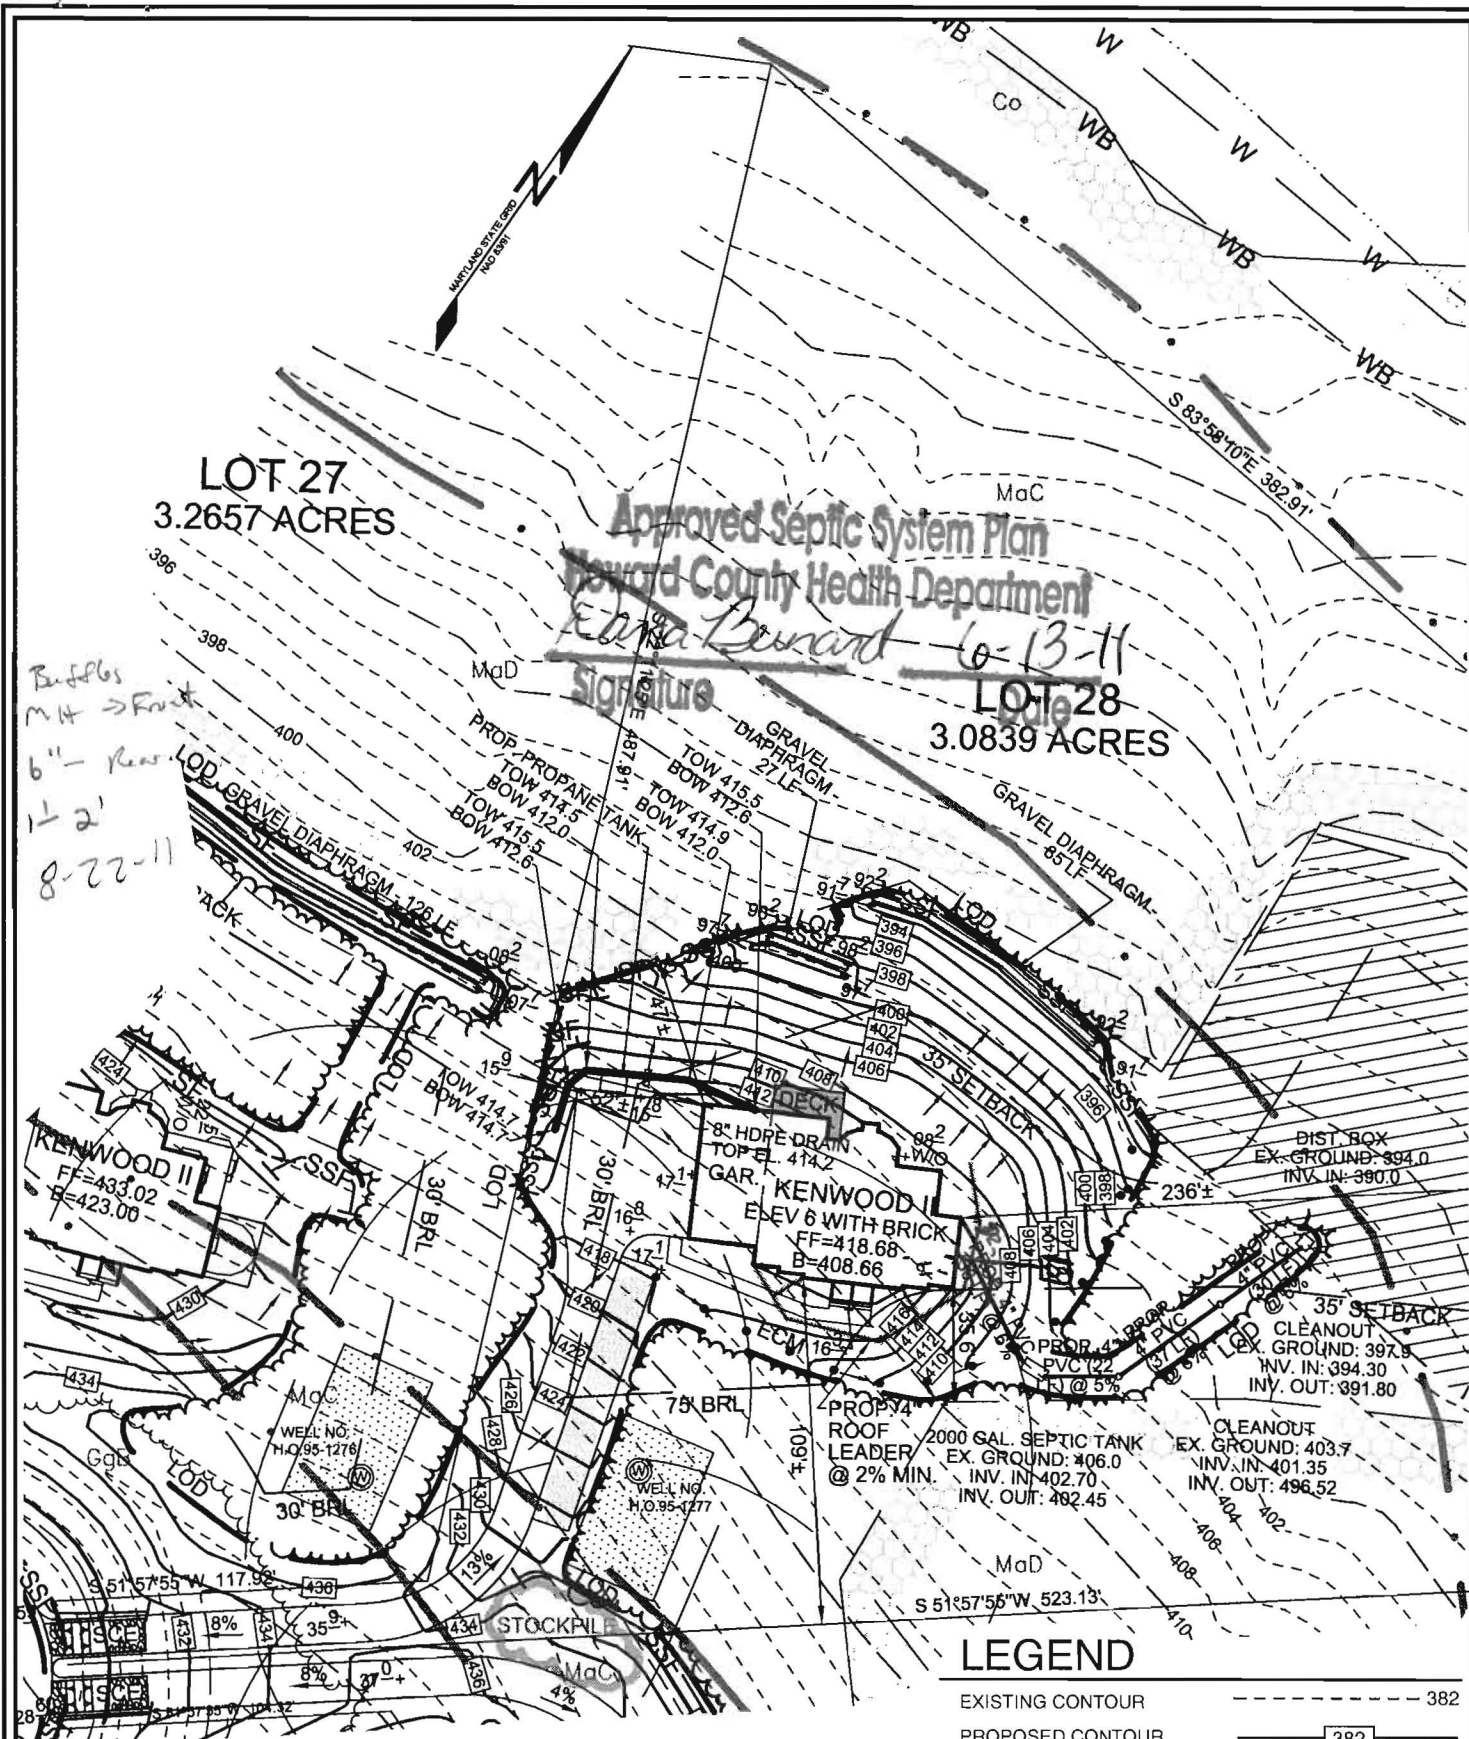

Sill · Adcock & Associates · LLC

Engineers · Surveyors · Planners
 3300 North Ridge Road, Suite 160
 Ellicott City, Maryland 21043
 Phone: 443.325.7682 Fax: 443.325.7685
 Email: info@saaland.com

DEVELOPER
CRAFTMARK HOMES
 6820 ELM STREET, SUITE 102
 MCLEAN, VIRGINIA 22101
 (703) 287-0582


OWNER
MAPLE W, LC
 5074 DORSEY HALL DRIVE, SUITE 205
 ELLICOTT CITY, MARYLAND 21042
 (410) 720-3021

DESIGN BY:	SJT
DRAWN BY:	SJT
CHECKED BY:	PS
SCALE:	1"=60'
DATE:	MAY 13, 2011
PROJECT #:	10-021
SHEET #:	1 OF 2

HOUSE SITE LIME KILN VALLEY II LOT 28 12913 LIME KILN ROAD

TAX MAPS 40 & 45 GRIDS 21 & 4
 FIFTH ELECTION DISTRICT

PARCELS 114 & 12
 HOWARD COUNTY, MARYLAND

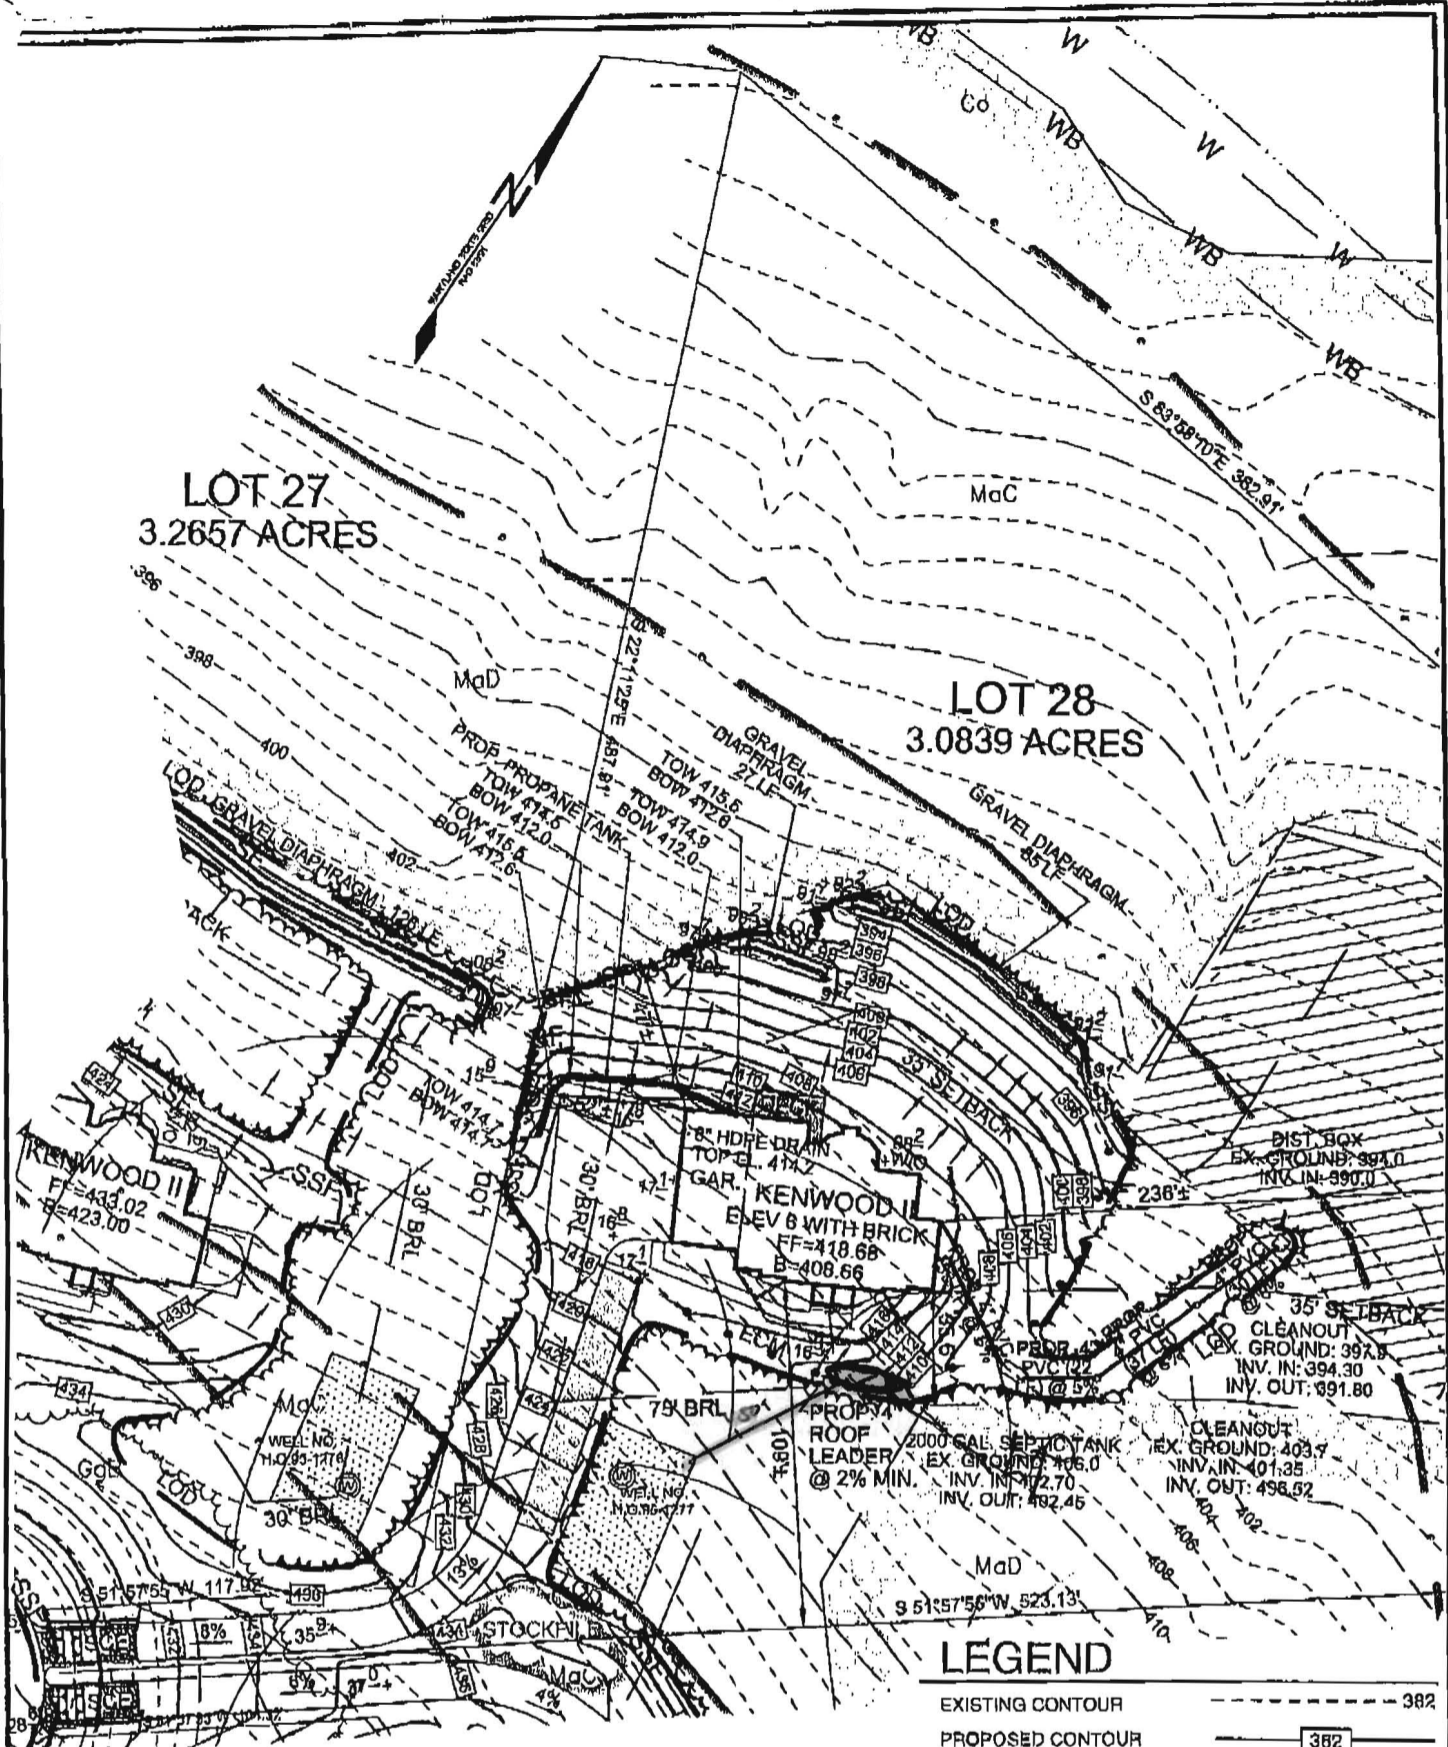

LOT 27
3.2657 ACRES

LOT 28
3.0839 ACRES

LEGEND

- EXISTING CONTOUR - - - - - 382
- PROPOSED CONTOUR ————— 382
- PROPOSED SPOT ELEVATION + 82.53
- DIRECTION OF FLOW →
- NON-ROOFTOP DISCONNECTION [Symbol]

- NOTE:
- 1) STORMWATER MANAGEMENT FOR THE THE HOUSE AND THE MAJORITY OF THE DRIVEWAY WILL BE SATISFIED BY SHEET FLOW TO CONSERVATION AREA WITH A GRAVEL DIAPHRAGM AND FOR THE FRONT PORTION OF THE DRIVEWAY BY THE EXISTING SWM FACILITY.
 - 2) DISTURBED AREA = 31,393 SQ.FT.
 - 3) EXISTING WELL (HO-96-1277) WAS FIELD LOCATED BY SILL, ADCKOCK, & ASSOCIATES, LLO IN JULY, 2010.
 - 4) 8" HDPE DRAIN TO HAVE 6" HDPE OUTLET PIPE @ 2% (2 LF) OR AN EQUIVALENT DRAIN & PIPE FOR Q OF 0.98 CFS CAN BE USED.

Sill · Adcock & Associates · LLC

Engineers · Surveyors · Planners
 3300 North Ridge Road, Suite 160
 Ellicott City, Maryland 21043
 Phone: 443.325.7682 Fax: 443.325.7685
 Email: info@saaland.com

DEVELOPER
 CRAFTMARK HOMES
 6820 ELM STREET, SUITE 102
 MCLEAN, VIRGINIA 22101
 (703) 287-0502

OWNER
 MAPLE W, LC
 5074 DORSEY HALL DRIVE, SUITE 205
 ELLICOTT CITY, MARYLAND 21042
 (410) 720-3021

DESIGN BY: SJT
 DRAWN BY: SJT
 CHECKED BY: PS
 SCALE: 1"=60'
 DATE: MAY 13, 2011
 PROJECT #: 10-021
 SHEET #: 1 OF 2

HOUSE SITE
LIME KILN VALLEY II
 LOT 28
 12913 LIME KILN ROAD

TAX MAPS 40 & 45 GRIDS 21 & 4
 FIFTH ELECTION DISTRICT
 PARCELS 114 & 12
 HOWARD COUNTY, MARYLAND



Howard County
Health Department

Bureau of Environmental Health
7178 Columbia Gateway Drive, Columbia MD 21046
(410) 313-2640 Fax (410) 313-2648
TDD (410) 313-2323 Toll Free 1-866-313-6300
website: www.hchealth.org

Peter L. Beilenson, M.D., M.P.H., Health Officer

October 24, 2011

Valley National Gases, Inc.
Bob Kilby
7201 Montevideo Road
Jessup, MD 20794

RE: **Waiver Approval**
12913 Lime Kiln Road

Dear Mr. Kilby,

The Health Department has received your waiver request dated October 16, 2011 for the above referenced property. This Health Department grants **approval** of the waiver on the basis that the propane tank has been located over fifty (50) feet from the well. Approval of the building permits will be granted by this Department provided that the site plans submitted with the building permit applications is consistent with this approval. Any deviations from this approval will be subject to further review by this Department.

Any questions regarding this decision may be directed to the Well and Septic Program of the Howard County Health Department.

Respectfully,

Michael J. Davis, R.S.
Assistant Director
Bureau of Environmental Health

10/16/11

Mr. Mike Davis
Howard County Health Department

Mr. Davis,

We are requesting a variance for Lot 28 (12913 Lime Kiln Rd Highland, Md. 20777). The lp gas tank will be placed in the only location that meets all requirements except the 100 foot from a well head. The lp gas tank will be well over 50 feet from the well head.

Your careful consideration of this matter would be greatly appreciated.

Thank you,

Bob Kilby
410-799-1114
Propane Manager
Valley National Gases, Inc.
7201 Montevideo Rd
Jessup, Md. 20794