

APPLICATION

PERCOLATION TESTING

A 57358 A

P _____

HOWARD COUNTY HEALTH DEPARTMENT
BUREAU OF ENVIRONMENTAL HEALTH
3525-H ELLICOTT MILLS DRIVE/ELLICOTT CITY, MARYLAND 21043
TELEPHONE: 313-2640

*previously ok
proposed
4 lot
subdivision*

DISTRICT _____

DATE _____

TO: THE COUNTY HEALTH OFFICER
ELLICOTT CITY, MARYLAND

I HEREBY APPLY FOR THE NECESSARY TEST PRIOR TO APPLICATION FOR PERMIT TO CONSTRUCT (OR RECONSTRUCT) A SEWAGE DISPOSAL SYSTEM.

PROPERTY OWNER Allen M. Brown

ADDRESS 4609 Linticum Rd Dayton Md PHONE 531-2658
21036

AGENT OR PROSPECTIVE BUYER Allen M. Brown

ADDRESS Linticum Rd Dayton Md PHONE 531-2658

PROPERTY LOCATION:

SUBDIVISION Allen M. Brown LOT NO. #1 #2 #3

ROAD AND DESCRIPTION _____

TAX MAP 28 PARCEL # 4

SIZE OF LOT _____ TYPE BLDG. Allen M. Brown
(SINGLE FAMILY DWELLING OR COMMERCIAL)

THE SYSTEM INSTALLED UNDER THIS APPLICATION IS ACCEPTABLE ONLY UNTIL PUBLIC FACILITIES BECOME AVAILABLE. I FULLY UNDERSTAND THE FEE CONNECTED WITH THE FILING OF THIS PERC TEST APPLICATION IS NON-REFUNDABLE UNDER ANY CIRCUMSTANCES. I ALSO AGREE TO COMPLY WITH ALL M.O.S.H.A. REQUIREMENTS IN TESTING THIS LOT. Allen M. Brown
(SIGNATURE OF APPLICANT)

APPROVED BY _____ FOR _____ DATE _____

DISAPPROVED BY _____ FOR _____ DATE _____

HOLD PENDING FURTHER TESTS _____

REASONS FOR REJECTION OR HOLDING _____

PERCOLATION TEST PLAT/PRELIMINARY PLAT - TITLE OR I.D. # _____ DATE _____

SITE DEVELOPMENT PLAN/FINAL PLAT - TITLE OR I.D. # _____ DATE _____





THIS IS NOT A PERMIT

A57358A - LOT 1


Holes 7, 8, 9, 10, 11

COUNTY #

SOIL PROFILE

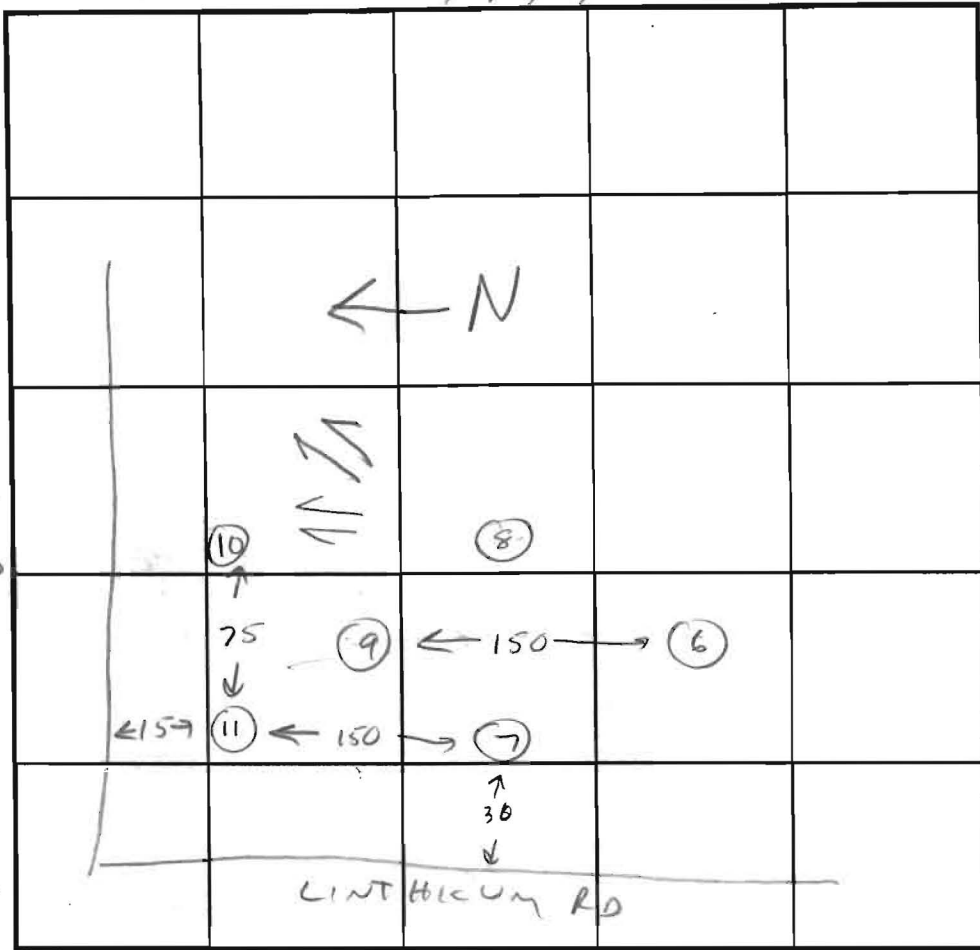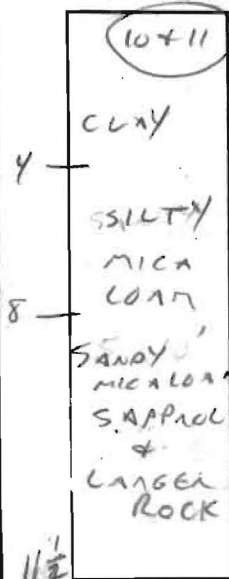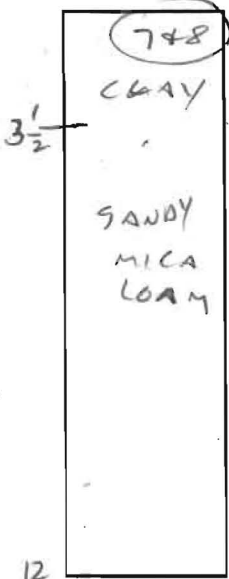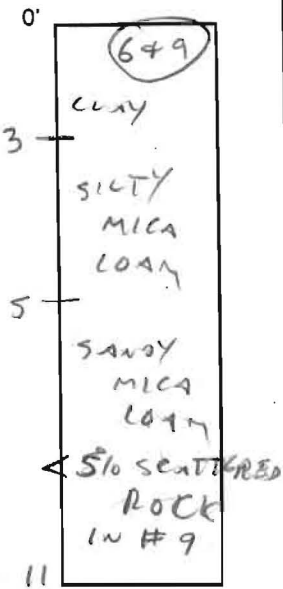

SOIL PROFILE

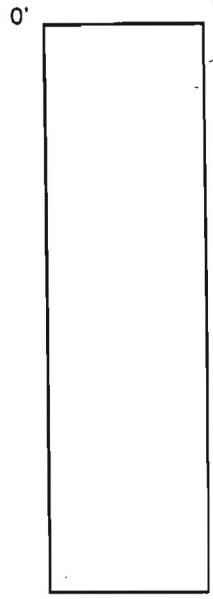

INDICATE NORTH - NAME ADJOINING ROADWAY AS BASE LINE.

DATE	TEST NO.	DEPTH	PRE-WET		TEST - 1" DROP		TIME
			START	STOP	START	STOP	
11/8/96	6/9	VIS	OK	3-11'	POWDERY	LOAM	
	7	4 1/2	11:10	11:13	11:13	11:17	4 MIN
		8 1/2	11:18	11:19	11:19	11:23:30	1 1/2 MIN
		12					
	8	4	VIS	OK TO	12		
		12					
	11	4	11:20	11:22	11:22	11:25	3 MIN
		7	11:20	11:21	11:21	11:23	2 MIN
		11	V1	5 OK TO	1 1/2'	(5-18% S+T+ROCK)	
	12	4	11:28	11:32	11:32	11:38	6 MIN
		7	11:28	11:30	11:30	11:33	3 MIN
		VIS	OK TO	1 1/2'			

REMARKS: WELL SITE IN QUESTION - MAY NEED TO ADJUST LOT SHAPE

TYPE OF SOIL _____

TESTED BY Cweel ALSO PRESENT CISSOL, BROWN


TRENCH DESIGN DATA: AVERAGE PERCOLATION TIME _____ TRENCH WIDTH 3

INLET DEPTH 4 MAXIMUM BOTTOM DEPTH 6 SQ. FT./BEDROOM 180

995,495.12 S.F.±
22.853 AC.±

REBAR FOUND

F98-04
ALLEN ACRES
H.O. SIGNATURE 11/3/97

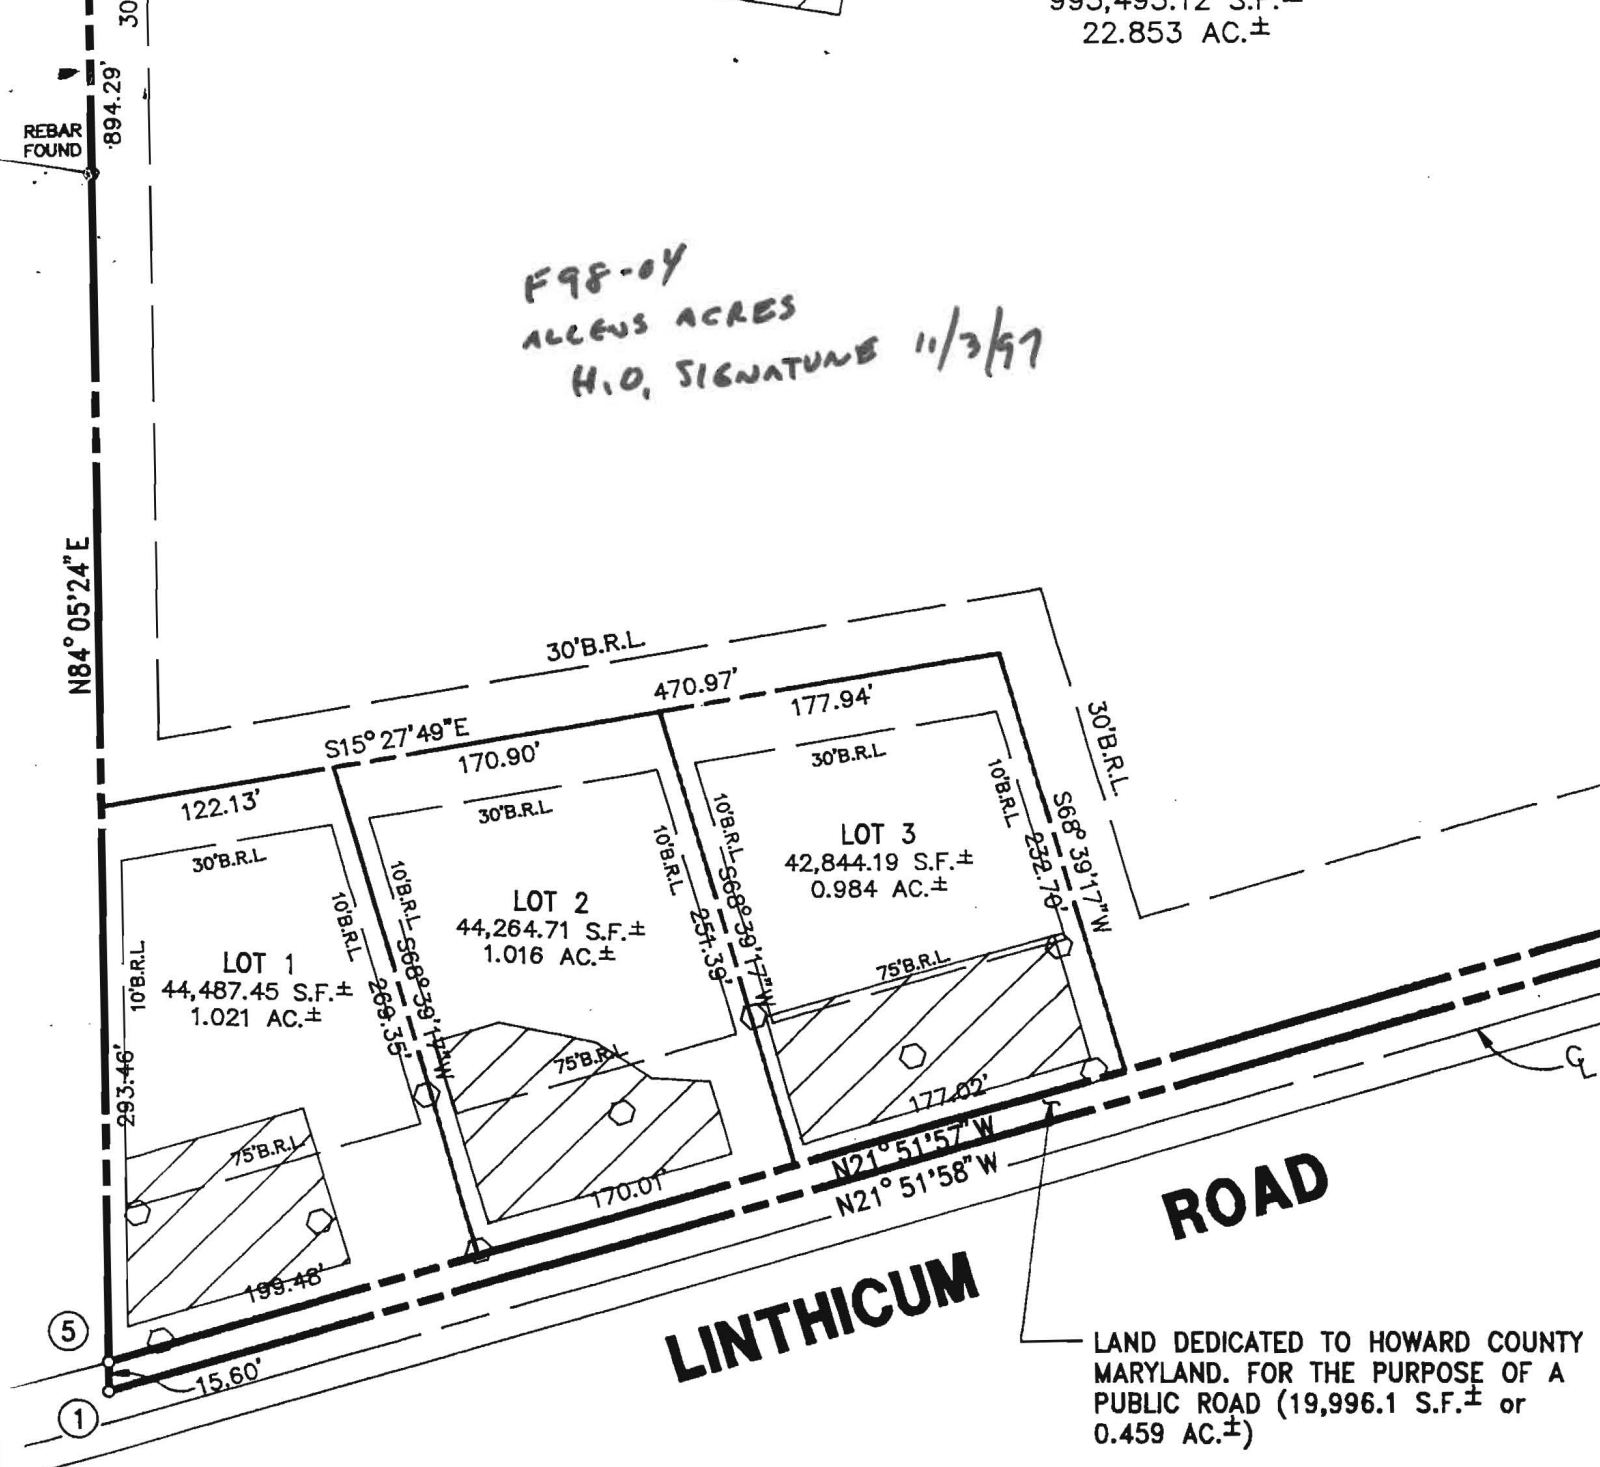

LINTHICUM

ROAD

LAND DEDICATED TO HOWARD COUNTY MARYLAND. FOR THE PURPOSE OF A PUBLIC ROAD (19,996.1 S.F.± or 0.459 AC.±)

OWNER'S CERTIFICATE

WE, ALLEN M. BROWN AND ESTELLE M. BROWN OWNERS OF THE PROPERTY DESCRIBED HEREON ADOPT THIS PLAN OF SUBDIVISION AND IN CONSIDERATION OF THE APPROVAL GRANTED BY THE DEPARTMENT OF PLANNING AND ZONING, ESTABLISH THE MINIMUM BUILDING SETBACKS AND GRANT UNTO HOWARD COUNTY, MARYLAND, ITS SUCCESSORS AND ASSIGNS (1) THE RIGHT TO CONSTRUCT AND MAINTAIN SEWERS, DRAINS, WATER PIPES AND OTHER MUNICIPAL UTILITIES AND EASEMENTS UNDER ALL ROADS AND STREETS RIGHT-OF-WAYS AND THE SPECIFIC EASEMENT AREA (2) THE RIGHT TO REQUIRE DEDICATION FOR PUBLIC USE THE BEDS OF THE STREETS AND/ OR FLOOD PLAINS AND OPEN SPACES WHERE APPLICABLE, AND FOR GOOD AND OTHER VALUABLE PURPOSES HEREBY GRANT THE RIGHT AND OPTION TO HOWARD COUNTY TO ACQUIRE THE FEE SIMPLE INTEREST IN THE BEDS OF THE STREETS AND/OR ROADS AND FLOOD PLAINS, STORM DRAINAGE FACILITIES AND OPEN SPACES WHERE APPLICABLE, (3) THE RIGHT TO REQUIRE DEDICATION OF WATER WAYS AND DRAINAGE EASEMENTS FOR THE PURPOSE OF THEIR CONSTRUCTION, REPAIR AND MAINTAINANCE AND (4) THAT NO BUILDING OR STRUCTURE OF ANY KIND SHALL BE ERRECTED ON OR OVER THE SAID EASEMENTS AND RIGHT-OF-WAYS.

WITNESS OUR HANDS THIS 28th DAY OF OCT, 1997

Allen M. Brown

Estelle M. Brown

SURVEYOR'S CERTIFICATE

I HEREBY CERTIFY THAT THE SURVEY HEREON IS CORRECT, THAT IT IS A VALID SUBDIVISION OF LAND CONVEYED BY JOHN H. BROWN AND ESTELLE M. BROWN BY A DEED DATED MAY 22, 1946 AND RECORDED IN THE RECORDS OF HOWARD COUNTY, MARYLAND, BOOK 240 AND THAT ALL MONUMENTS ARE IN ACCORDANCE WITH THE ANNOTATED CODE OF MARYLAND AS AMENDED AND THE STREETS IN THE SUBDIVISION BY THE

Surveyor's Signature

P/O PERC PLAT (APPROX. OF LOT 3 & 3B JANU 1997)

JAMES M. & ESTHER M. BROWN PROPERTY DAYTON

SCALE = 40'

