

THIS REPORT
MUST BE SUBMITTED
WITHIN 30 DAYS
AFTER COMPLETION
OF THE WELL

Brachans WELL COMPLETION REPORT **A-09440**

WELL DESCRIPTION

Permit Number **66 W 353**
Owner **A. C. Barnes**
Address **Brachansville**
Subdivision **Brachans**
Section **16** Lot **16**

PUMPING TEST
Hours Pumped **3**
Type of Pump Used **hand**
Pumping Rate **1**
Gallons per Minute **35**

WATER LEVEL
Distance from land surface to water:
Before Pumping **1**
When Pumping **1**

APPEARANCE OF WATER
Clear **Yes**
Taste **Good**
Odor **None**

Height of Casing Above Land Surface **2 ft** Ft.

PUMP INSTALLED
Type **hand**
Capacity
Gallons per Minute
Gallons per Hour
Pump Column Length **1** Ft.

WELL LOG
State the kind of formations penetrated, their color, their depth, their thickness, and if water bearing


22/27/27/27/
22 ft of dirt and 43
ft of hard gray rock

CASING AND SCREEN RECORD
State the kind and size and position of casing, liner, shoe, screen, and other accessories (if no casing used, give diameter of well).

FEET from **22** to **ft**
DIA. (inches) **5/8**
FEET from **22** to **ft**

66-W-353

LOCATION OF WELL ON LOT
Show permanent structures such as building(s), septic tank, and/or other landmarks and indicate not less than 2 distances (measurements) to well.

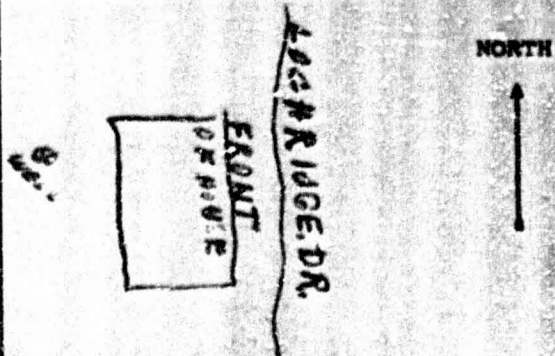

Date Well Was Completed **June 17, 1966**

Well Driller Signature **Walter Barnes**