

Building Address 1834 Long Corner Rd
 Suite/Apt. #: _____ SDP/WP/Petition #: _____
 Census Tract 6040 Subdivision Stottlemeyer Prop
 Section - Area - Lot 2
 Tax Map 6 Parcel 214 Grid 16
 Zoning RC Map Coordinates 2012 Lot size _____

Property Owner's Name Ken Payne
 Address 11320 San Andrews Dr
 City New Market State MD Zip Code 21774
 Home Phone 301-869-7070 Work Phone _____
 Applicant's Name & Mailing Address, (if other than stated hereon): _____

Existing Use vacant lot
 Proposed Use _____
 Estimated Construction Cost \$ 269,000
 Description of Work New custom single family home 4 bedrooms 2 1/2 baths

Contractor Company Wilcom Homes Inc.
 Contact Person Larry Wilcom
 Address 407 Copper Oaks Place
 City Woodsboro State MD Zip Code 21798
 License No. _____ Phone 301-898-0371 Fax _____

Occupant or Tenant _____
 Contact Name _____
 Address _____
 City _____ State _____ Zip Code _____
 Phone _____ Fax _____

Engineer or Architect Company _____
 Contact Person _____
 Address _____
 City _____ State _____ Zip Code _____
 Phone _____ Fax _____

BUILDING DESCRIPTION - COMMERCIAL		BUILDING DESCRIPTION - RESIDENTIAL	
<p>Building Characteristics</p> <p>Height: _____</p> <p>No. of stories: _____</p> <p>Gross area, sq. ft. per floor: _____</p> <p>Use group: _____</p> <p>Construction type: <input type="checkbox"/> Reinforced Concrete <input type="checkbox"/> Structural Steel <input type="checkbox"/> Masonry <input type="checkbox"/> Wood Frame <input type="checkbox"/> State Certified Modular</p>	<p>Utilities</p> <p>Water Supply: <input type="checkbox"/> Public <input type="checkbox"/> Private</p> <p>Sewage Disposal: <input type="checkbox"/> Public <input type="checkbox"/> Private</p> <p>Electric Yes <input type="checkbox"/> No <input type="checkbox"/> Gas Yes <input type="checkbox"/> No <input type="checkbox"/></p> <p>Heating System: <input type="checkbox"/> Electric <input type="checkbox"/> Oil <input type="checkbox"/> <input type="checkbox"/> Natural Gas <input type="checkbox"/> <input type="checkbox"/> Propane Gas <input type="checkbox"/></p> <p>Sprinkler system: N/A <input type="checkbox"/> <input type="checkbox"/> Full <input type="checkbox"/> Partial <input type="checkbox"/> Other Suppression # of Heads _____</p>	<p>Building Characteristics</p> <p>SF Dwelling <input type="checkbox"/> SF Townhouse <input type="checkbox"/> Depth _____ Width _____</p> <p>1st floor: _____ 2nd floor: _____ Basement: _____</p> <p>Finished Basement <input type="checkbox"/> Unfinished Basement <input type="checkbox"/> Crawl space <input type="checkbox"/> Slab on Grade <input type="checkbox"/> No. of Bedrooms _____</p> <p>Multi-family dwellings: No. of efficiency units: _____ No. of 1 BR units: _____ No. of 2 BR units: _____ No. of 3 BR units: _____</p> <p>Other Structure: _____ Dimensions: _____ Footings: _____ Roof: _____</p> <p><input type="checkbox"/> State Certified Modular <input type="checkbox"/> Manufactured Home</p>	<p>Utilities</p> <p>Water Supply: <input type="checkbox"/> Public <input type="checkbox"/> Private</p> <p>Sewage Disposal: <input type="checkbox"/> Public <input checked="" type="checkbox"/> Private</p> <p>Electric Yes <input type="checkbox"/> No <input type="checkbox"/> Gas Yes <input type="checkbox"/> No <input type="checkbox"/></p> <p>Heating System: <input type="checkbox"/> Electric <input type="checkbox"/> Oil <input type="checkbox"/> <input type="checkbox"/> Natural Gas <input type="checkbox"/> <input type="checkbox"/> Propane Gas <input type="checkbox"/></p> <p>Sprinkler system: N/A <input type="checkbox"/> <input type="checkbox"/> NFPA #13D <input type="checkbox"/> NFPA #13R <input type="checkbox"/> Other:</p>

THE UNDERSIGNED HEREBY CERTIFIES AND AGREES AS FOLLOWS: (1) THAT HE/SHE IS AUTHORIZED TO MAKE THIS APPLICATION; (2) THAT THE INFORMATION IS CORRECT; (3) THAT HE/SHE WILL COMPLY WITH ALL REGULATIONS OF HOWARD COUNTY WHICH ARE APPLICABLE THERETO; (4) THAT HE/SHE WILL PERFORM NO WORK ON THE ABOVE REFERENCED PROPERTY NOT SPECIFICALLY DESCRIBED IN THIS APPLICATION; (5) THAT HE/SHE GRANTS COUNTY OFFICIALS THE RIGHT TO ENTER ONTO THIS PROPERTY FOR THE PURPOSE OF INSPECTING THE WORK PERMITTED AND POSTING NOTICES.

Applicant's Signature _____ Print Name Ken Payne
 Title/Company _____ Date 12-13-00

Checks payable to: **DIRECTOR OF FINANCE OF HOWARD COUNTY**
**** PLEASE WRITE NEATLY AND LEGIBLY. ****
- FOR OFFICE USE ONLY -

AGENCY	DATE	SIGNATURE APPROVAL	DPZ SETBACK INFORMATION	PROPERTY ID#:
Land Development, DPZ	11/20/00	Joe [Signature]	Front: <u>125 FT</u>	49035
State Highways			Rear: <u>60 FT</u>	
Building Official			Side: <u>30 FT</u>	
Dev. Engineering, DPZ			Side St.: <u>NA</u>	
Health	1/2/01	Mark [Signature]	All minimum setbacks met? YES <input checked="" type="checkbox"/> NO <input type="checkbox"/>	
Fire Protection			Is Entrance Permit required? YES <input type="checkbox"/> NO <input checked="" type="checkbox"/>	Filing fee \$ <u>25.00</u>
Is Sediment Control approval required prior to issuance? YES <input type="checkbox"/> NO <input type="checkbox"/>			Historic District? YES <input type="checkbox"/> NO <input checked="" type="checkbox"/>	Permit fee \$ _____
CONTINGENCY CONSTRUCTION START: <input type="checkbox"/>			Lot Coverage for New Town Zone _____	Excise tax \$ _____
ONE STOP SHOP: <input type="checkbox"/>			SDP/Red-line approval date _____	Sub-total paid \$ _____
			Accepted by _____	Add'l permit fee \$ _____
				TOTAL FEES \$ _____
				Balance due \$ _____
				Check # <u>110112</u>
				Validation # _____

Approved Septic System Plan
Howard County Health Department

Mark R. Ryker
Signature

1/2/01
Date

N/F
JACK ALAN LEHMAN
1042 / 402
UNRECORDED SUBDIVISION
OF C.R. NAPLES
PROPERTY LOT 7

Total linear feet of trench
required 280 feet

Width of trench(es) 3 feet


Depth of trench(es) 6 feet

Depth of stone required below
distribution pipe 2 feet

LOT 2
142,903.11 s.f.
or
3.2806 Ac.±

N. 26° 13' 40"
HOUSE INV 738.9
S.T. INV IN 737.5
OUT 737.2
PUMP PIT IN 737.1
D.B. IN 753.5
TRENCH 752.0

294.54'
162'±
60' BRL30' BRL

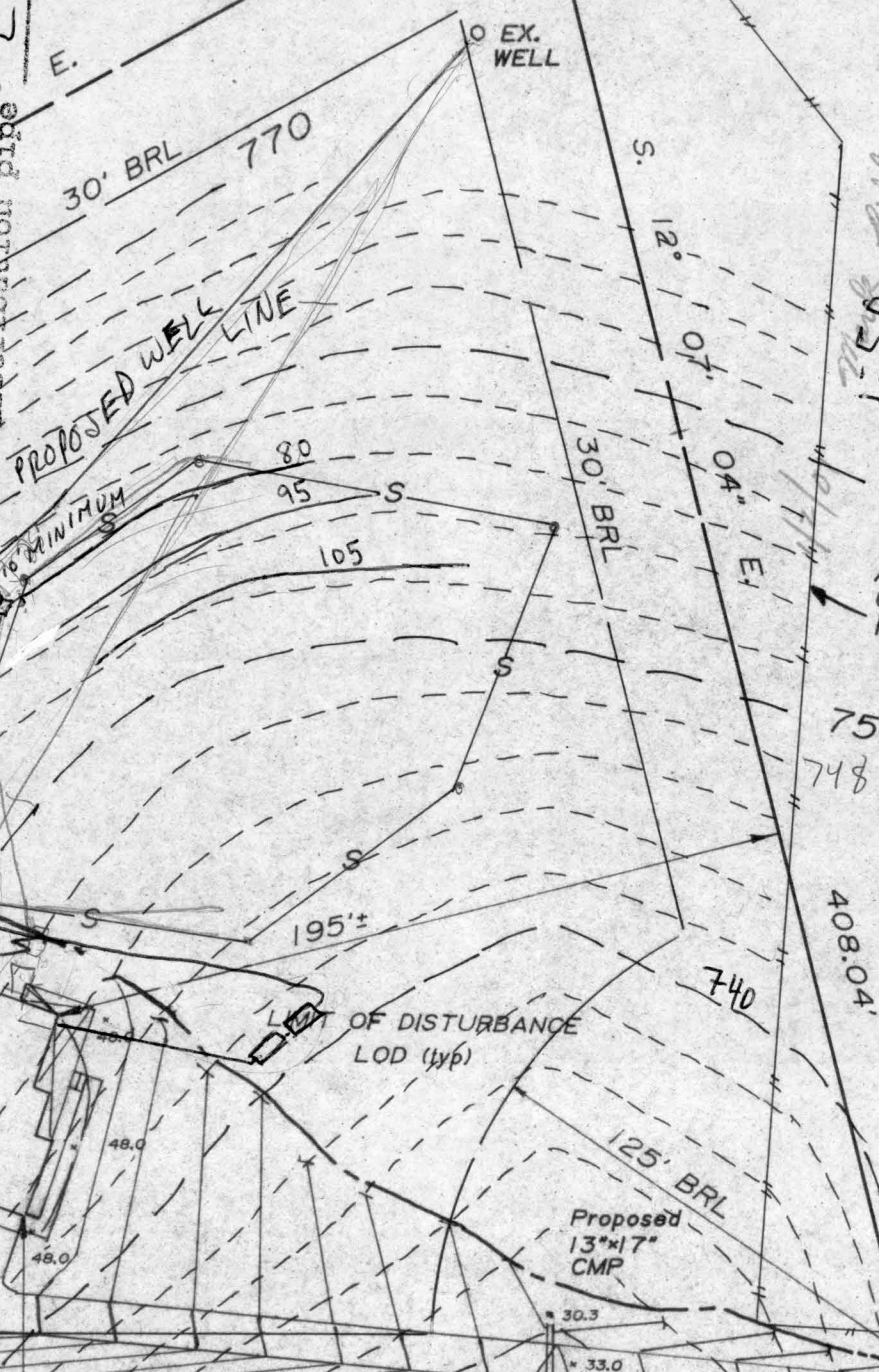

1:50 Ryker
PLAN BY
GARY CASTLE + ASSOC.
301-416-0307

ADJOINERS
CHAIN LINK
FENCE LINE

↓ TO LONG
CORNER ROAD

30' BRL

Proposed
13"x17"
CMP

OF DISTURBANCE
LOD (typ)

FF 750.3
BE 741.3

314.77'
30' BRL 770

30' BRL

750

748

740

408.04'

125' BRL

30.3

33.0

16.5