



PLAN VIEW
SCALE: 1" = 100'

NOTE: 1. THE CONTOURS AND ELEVATIONS SHOWN HERON ARE BASED ON 600 SCALE TOPOGRAPHY PROVIDED BY HOWARD COUNTY.
2. THE BOUNDARY LINES SHOWN HEREON ARE BASED ON PLAT 13940.
3. LIMIT OF DISTURBANCE 11283 SQ. FT. (0.26 Ac.)

REVISED
Date: 11-7-00
Comments: Long Corner Rd
3012 4306
Change driveway per Engineer

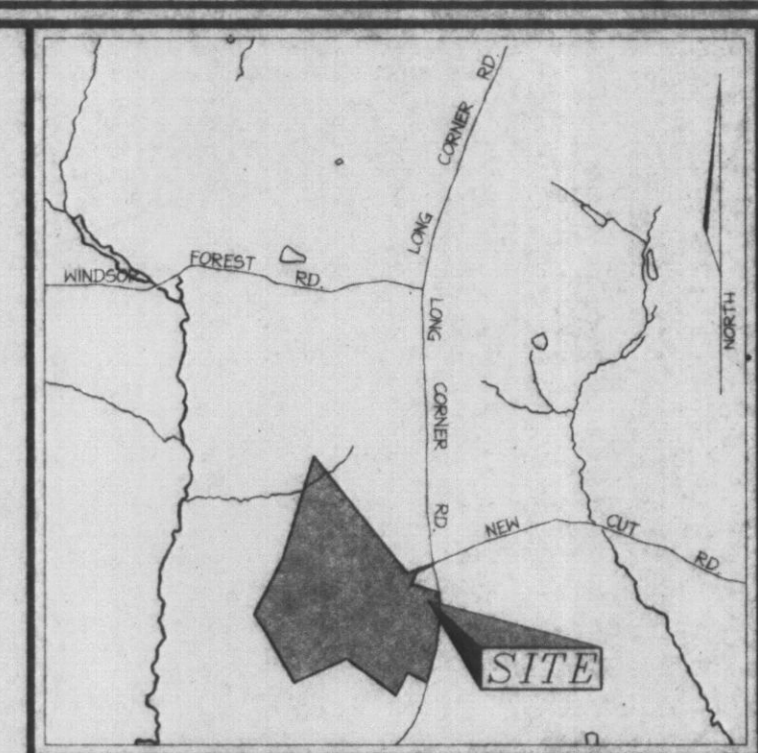

VICINITY MAP
SCALE: 1" = 2000'

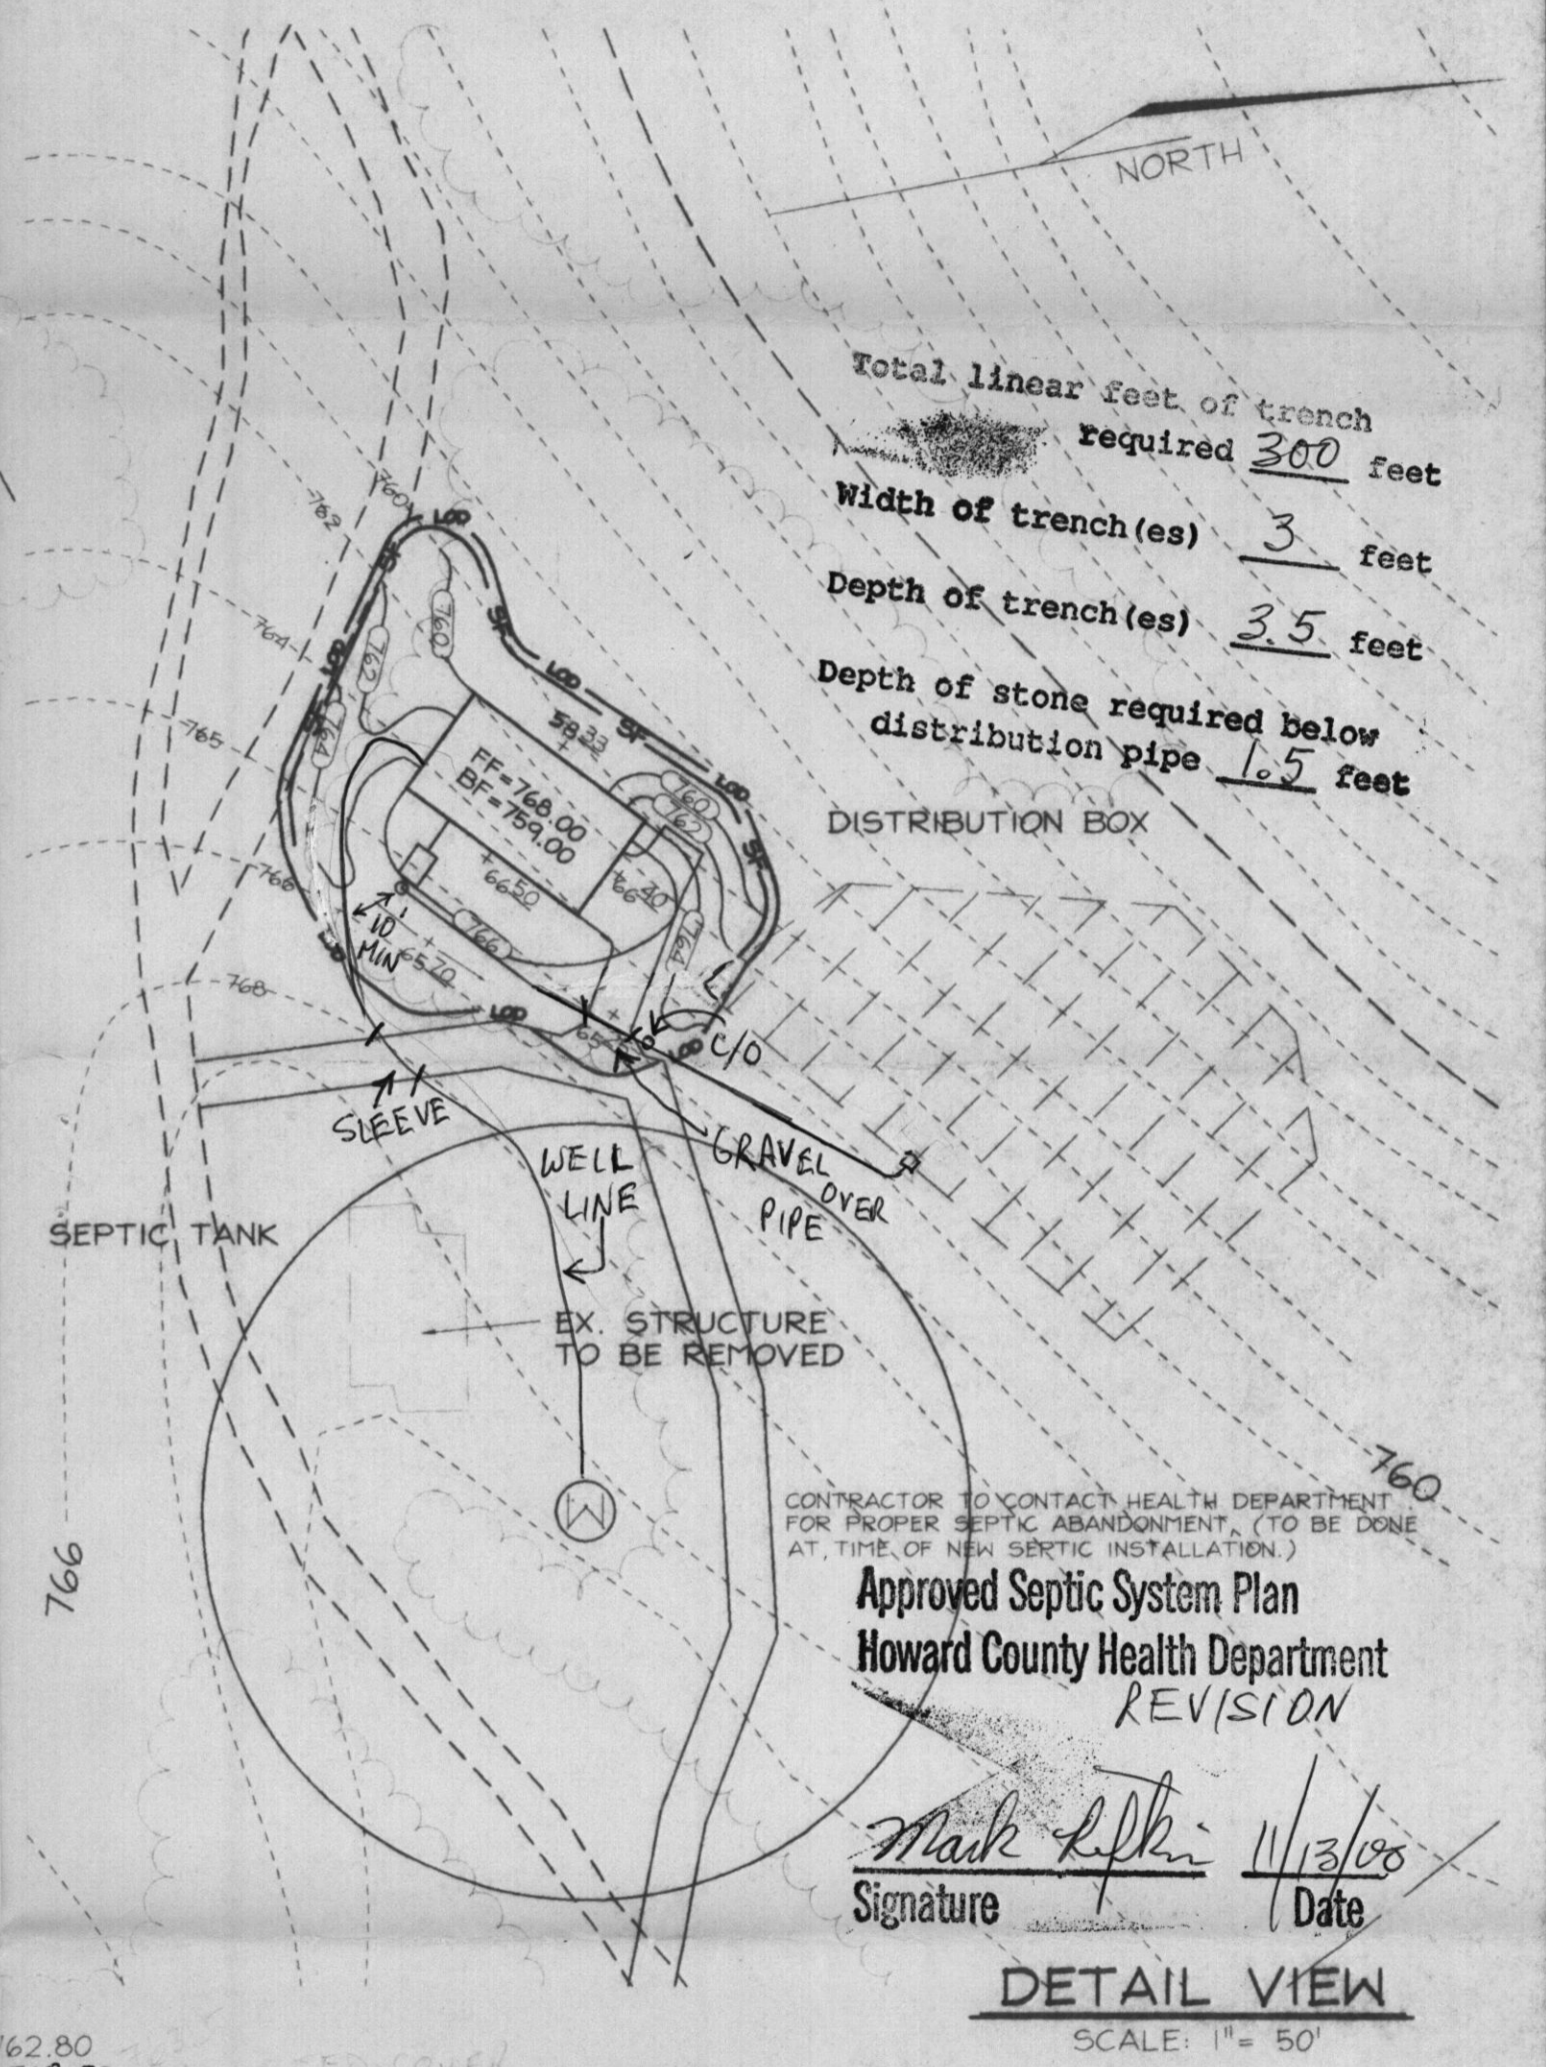

HOUSE: GR. = 762.80
HOUSE: INV. IN = 763.50
SEPTIC TANK: TOP = 766.0
INV. IN = 763.6
INV. OUT = 762.7
DISTRIBUTION BOX: TOP = 762.5
INV. IN = 760.5

PLOT PLAN
WILETS PROPERTY

TAX MAP # 6
4TH ELECTION DISTRICT HOWARD COUNTY, MARYLAND

VOGEL & ASSOCIATES
ENGINEERS • SURVEYORS • PLANNERS

3691 Park Avenue, Suite 101 • Elkott City, Maryland 21043
Tel 410.461.5828 Fax 410.465.3966

DESIGN BY: JCO
DRAWN BY: RLP
CHECKED BY: RHV
DATE: MAY, 2000
SCALE: AS SHOWN
W.O. NO.: 00-54

1 SHEET OF 1

OWNER
WENDY TAKACS
11407 FREDERICK ROAD
FREDERICK, MD. 21042