


2'	Or Brown Sa Clay Loam
	Light Br Sa Loam
11.5'	White and Light Br Sa Loam
15'	

NOT TO SCALE

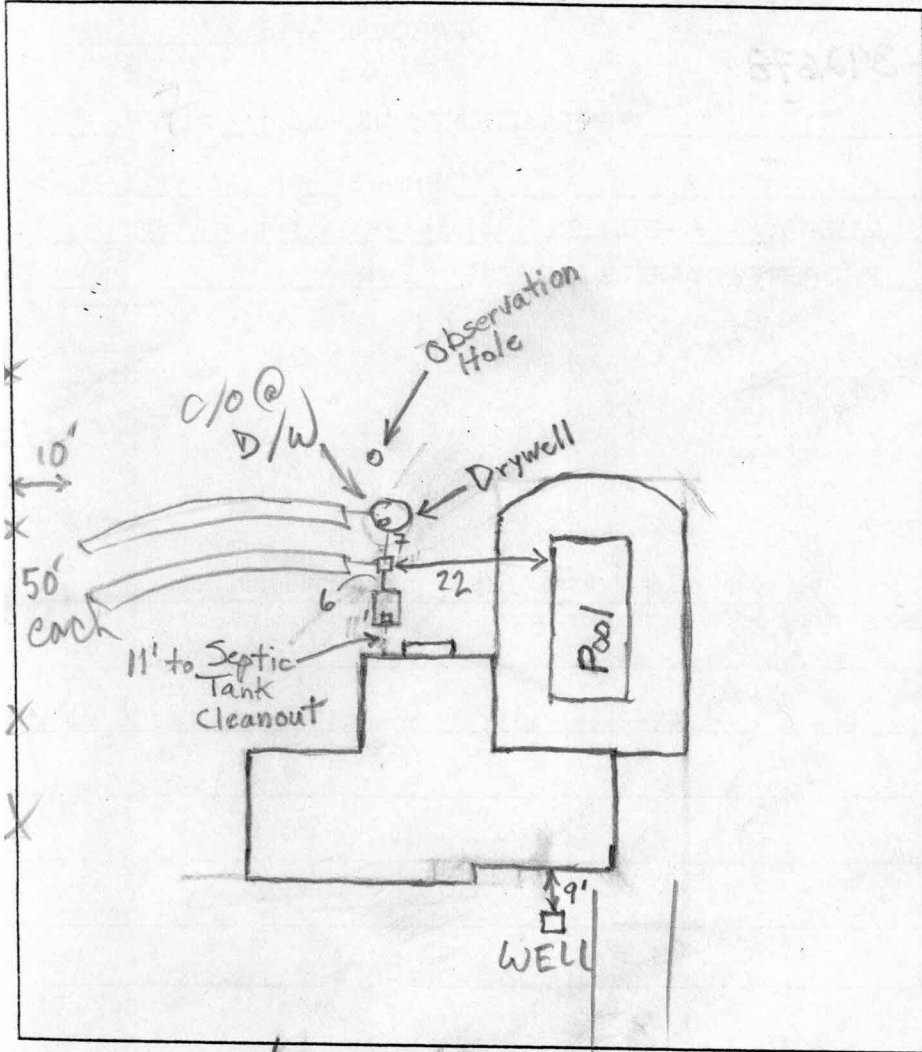

TRENCH DATA

TRENCH WIDTH 2
 TRENCH INLET DEPTH 3-3.5
 TRENCH BOTTOM DEPTH 9
 DEPTH OF STONE 5 1/2 - 6
 NUMBER OF TRENCHES 2
 TOTAL TRENCH LENGTH 100
 ABSORBENT AREA 550
 DISTRIBUTION BOX LEVEL
 BAFFLE IN DISTRIBUTION BOX

SEPTIC TANK DATA

SEPTIC TANK Existing 1000? GALLONS
 MANHOLE RISER No
 6 INCH INSPECTION PORT Yes

PUMP CHAMBER DATA N/A

~~PUMP CHAMBER GALLONS _____
 MANHOLE RISER _____
 ALARM _____
 PUMP PERFORMANCE TEST _____~~

PRE-CONSTRUCTION INSPECTION: Longview Road 8/15/01 2-50' trenches installed toward left lot line. Stone from 3' to 8.5' and 2' wide. (BB)
 INSPECTION COMMENTS: 8/16/01 OK TO COVER (MR)

INSPECTOR M. Ripkin DATE SYSTEM APPROVED 8/16/01