

APPLICATION

PERCOLATION TESTING

A 515227

P _____

HOWARD COUNTY HEALTH DEPARTMENT
BUREAU OF ENVIRONMENTAL HEALTH
3525-H ELLICOTT MILLS DRIVE/ELLICOTT CITY, MARYLAND 21043
TELEPHONE: 313-2640

DISTRICT _____

DATE _____

TO: THE COUNTY HEALTH OFFICER
ELLICOTT CITY, MARYLAND

I HEREBY APPLY FOR THE NECESSARY TEST PRIOR TO APPLICATION FOR PERMIT TO CONSTRUCT (OR RECONSTRUCT) A SEWAGE DISPOSAL SYSTEM.

PROPERTY OWNER _____

ADDRESS _____ PHONE _____

AGENT OR PROSPECTIVE BUYER _____

ADDRESS _____ PHONE _____

PROPERTY LOCATION:

SUBDIVISION Waterford Farm LOT NO. 1

ROAD AND DESCRIPTION Daisy Rd

TAX MAP _____ PARCEL # _____

SIZE OF LOT _____ TYPE BLDG. _____
(SINGLE FAMILY DWELLING OR COMMERCIAL)

THE SYSTEM INSTALLED UNDER THIS APPLICATION IS ACCEPTABLE ONLY UNTIL PUBLIC FACILITIES BECOME AVAILABLE. I FULLY UNDERSTAND THE FEE CONNECTED WITH THE FILING OF THIS PERC TEST APPLICATION IS NON-REFUNDABLE UNDER ANY CIRCUMSTANCES. I ALSO AGREE TO COMPLY WITH ALL M.O.S.H.A. REQUIREMENTS IN TESTING THIS LOT.

(SIGNATURE OF APPLICANT)

APPROVED BY _____ FOR _____ DATE _____

DISAPPROVED BY _____ FOR _____ DATE _____

HOLD PENDING FURTHER TESTS _____

REASONS FOR REJECTION OR HOLDING _____

PERCOLATION TEST PLAT/PRELIMINARY PLAT - TITLE OR I.D. # _____ DATE _____


SITE DEVELOPMENT PLAN/FINAL PLAT - TITLE OR I.D. # _____ DATE _____

THIS IS NOT A PERMIT

A515227

NOT TO SCALE

COUNTY #

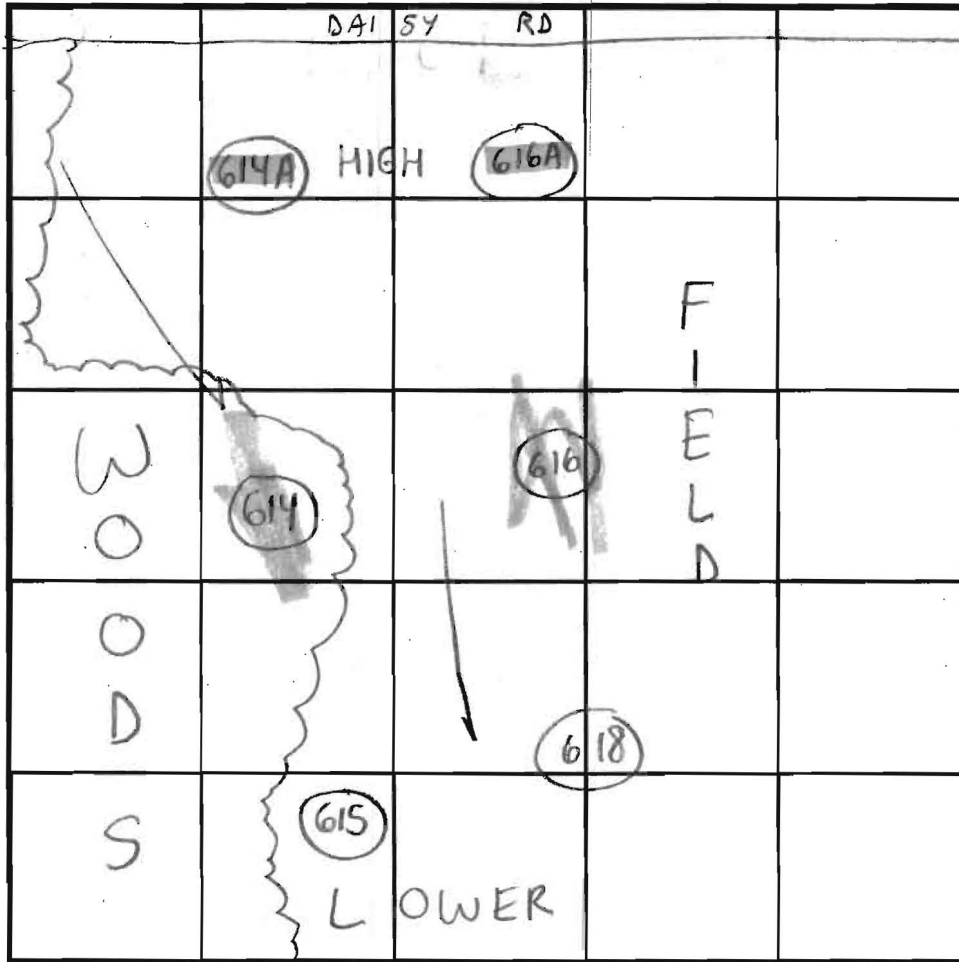

SOIL PROFILE 616/616A

0' orange-brown clay loam
 3' tan-fine sandy loam
 5-10% ROCK FRAGS
 13'

618

4' orange-brown clay loam
 tan fine-sandy loam
 5-10% ROCK FRAGS
 13'

615

orange-brown clay loam
 5' tan fine-sandy loam
 5-10% ROCK FRAGS
 13'

SOIL PROFILE 614/614A

0' orange-brown clay loam
 5' tan-fine-sandy loam
 10-20% ROCK FRAGS
 13'

INDICATE NORTH - NAME ADJOINING ROADWAY AS BASE LINE.

DATE	TEST NO.	DEPTH	PRE-WET		TEST - 1" DROP		TIME		
			START	STOP	START	STOP			
7/27/01	616	3' T 13' V	4:30pm	4:32pm	4:32pm	4:34pm	2min	OK	
	618	13' V	(VISUAL OK SEE SOIL PROFILE)						OK
	615	6' T 13' V	4:34pm	4:37pm	4:37pm	4:40pm	3min	OK	
	614	13' V	(VISUAL OK SEE SOIL PROFILE)						OK
8/6/01	614A	13' V	"	"	"	"	"	OK	
	616A	5' T 13' V	12:12pm	12:14pm	12:14pm	12:17pm	3min	OK	

REMARKS _____
 TYPE OF SOIL Chester
 TESTED BY SRU ALSO PRESENT Chuck Sharp
 TRENCH DESIGN DATA: AVERAGE PERCOLATION TIME 3min TRENCH WIDTH 3'
 INLET DEPTH 3' MAXIMUM BOTTOM DEPTH 5' SQ. FT./BEDROOM 180

N 05°37'00" E
N 02°41'39" E
N 01°56'51" E
171-74
3/4" = 1' (VERT FOR LIND)

SIGNED

GIB2FG

EKB2

SWM NON-BUILDABLE
PRESERVATION
PARCEL VEI
3,250 ± HOA OWNED
AND MAINTAINED

CLASS A POND

GND2

