

APPLICATION

PERCOLATION TESTING

A 514952

P _____

HOWARD COUNTY HEALTH DEPARTMENT
BUREAU OF ENVIRONMENTAL HEALTH
3525-H ELLICOTT MILLS DRIVE/ELLICOTT CITY, MARYLAND 21043
TELEPHONE: 313-2640

DISTRICT _____

DATE 2/28/01

TO: THE COUNTY HEALTH OFFICER
ELLICOTT CITY, MARYLAND

I HEREBY APPLY FOR THE NECESSARY TEST PRIOR TO APPLICATION FOR PERMIT TO CONSTRUCT (OR RECONSTRUCT) A SEWAGE DISPOSAL SYSTEM.

PROPERTY OWNER Waterford Farm Joint Venture

ADDRESS 4003 Jennings Chapel Rd PHONE _____
Brooksville MD 20833

AGENT OR PROSPECTIVE BUYER _____

ADDRESS _____ PHONE _____

PROPERTY LOCATION:

SUBDIVISION Waterford Property LOT NO. 8

ROAD AND DESCRIPTION Daisy Road

TAX MAP 13, 14, 20, 21 PARCEL # 20

SIZE OF LOT _____ TYPE BLDG. SFD
(SINGLE FAMILY DWELLING OR COMMERCIAL)

THE SYSTEM INSTALLED UNDER THIS APPLICATION IS ACCEPTABLE ONLY UNTIL PUBLIC FACILITIES BECOME AVAILABLE. I FULLY UNDERSTAND THE FEE CONNECTED WITH THE FILING OF THIS PERC TEST APPLICATION IS NON-REFUNDABLE UNDER ANY CIRCUMSTANCES. I ALSO AGREE TO COMPLY WITH ALL M.O.S.H.A. REQUIREMENTS IN TESTING THIS LOT.

Chubert Shyer
(SIGNATURE OF APPLICANT)

APPROVED BY _____ FOR _____ DATE _____

DISAPPROVED BY _____ FOR _____ DATE _____

HOLD PENDING FURTHER TESTS _____

REASONS FOR REJECTION OR HOLDING _____

PERCOLATION TEST PLAT/PRELIMINARY PLAT - TITLE OR I.D. # _____ DATE _____

SITE DEVELOPMENT PLAN/FINAL PLAT - TITLE OR I.D. # _____ DATE _____

THIS IS NOT A PERMIT


A515227-6

COUNTY #


NOT 10 20700

LUT 9



SOIL PROFILE

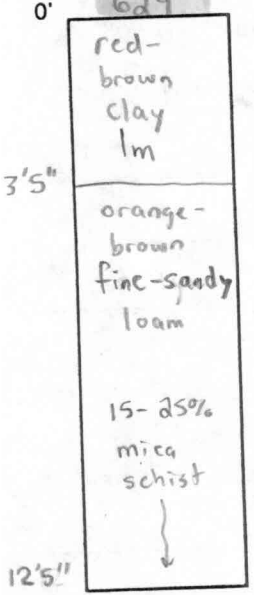


628

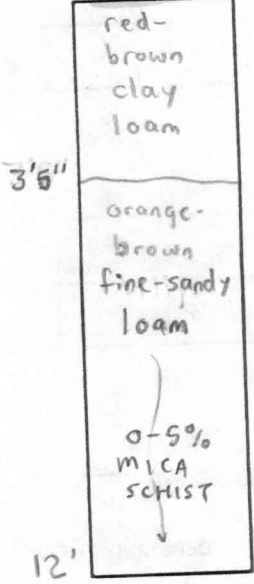

631

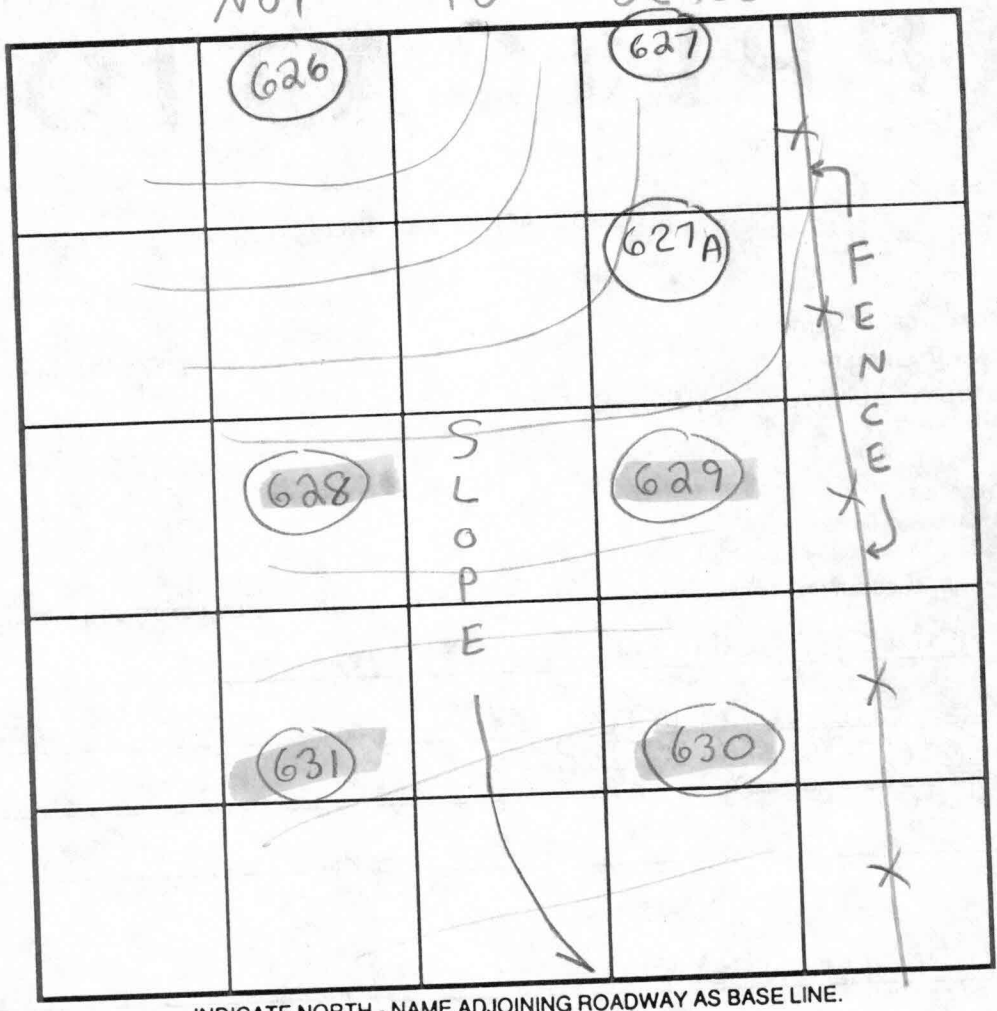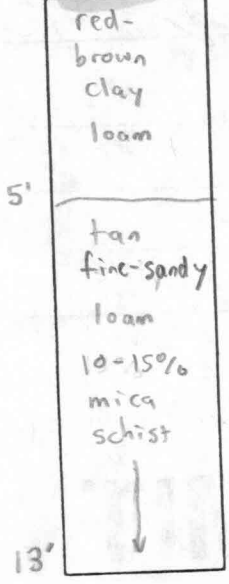


SOIL PROFILE

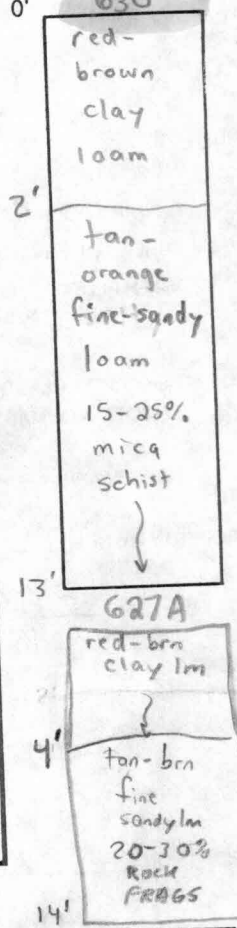

INDICATE NORTH - NAME ADJOINING ROADWAY AS BASE LINE.

DATE	TEST NO.	DEPTH	PRE-WET		TEST - 1' DROP		TIME		
			START	STOP	START	STOP			
6/4/01	629	3'5" T / 12'5" V	2:49 pm	2:51 pm	2:51 pm	2:54 pm	3 min	OK	
	628	4' T / 12' V	3:09 pm	3:11 pm	3:11 pm	3:16 pm	5 min	OK	
	631	3' T / 13' V	3:20 pm	3:25 pm	3:25 pm	3:35 pm	10 min	OK	
	630	12'5" V	(VISUAL OK SEE SOIL PROFILE)						OK
2/8/02	627A	7'5" T / 14' V	10:39 am	10:42 am	10:42 am	10:48 am	6 min	OK	

REMARKS _____
 TYPE OF SOIL Glenelg
 TESTED BY SRK Jeff Allen = Backhoe Chuck Sharp = ALSO PRESENT Francois
 TRENCH DESIGN DATA: AVERAGE PERCOLATION TIME 6 min TRENCH WIDTH 3'
 INLET DEPTH 3' MAXIMUM BOTTOM DEPTH 5' SQ. FT./BEDROOM 180

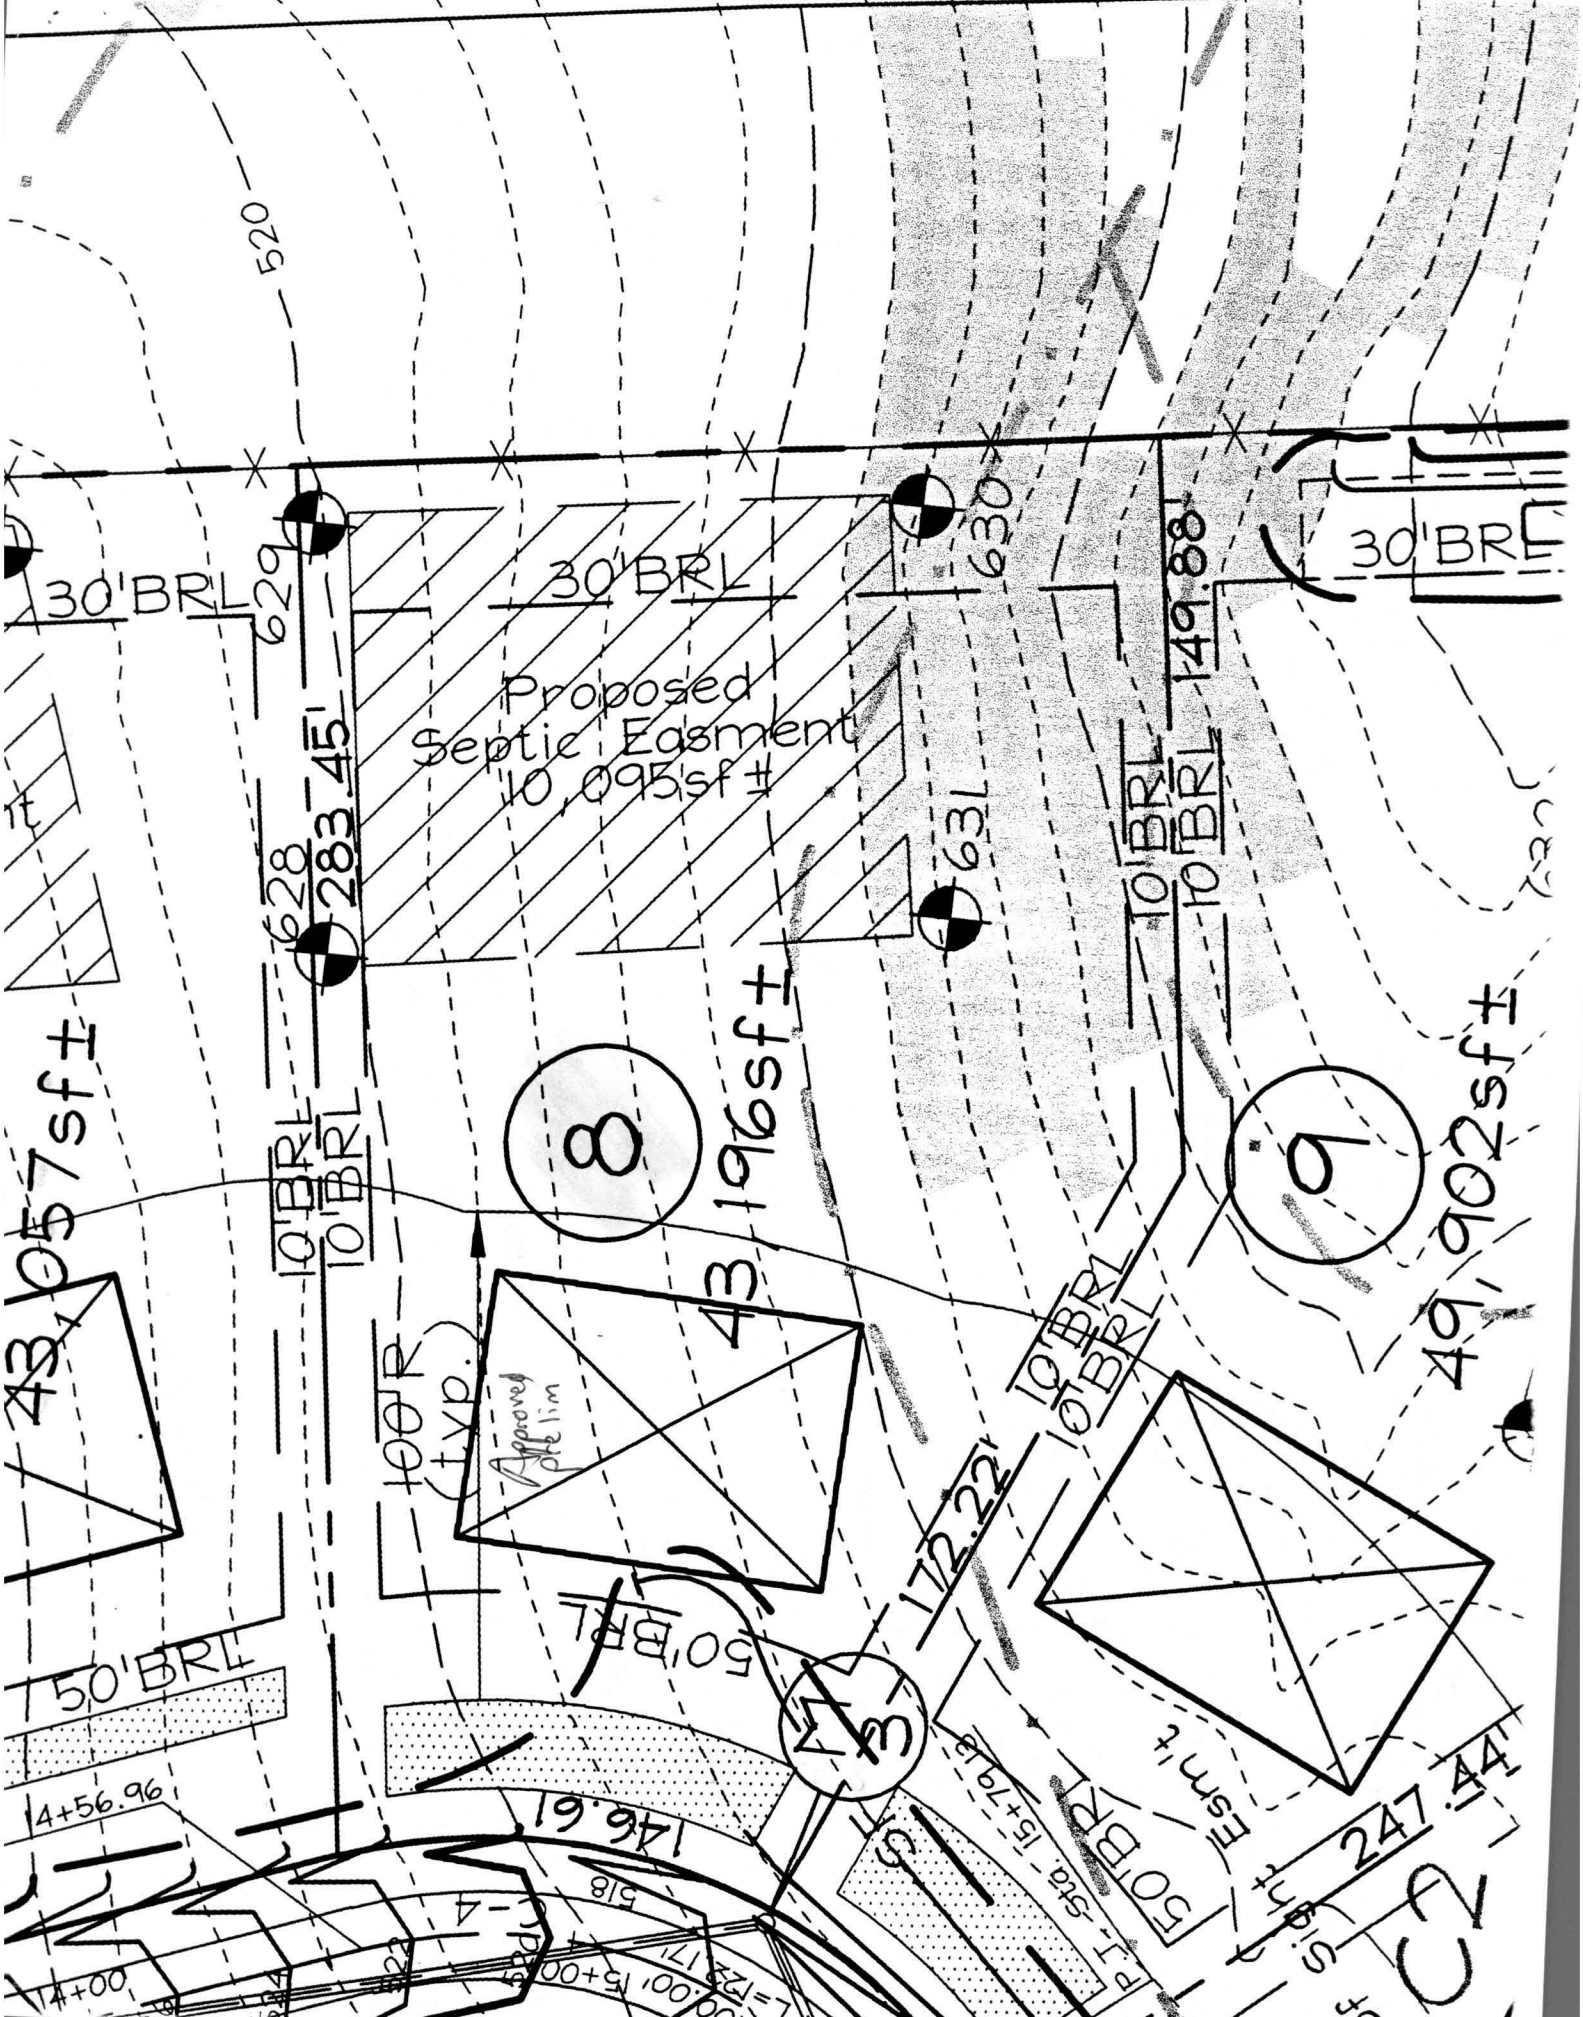

43,057sf ±

50' BRL

14+56.96

14+00

L=123.17
100.00' 15+00'

520

629

628

10' BRL

10' BRL

100'R (typ.)

146.61

518

283.45'

Approved plat lim

50' BRL

147.17

30' BRL

Proposed Septic Easment 10,095sf ±

8

43,196sf ±

172.22'

630

631

10' BRL

10' BRL

15+79.13

150' BRL

149.88

10' BRL

10' BRL

10' BRL

10' BRL

150' BRL

9

49,902sf ±

141.42'

141.42'

141.42'

30' BRL

30' BRL


30' BRL

30' BRL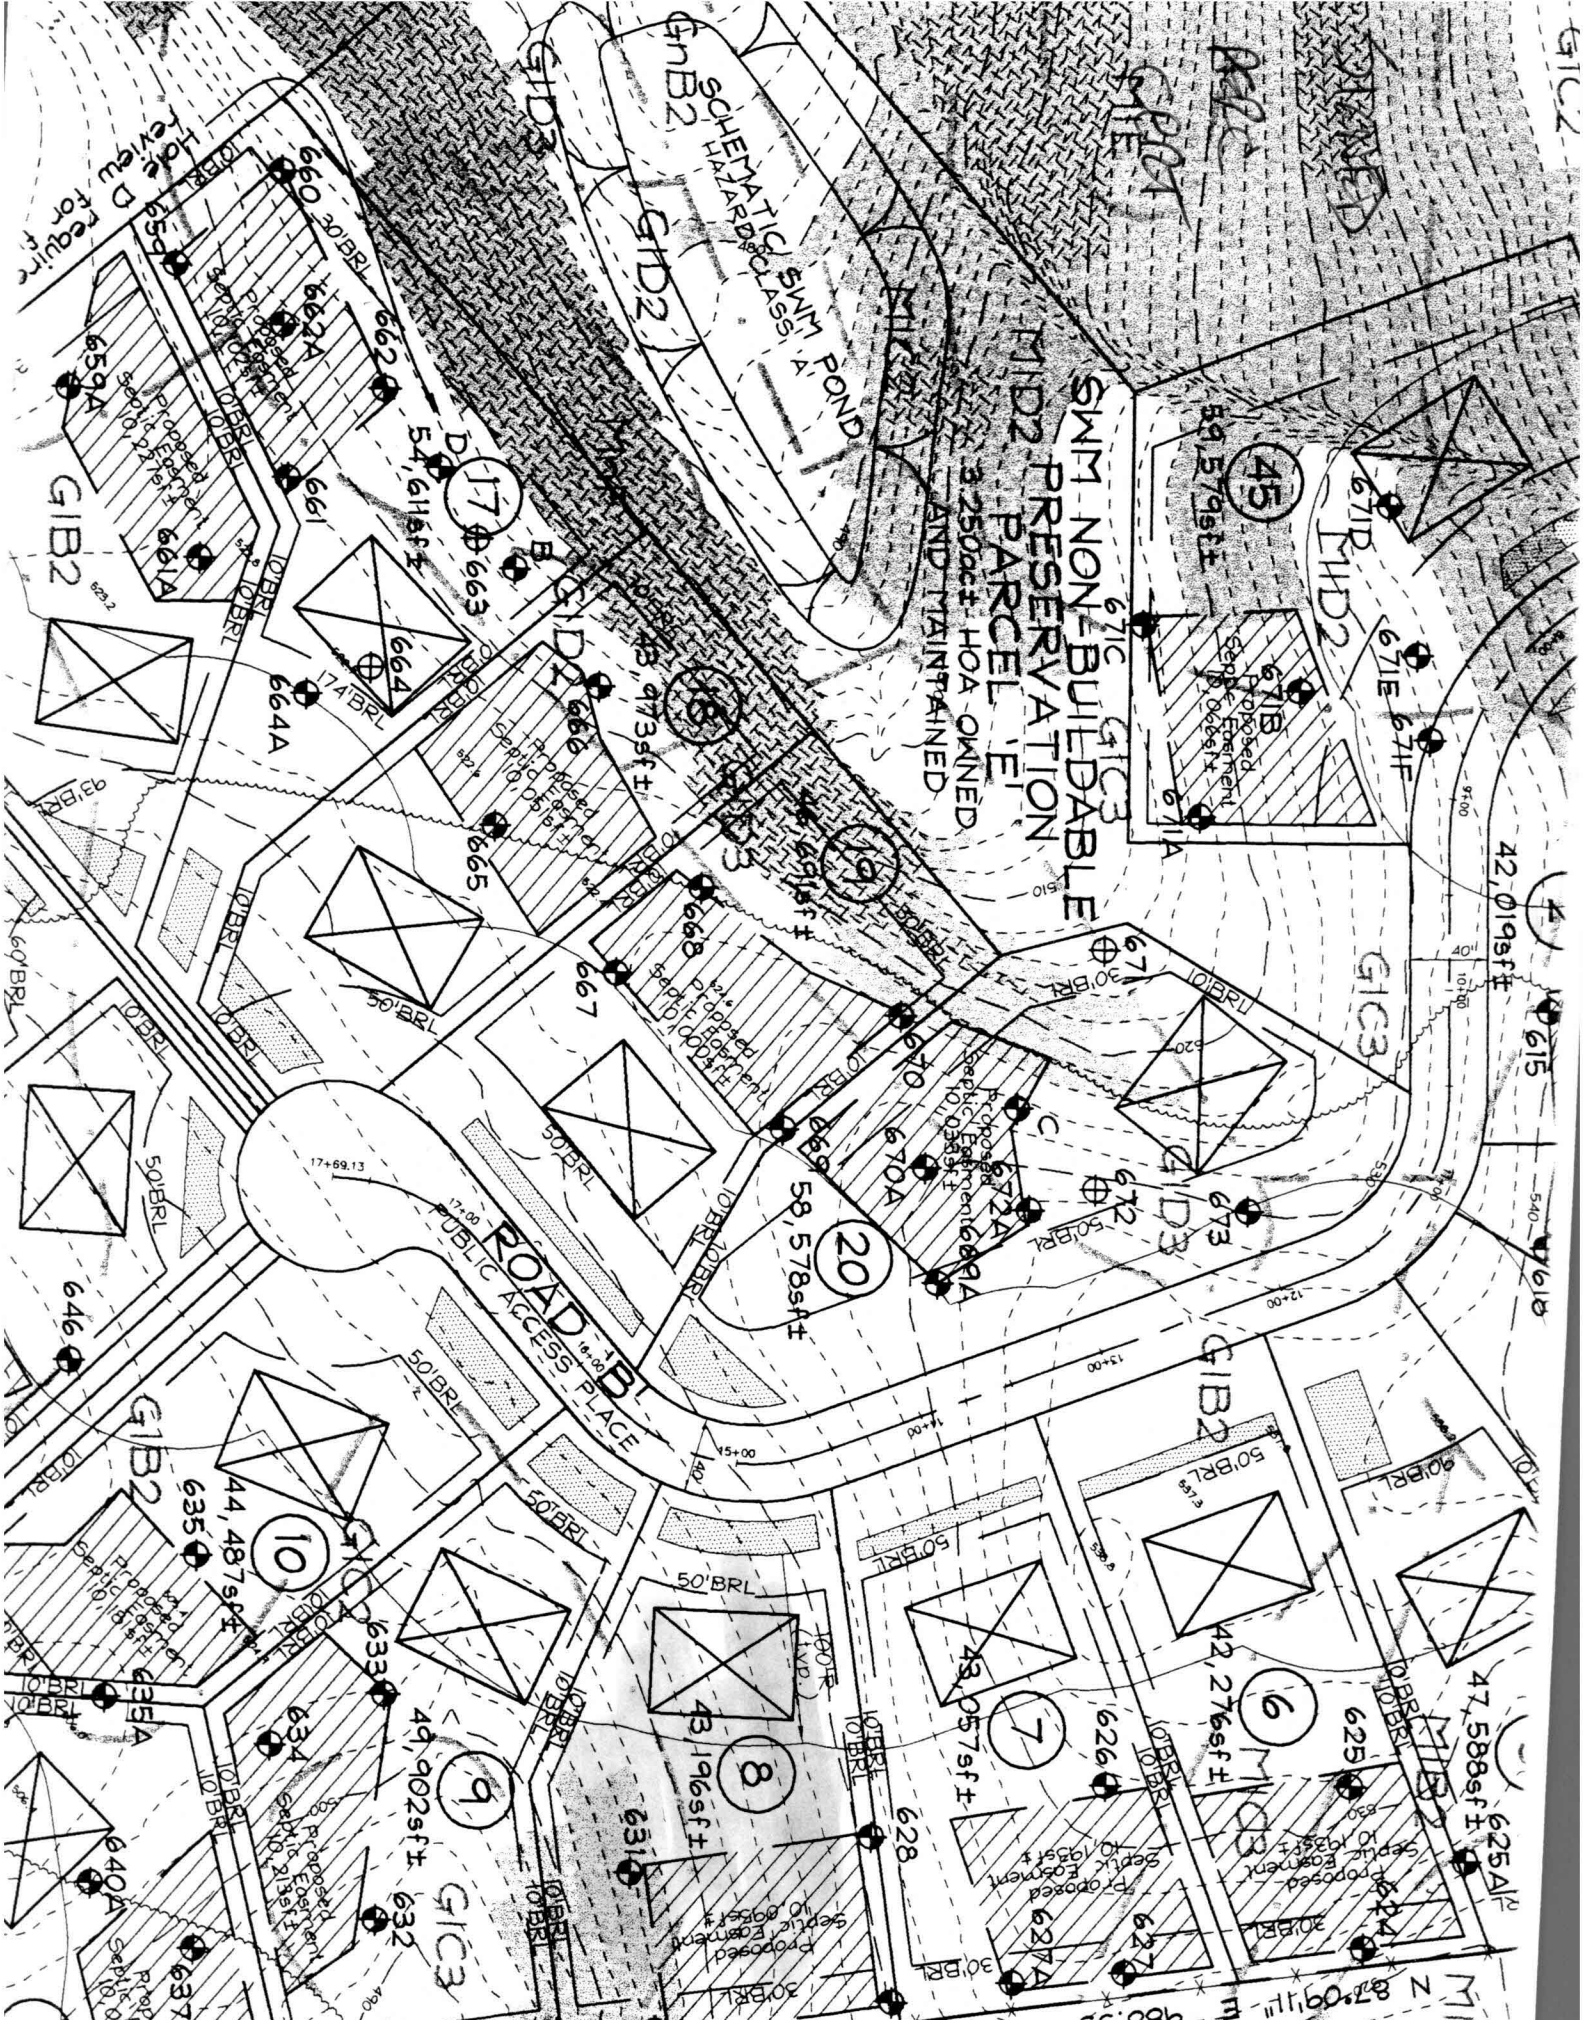

SWM NON-BUILDABLE PRESERVATION PARCEL "E1" 3.250ac HOA OWNED AND MAINTAINED

ROAD BI PUBLIC ACCESS PLACE

SCHEMATIC CLASS "A" POND

HOA D require for

M N 87.09' 11" m 988.05

