


515227-P
COUNTY #



NOT TO SCALE

LOT 17

SOIL PROFILE
661/662

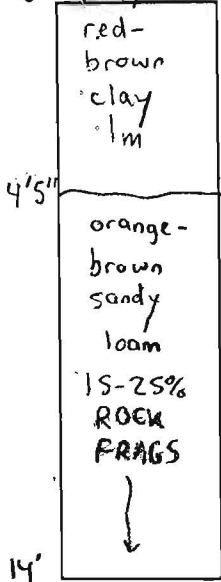


SOIL PROFILE
661A

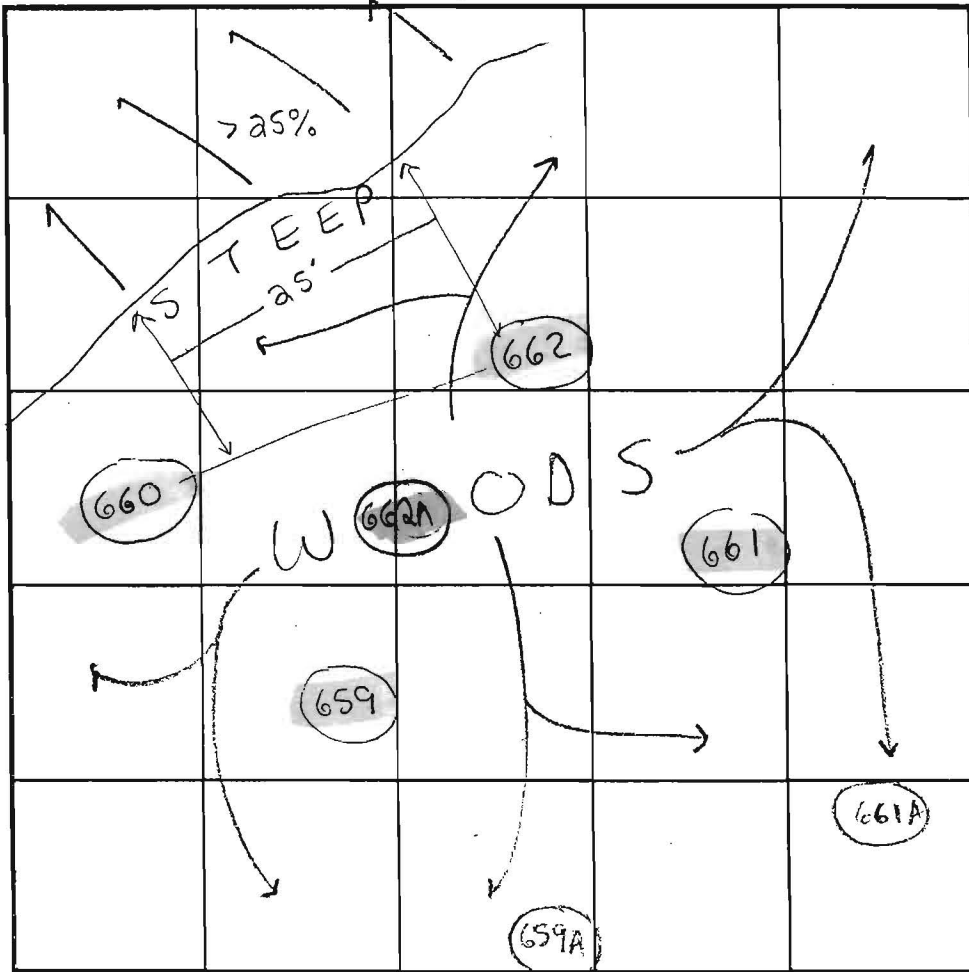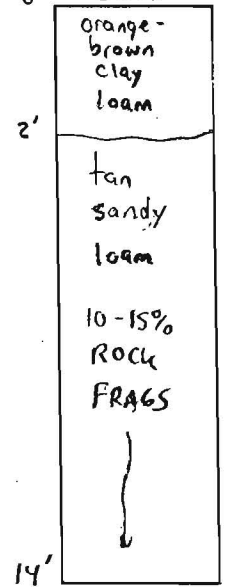


INDICATE NORTH - NAME ADJOINING ROADWAY AS BASE LINE.

660

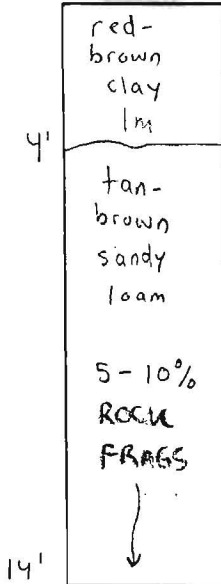

659/659A/662A

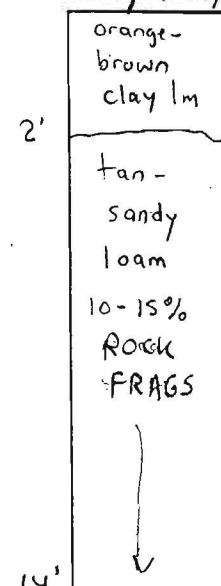

DATE	TEST NO.	DEPTH	PRE-WET		TEST - 1" DROP		TIME	
			START	STOP	START	STOP		
6/5/01	661	4'5" T / 14' V	4:48 pm	4:50 pm	4:50 pm	4:55 pm	5 min	OK
	660	4'5" T / 14' V	4:58 pm	5:02 pm	5:02 pm	5:07 pm	5 min	OK
	659	14' V	(VISUAL OK)	SEE	SEE	SOIL PROFILE		OK
	662	14' V	(VISUAL OK)	SEE	SEE	SOIL PROFILE		OK
2/8/01	662A	6'5" T / 13' V	1:50 pm	1:53 pm	1:53 pm	1:57 pm	4 min	OK
8/6/01	659A	13' V	(VISUAL OK)	SEE	SEE	SOIL PROFILE		OK
	661A	14' V	"	"	"	"	"	OK

REMARKS Tests in Woods
 TYPE OF SOIL Glenelg & Manor
 TESTED BY SRK Todd Parks = Backhoe
 Chuck Sharp ALSO PRESENT Francois
 TRENCH DESIGN DATA: AVERAGE PERCOLATION TIME 5min TRENCH WIDTH 3'
 ? INLET DEPTH 33' MAXIMUM BOTTOM DEPTH 5' SQ. FT./BEDROOM 180

515 227-P

NOT TO SCALE

LOT 17

COUNTY #

SOIL PROFILE 664

0'
Orange-brown clay 1m
4'
tan-biege sandy loam
40-60% mica schist
10'5" HARD BOTTOM

663


>50% ROCK FRAGS PER Mr. SHARP

BACKHOE REFUSAL

B

red-brown clay 1m

6'5"
orange-brown fine sandy loam
20-30% mica schist
12'

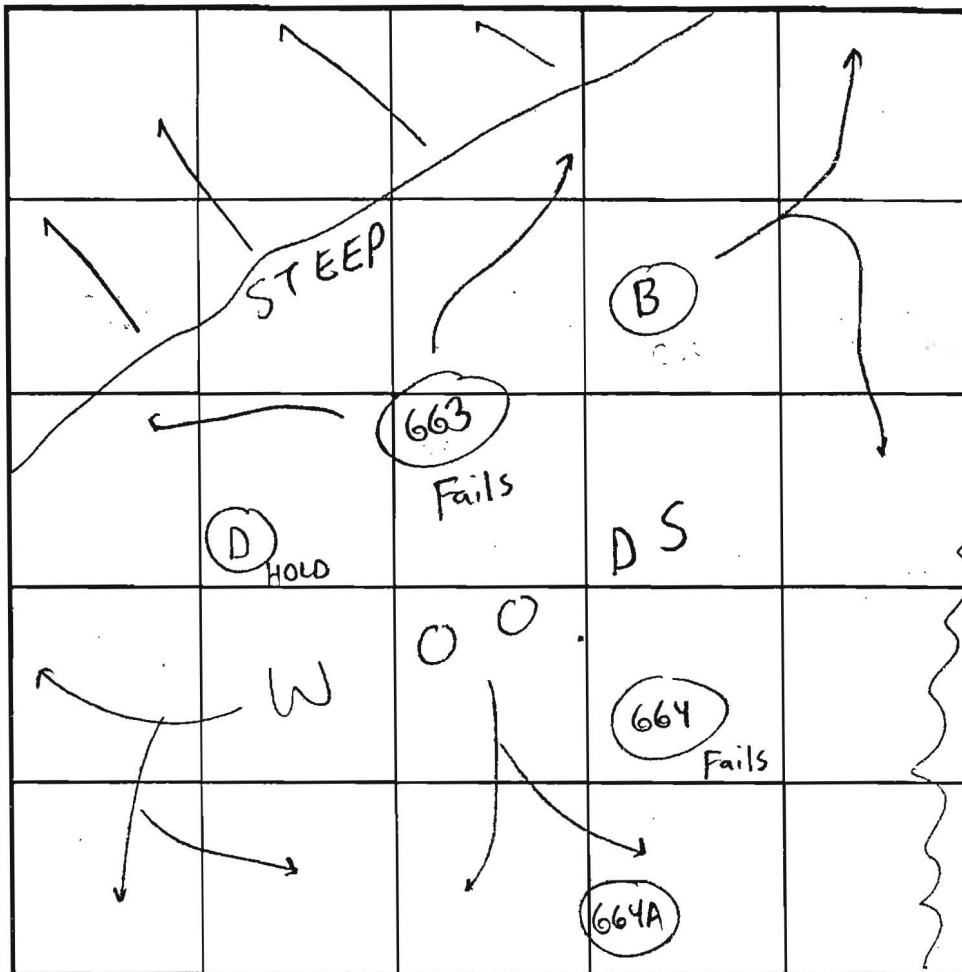

SOIL PROFILE D

0'
HOLD FOR RE-EXCAVATION AT LATER DATE
BACKHOE REFUSAL

10'5" 664A

Orange-brown clay

4' tan-silt loam 10-20%

13'

INDICATE NORTH - NAME ADJOINING ROADWAY AS BASE LINE.

DATE	TEST NO.	DEPTH	PRE-WET		TEST - 1" DROP		TIME		
			START	STOP	START	STOP			
6/6/01	664	10'5" V	>50%	ROCK FRAGS			NA	Fail	
			(Insufficient Soil Buffer Assuming a Trench Bottom at 7')						
	663	7' V	>50%	ROCK FRAGS			NA	Fail	
			BACK FILLED PRIOR TO EVALUATION						
	B	12' V	(VISUAL OK)	SEE SOIL PROFILE				OK	
	PD	10'5" V	(NEEDS TIME FOR RE-EVAL.)						HOLD
			TEST RESULTS UNKNOWN						
8/6/01	664A	13' V	(VISUAL OK)	SEE SOIL PROFILE				OK	

REMARKS Proposed Lot 23 may need additional evaluation


TYPE OF SOIL Glenelg & Manor

TESTED BY SRK Todd Parks = Backhoe
Chuck Sharp

ALSO PRESENT

TRENCH DESIGN DATA: AVERAGE PERCOLATION TIME _____ TRENCH WIDTH 3'

INLET DEPTH 3' MAXIMUM BOTTOM DEPTH 5' SQ. FT./BEDROOM _____

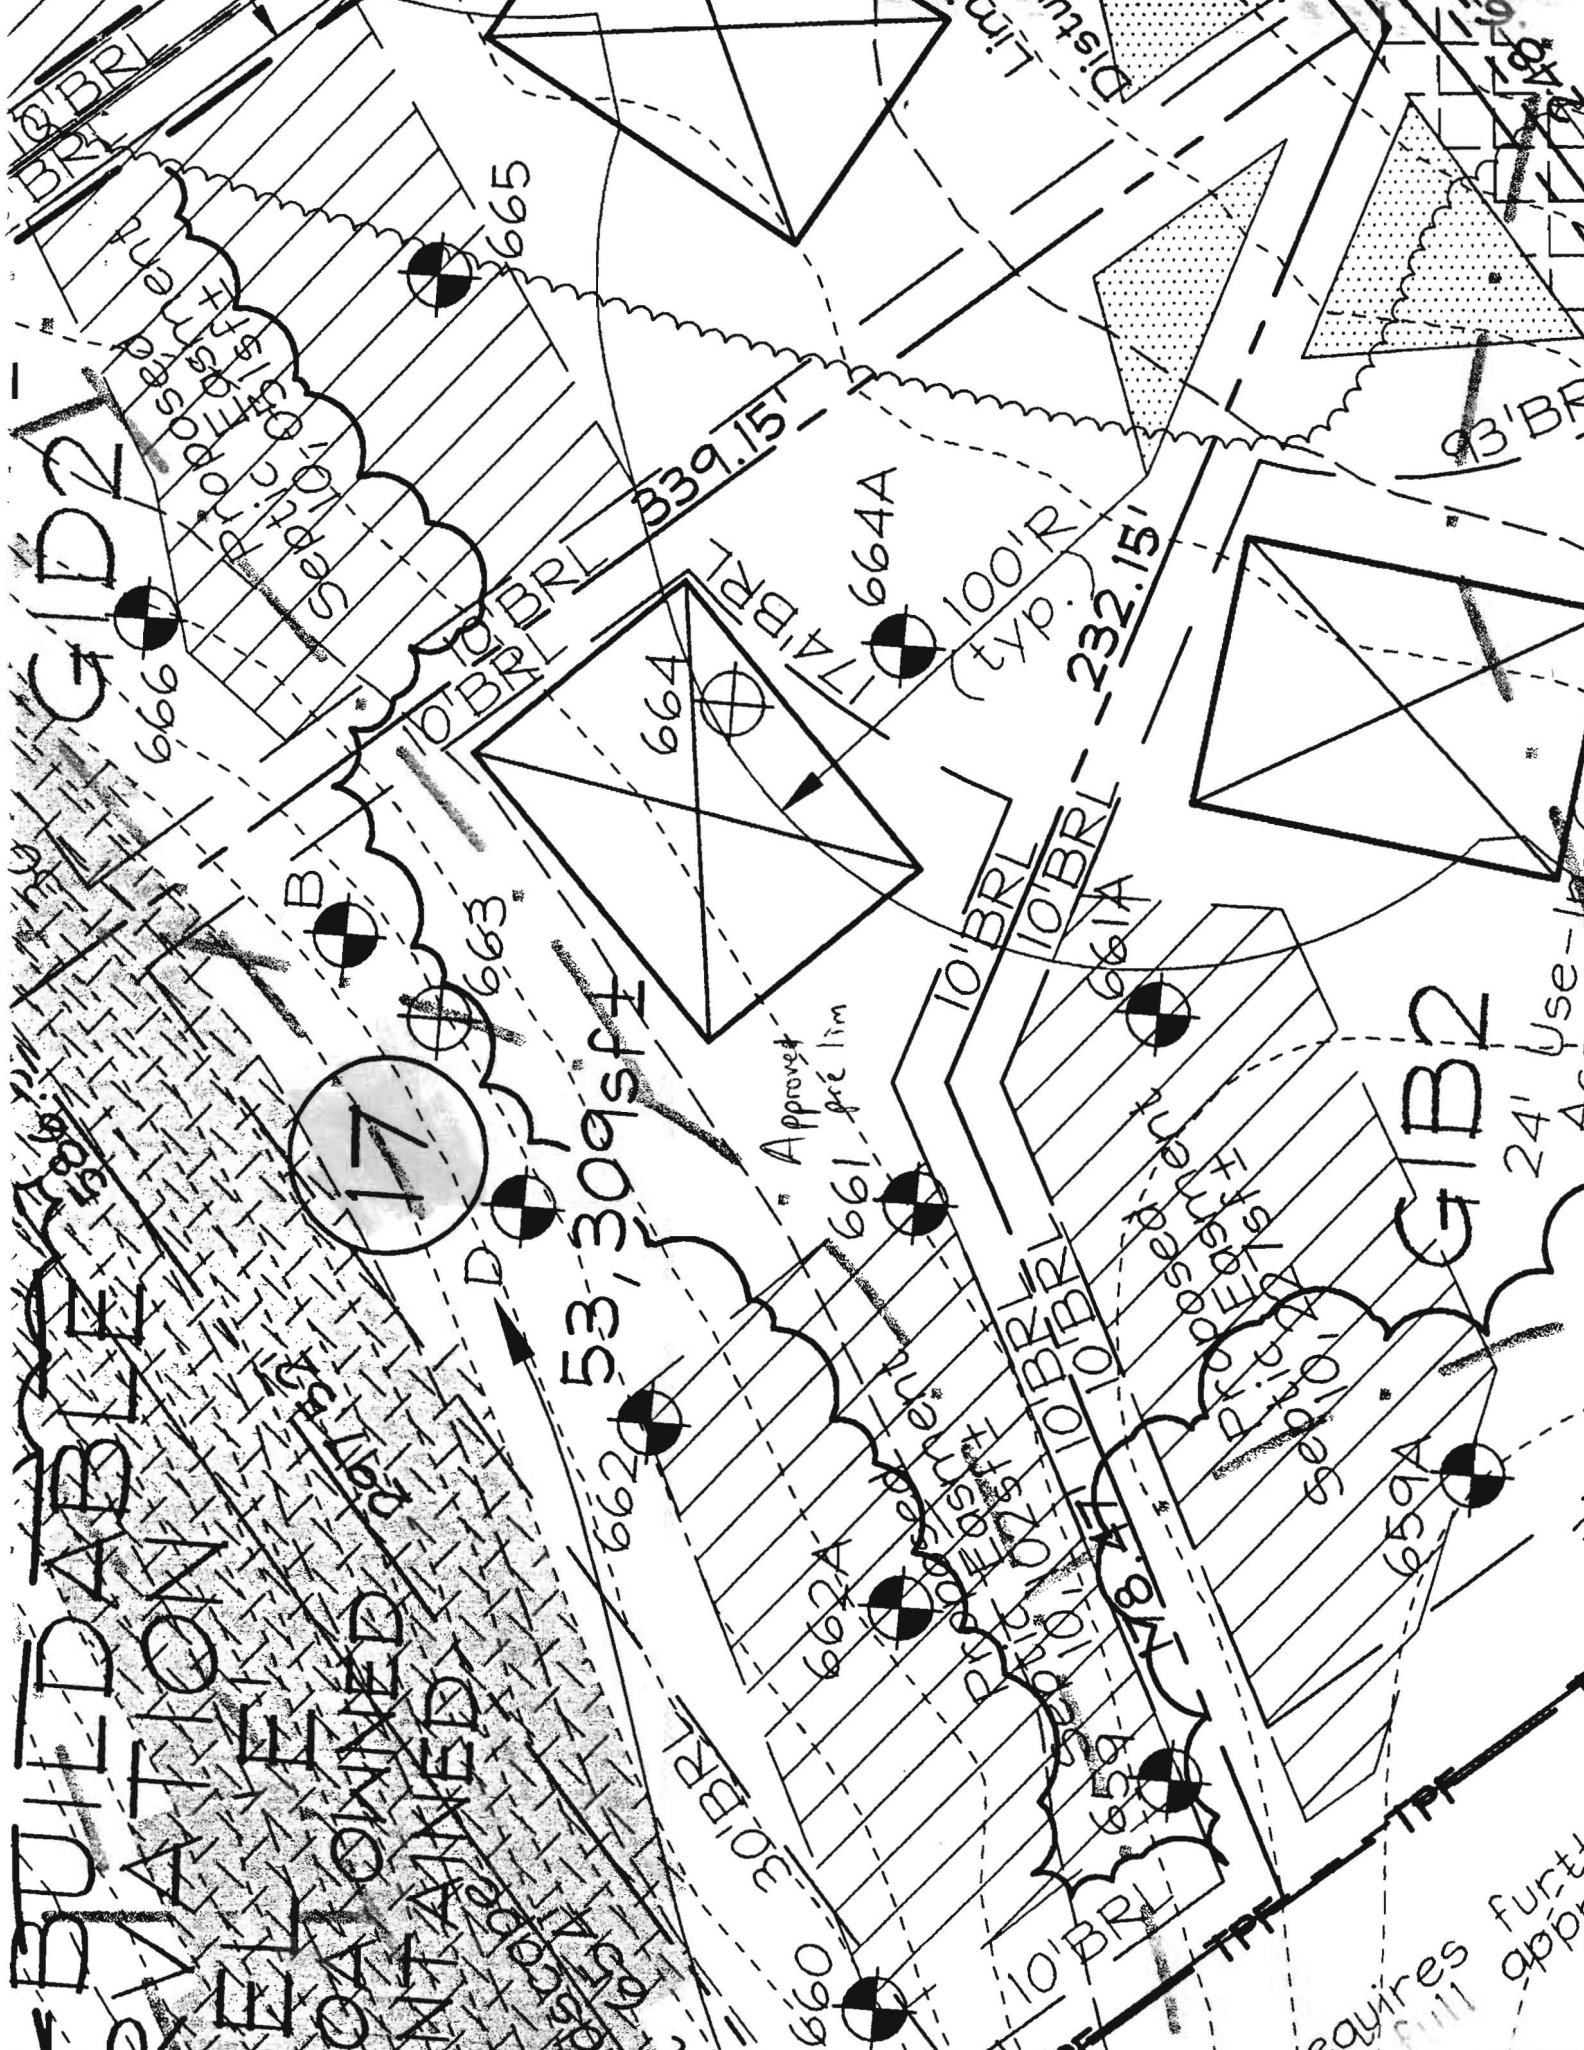

G1D2

G1B2

53,309sf

17

BUILDABLE
 PLATON
 ATTAINED
 ATTAINED

30' BRL

10' BRL

100' R
 Typ.

10' BRL

10' BRL

10' BRL

339.15'

232.15'

664

664A

663

Approved
 661 pre lim

662A

662

660

661A

659A

665

666

667

requires further approval

24' Use - 1/4" - Copy

Septic
 10' Offset
 10' Offset
 10' Offset

Proposed Electric
 Proposed Water

Proposed Electric
 Proposed Water

Proposed Electric
 Proposed Water

Proposed Electric
 Proposed Water

Disturb
 Limit

Disturb
 Limit

