

PERMIT

file approved 6-4-75

SEWAGE DISPOSAL SYSTEM

MARYLAND STATE DEPARTMENT OF HEALTH

HOWARD COUNTY

INDEXED

ELLCOTT CITY

DISTRICT

DATE 6/4/75

 IS PERMITTED TO INSTALL ALTER

ADDRESS 14010 Forsythe Road, Sykesville, Md, 21784 PHONE

A SEWAGE DISPOSAL SYSTEM LOCATED AT

SUBDIVISION ROAD 10245 Impwood Drive

PROPERTY OWNER Mr. John Labruski

ADDRESS 10245 Impwood Drive, Ellicott City, Md.

SPECIFICATIONS

DRAIN FIELD _____ DEPTH _____ FEET. BOTTOM AREA _____ SQ. FT.

SEWAGE PITS _____ ADOBEWENT SIDE-WALL AREA _____ SQ. FT.

SEPTIC TANK CAPACITY _____ GALLONS

FOR GARBAGE GRINDER, INCREASE DISPOSAL AREA 25% & TANK CAPACITY 50%.

OTHER REPAIR - CALL for inspection when ground is opened to see condition

see enclosed report system.

*Install 11' x 35' concrete septic tank
to be located on 1 truck 35' long, 11' deep, 2' wide, 6" of
gravel located off existing lawn field. Call for inspection
after gravel is installed. 11R 6-4-75*


PLANS APPROVED BY James P. Wise DATE 6/4/75

FILL SEPTIC TANK AND DISTRIBUTION BOX WITH WATER BEFORE CALLING FOR AN INSPECTION. COVER NO WORK UNTIL INSPECTED AND APPROVED.

NEITHER THE HOWARD COUNTY COMMISSIONERS NOR THE HEALTH DEPARTMENT IS RESPONSIBLE FOR THE SUCCESSFUL OPERATION OF ANY SYSTEM.

Palcos

A 21608 515 2010

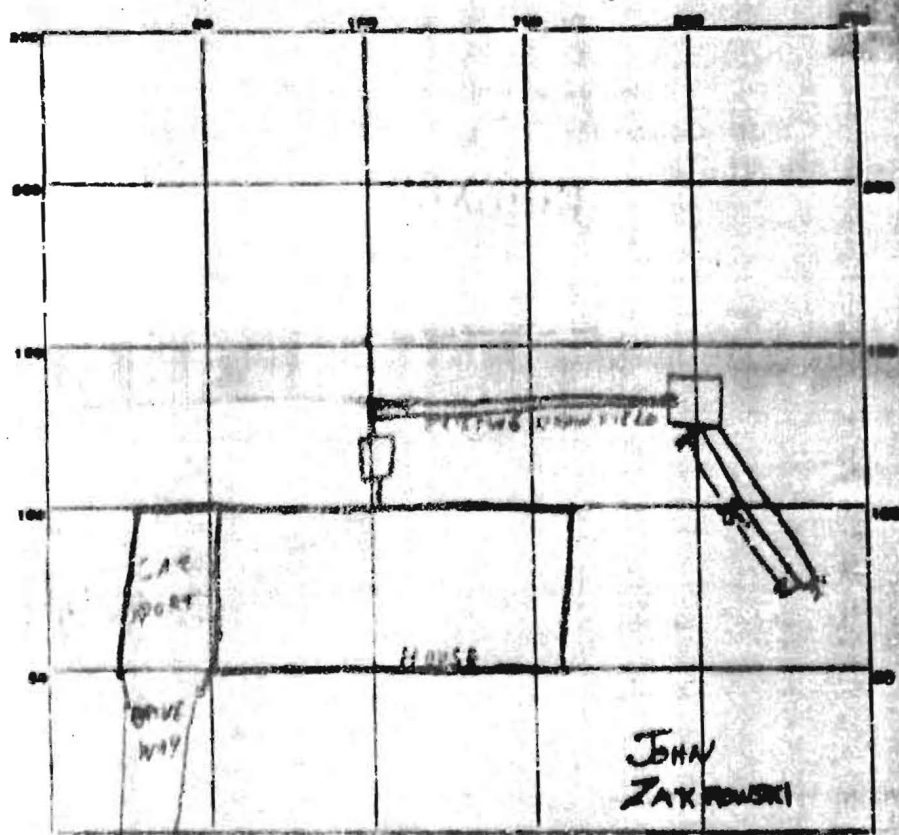

INDICATE NORTH NAME ADJOINING ROADWAY AS SIDE LINE. #10145 Bad house inst. from 99

PERMIT CARD PRESAT

SEPTIC TANK LEVEL EXISTING CLEANOUTS N/A

DISTRIBUTION BOX LEVEL N/A

TRENCH DEPTH 11 1/2 FT. TRENCH WIDTH 2 FT.

GRAVEL DEPTH 6 IN. TOTAL LENGTH 35 FT.

NUMBER OF TRENCHES 1 TOTAL BOTTOM AREA 70' x 2' UNDATED

SEEPAGE PITS. EXISTING PERMITS 48 FT. DEPTH BELOW INLET 6 FT.

ABSORBENT AREA 288 210 SQ. FT. TOTAL ABSORBENT AREA = 498 SQ. FT.

REMARKS SEWERAGE OF OVERFLOW FROM DRAIN FIELD INTO SEWERAGE PIT. 6 FT. STAGE IS IN TRENCH UNDER PILE. GROUND IS OF SANDY POROUS NATURE. NO LID OF PIT IS SECURE DUE TO BECAUSE OF WATER.

DATE SYSTEM APPROVED March 4, 1975 INSPECTOR H. L. Slav

515201-8