

12/21/72

PERMIT

P 17757
A 16627

SEWAGE DISPOSAL SYSTEM

MARYLAND STATE DEPARTMENT OF HEALTH

HOWARD COUNTY

ELLCOTT CITY

INDEXED

DISTRICT 3rd

DATE 12/5/72

Karl W. Schaper IS PERMITTED TO INSTALL ALTER

ADDRESS 1221 Marriottsville, Road, Marriottsville, Md. PHONE 944-7486

A SEWAGE DISPOSAL SYSTEM LOCATED AT

SUBDIVISION ROAD 1221 Marriottsville Road LOT 3

PROPERTY OWNER Karl W. Schaper

ADDRESS 2510 Poplar Drive, Woodlawn, Md.

SPECIFICATIONS 3 bedrooms

DRAIN FIELD DEPTH FEET, BOTTOM AREA SQ. FT.

SEEPAGE PITS ABSORBENT SIDE-WALL AREA SQ. FT.

SEPTIC TANK CAPACITY 1000 GALLONS

FOR GARBAGE GRINDER, INCREASE DISPOSAL AREA 22% & TANK CAPACITY 50%.

OTHER DRY WELL - 500 sq. ft. sidewall area below inlet. Dry well inlet to be no deeper than 5 ft. and bottom of dry well to be no deeper than 12 ft. Place the dry well 100 ft. from the lot line which is 167 ft. long and runs S 82° 38' 02" E and 30 ft. from the lot line which is 325 ft. long and runs between Lot 2 and Lot 3.

NOTE: ALL PIPE FROM HOUSE TO SEPTIC TANK MUST BE CAST IRON.

PERMIT VOID AFTER THREE YEARS.


NOTE: INSTALL STAND PIPE ON SEPTIC TANK AND DRY WELL.

PLANS APPROVED BY Raymond Hodges DATE 8/17/72

FILL SEPTIC TANK AND DISTRIBUTION BOX WITH WATER BEFORE CALLING FOR AN INSPECTION. COVER NO WORK UNTIL INSPECTED AND APPROVED.

NEITHER THE HOWARD COUNTY COMMISSIONERS NOR THE HEALTH DEPARTMENT IS RESPONSIBLE FOR THE SUCCESSFUL OPERATION OF ANY SYSTEM.

A 16627

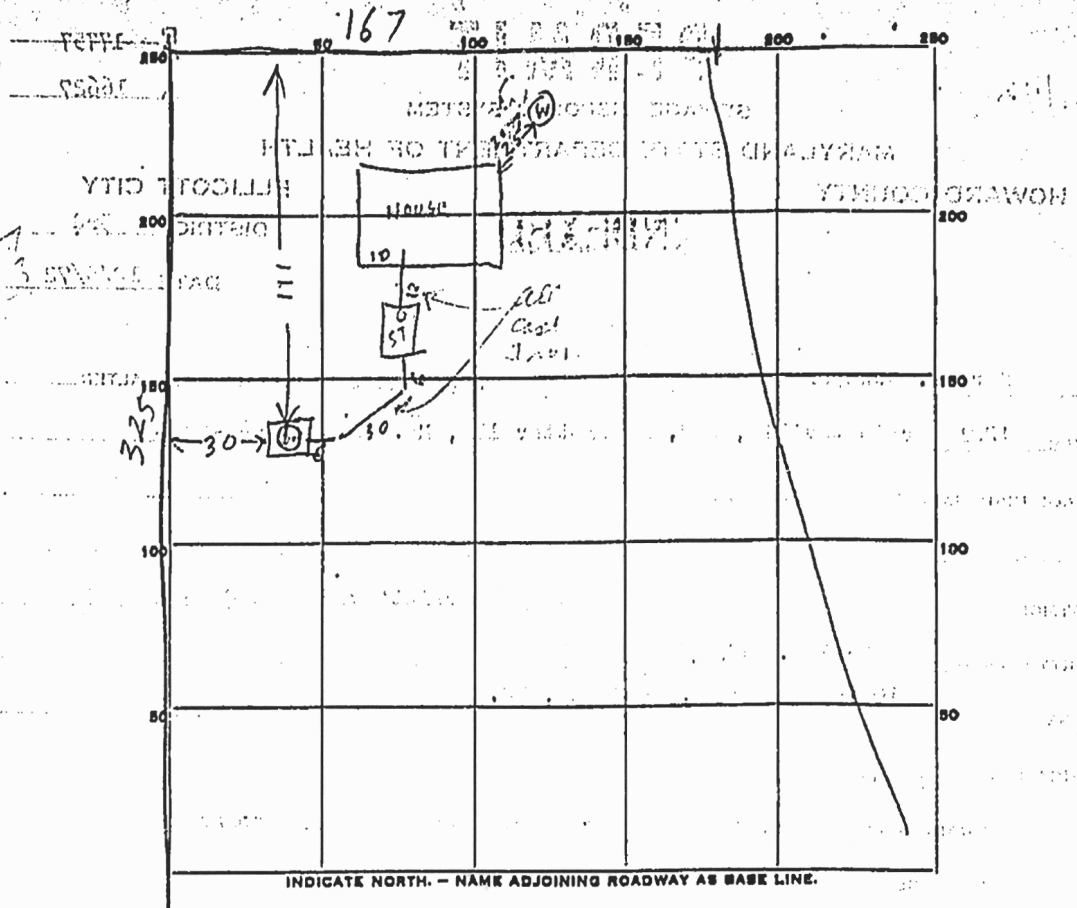

PERMIT CARD _____

SEPTIC TANK, LEVEL 17576 4-2-16 CLEANOUTS OK

DISTRIBUTION BOX, LEVEL _____

TILE FIELD, DEPTH _____ FT. TRENCH WIDTH _____ FT.

GRAVEL DEPTH _____ IN. TOTAL LENGTH _____ FT.

NUMBER OF TRENCHES _____ TOTAL BOTTOM AREA _____

SEEPAGE PITS, INSIDE DIAMETER 12 FT. DEPTH BELOW INLET 10 FT.

ABSORBENT AREA 520 SQ. FT. 3.70 not counting stone

REMARKS 12/21/72 - 12' deep well, 3 FT below ground
Revised 12/21/72 - 52 FT

DATE SYSTEM APPROVED 12/21/72 INSPECTOR Raymond H. Hodge

APPLICATION

A 16627

SEWAGE DISPOSAL TESTING

P _____

MARYLAND STATE DEPARTMENT OF HEALTH

HOWARD COUNTY

ELLICOTT CITY

DISTRICT 3

DATE 12/21/71

TO: THE COUNTY HEALTH OFFICER
ELLICOTT CITY, MARYLAND

I, HEREBY, APPLY FOR THE NECESSARY TESTS IN ORDER TO CONSTRUCT (OR RECONSTRUCT) A SEWAGE DISPOSAL SYSTEM.

PROPERTY OWNER Karl W. Schaper

ADDRESS 2510 Poplar Drive, Woodlawn, Maryland PHONE 944-7486

PROPERTY LOCATION:

SUBDIVISION _____ LOT NO. 3

ROAD AND DESCRIPTION Marriontsville Rd., approximately 1/4 mile North of Route 99

First entrance on right after two brick piers on left.

OCCUPANT _____ PHONE _____

PERSON TO CONSTRUCT SYSTEM _____

ADDRESS _____ PHONE _____

SIZE OF LOT 1.995 acres TYPE BLDG. 3
NUMBER OF BEDROOMS

IF NOT SINGLE RESIDENCE DESCRIBE _____

SIGNATURE OF APPLICANT /s/ Karl W. Schaper

APPROVED BY _____ FOR _____ DATE _____
(KIND OF SYSTEM)

REJECTED BY _____ FOR _____ DATE _____
(KIND OF SYSTEM)


HOLD PENDING FURTHER TESTS _____ DATE _____

REASONS FOR REJECTION OR HOLDING _____

THIS IS NOT A PERMIT

APPLICANT

APPLICANT

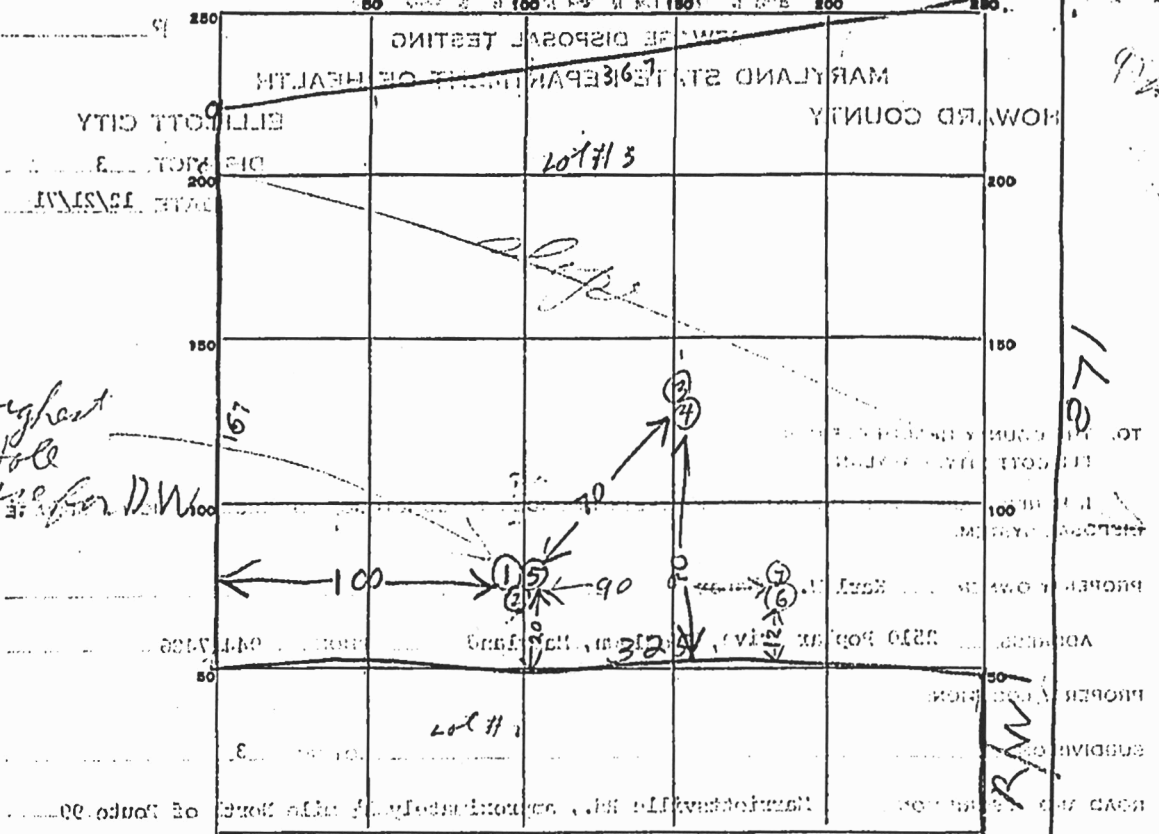

INDICATE NORTH. - NAME ADJOINING ROADWAY AS BASE LINE.

DATE	TEST NO.	DEPTH	PRE-WET		TEST - 1" DROP		TIME
			START	STOP	START	STOP	
12/21/71	1	11	1135	1139	1139	1154	15
12/22/71	2	4 1/2	1240	1240	little		
E 1	3	10	1214	1213	1213	1245	32
	4	4	1204	1245	little		
	5	6 1/2	211	217	217	237	20
8/14/72	6	5 1/2	1557	1557	1557	159	2
	7	11 1/2	200	203	203	205	2

SOIL AUGER FINDING

TESTED BY *R. J. Heiger*

REMARKS

1071