

STATE OF MARYLAND
 DEPARTMENT OF WATER RESOURCES
 STATE OFFICE BLDG., ANNAPOLIS, MARYLAND 21401
WELL COMPLETION REPORT

THIS REPORT MUST BE SUBMITTED WITHIN 30 DAYS AFTER WELL COMPLETION
 FILL IN THIS FORM COMPLETELY
 COUNTY NUMBER Allegany
 PERMIT NO. FROM "PERMIT TO DRILL WELL" 40-27-27-1013
 28 29 30 31 32 33 34 35 36 37
 DRILLER'S IDENTIFICATION NO. 251

OWNER chapar FIRST NAME Karl JR.
 LAST NAME 11 Bout Hill RD POST OFFICE YKOSVILLE MD. 21784
 STREET OR RFD.

WELL DESCRIPTION
 STATE THE KIND OF FORMATIONS PENETRATED, THEIR COLOR, DEPTH, THICKNESS AND IF WATER BEARING
 DESCRIPTION (USE ADDITIONAL SHEETS IF NECESSARY)
 FEET FROM TO CHECK IF WATER BEARING
 25 ft of dirt & 75 ft of gray rock


GROUTING RECORD
 WELL HAS BEEN GROUTED (CIRCLE APPROPRIATE BOX) YES NO
 TYPE OF GROUTING MATERIAL (CIRCLE BOX) CEMENT BENTONITE CLAY
 NO. OF BAGS 7 NO. OF POUNDS 700
 GALLONS OF WATER 65
 DEPTH OF GROUT SEAL (TO NEAREST FOOT) FROM 0 FT. TO 25 FT.
CASING RECORD
 MAIN CASING TYPE T NOMINAL DIAMETER TOP (MAIN) CASING (NEAREST INCH) 6.0 TOTAL DEPTH OF MAIN CASING (NEAREST FOOT) 25
SCREEN RECORD
 SCREEN TYPE OR OPEN HOLE (CIRCLE APPROPRIATE BOX) STEEL BRASS OR BRONZE OPEN HOLE PLASTIC OTHER

PUMPING TEST
 HOURS PUMPED (TO NEAREST HOUR) 2
 PUMPING RATE (GALLONS PER MINUTE TO NEAREST GALLON) 1
 METHOD USED TO MEASURE PUMPING RATE 4
 WATER LEVEL: (DISTANCE FROM LAND SURFACE) BEFORE PUMPING 30 (NEAREST FOOT) WHEN PUMPING 75 (NEAREST FOOT)
 TYPE OF PUMPED USED (CIRCLE APPROPRIATE BOX) (FOR PUMPING TEST) AIR PISTON TURBINE CENTRIFUGAL ROTARY OTHER (DESCRIBE BELOW) JET SUBMERSIBLE

PUMP INSTALLED
 TYPE OF PUMP (WRITE APPROPRIATE LETTER IN BOX - SEE ABOVE: A, C, J, P, R, S, T, O) 29
 DRILLER WILL INSTALL PUMP (CIRCLE APPROPRIATE BOX) YES NO
 CAPACITY: GALLONS PER MINUTE (TO NEAREST GALLON) 31 35
 PUMP HORSE POWER 37 41
 PUMP COLUMN LENGTH (NEAREST FOOT) 43 47
CASING HEIGHT (CIRCLE APPROPRIATE BOX AND ENTER CASING HEIGHT) ABOVE BELOW
 LAND SURFACE 2 (NEAREST FOOT)

CIRCLE APPROPRIATE BOXES
 A WELL WAS ABANDONED AND SEALED WHEN THIS WELL WAS COMPLETED
 E ELECTRIC LOG OBTAINED
 P TEST WELL CONVERTED TO PRODUCTION WELL
 I HEREBY CERTIFY THAT I HAVE COMPLIED WITH ALL CONDITIONS STATED ON THE ABOVE-CAPTIONED "PERMIT TO DRILL WELL", AND THAT INFORMATION CONTAINED IN THIS REPORT IS TRUE, ACCURATE, AND COMPLETE TO THE BEST OF MY KNOWLEDGE, INFORMATION AND BELIEF.
 DRILLERS NAME Robert D. Edmondson
 PLEASE PRINT SIGNATURE Robert D. Edmondson

DEPTH (NEAREST WHOLE FOOT)
 FROM TO
 1 2 3 4 5 6 7 8 9 10 11 12 13 14 15 16 17 18 19 20 21 22 23 24 25 26 27 28 29 30 31 32 33 34 35 36 37 38 39 40 41 42 43 44 45 46 47 48 49 50 51
 SLOT SIZE 1, 2, 3
 DIAMETER OF SCREEN (NEAREST INCH) FROM TO
 GRAVEL PACK
 IF WELL DRILLED WAS A FLOWING WELL CIRCLE BOX F
 DWR USE ONLY (NOT TO BE FILLED IN BY DRILLER) (C.R.O.S.) TELESCOPE CASING LOG INDICATOR OTHER DATA AVAILABLE

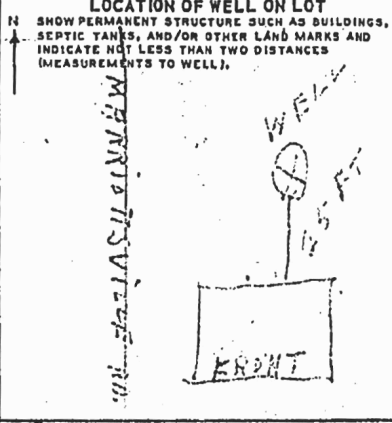

RT 99