

B 1 2447

SEQUENCE NO. (MDE USE ONLY)

STATE OF MARYLAND APPLICATION FOR PERMIT TO DRILL WELL W517988 please type

STATE PERMIT NUMBER

HO-94-3583 fill in this form completely

Date Received (APA)

11 6 02

OWNER INFORMATION

ADAMS MORGAN, 15055 Bushy Park Rd., WOODBINE MD. 21797


B 3 LOCATION OF WELL

Howard COUNTY, ADAM'S Prop SUBDIVISION, parcel 24, COOKSVILLE NEAREST TOWN, 3 MILES FROM TOWN

DRILLER INFORMATION

Ralph E. MAYNE M SD 117, Firm Name: Ralph E. MAYNE (well drilling), Address: 17024 Handy Rd. Mt Airy MD. 21771, Date: Oct 25 2002

B 4 DIRECTION OF WELL FROM TOWN (CIRCLE BOX)

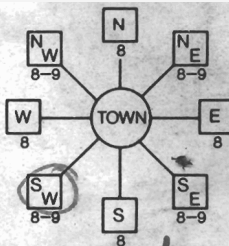

Kew wood Ct., NEAR WHAT ROAD, ON WHICH SIDE OF ROAD (CIRCLE APPROPRIATE BOX), DISTANCE FROM ROAD 200 FT, TAX MAP: 14 BLK: 3/4 PARCEL 24

B 2 WELL INFORMATION, APPROX. PUMPING RATE 5 GAL. PER MIN., AVERAGE DAILY QUANTITY NEEDED 500 GAL. PER DAY

USE FOR WATER (CIRCLE APPROPRIATE BOX)

- DOMESTIC POTABLE SUPPLY & RESIDENTIAL IRRIGATION (circled), FARMING (LIVESTOCK WATERING & AGRICULTURAL IRRIGATION), INDUSTRIAL, COMMERCIAL, DEWATERING, PUBLIC WATER SUPPLY WELL, TEST, OBSERVATION, MONITORING, GEO-THERMAL

Cancelled New Permit Issued to Fogel

NOT TO BE FILLED IN BY DRILLER HEALTH DEPARTMENT APPROVAL, Howard COUNTY NAME, STATE SIGNATURE, DATE ISSUED 12 4 02, CO SIGNATURE Steven R. King, EXP. DATE 12 4 03, EAST GRID 539, NORTH GRID 791

APPROXIMATE DEPTH OF WELL 150 FEET, APPROXIMATE DIAMETER OF WELL 6" NEAREST INCH


METHOD OF DRILLING (circle one)

- BORED (or Augered), JETTED, Jetted & DRIVEN, AIR-ROTary, AIR-PERCussion, ROTARY (Hydraulic Rotary), CABLE, REVerse-ROTary, Drive-POINT

REPLACEMENT OR DEEPEINED WELLS (CIRCLE APPROPRIATE BOX)

- THIS WELL WILL NOT REPLACE AN EXISTING WELL (circled), THIS WELL WILL REPLACE A WELL THAT WILL BE ABANDONED AND SEALED, THIS WELL WILL REPLACE A WELL THAT WILL BE USED AS A STANDBY-CONTACT LOCAL APPROVING AUTHORITY FOR POLICY ON STANDBY WELLS, THIS WELL WILL DEEPEIN AN EXISTING WELL

SHOW MAJOR FEATURES OF BOX & LOCATE WELL WITH AN X, SOURCES OF DRILLING WATER: 1. well, WRITE THE BOX NUMBER FROM THE MAP HERE: E 54039, N 7901

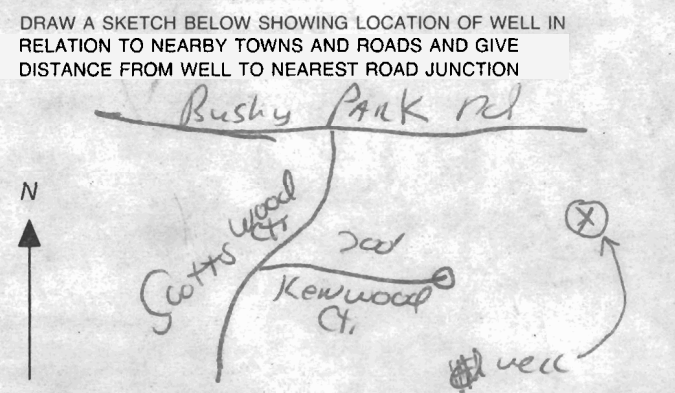

Not to be filled in by driller (MDE OR COUNTY USE ONLY), APPROP. PERMIT NUMBER G, PERMIT No. HO-94-3583

SPECIAL CONDITIONS NOTE - APPROVING AUTHORITIES SHOULD USE SEPARATE SHEET IF NEEDED