

ISSUE DATE: 1/15/2002

P 516469-A

APPROVAL DATE: 1/16/02

A REPAIR

PERMIT INDEXED

ON-SITE SEWAGE DISPOSAL SYSTEM HOWARD COUNTY HEALTH DEPARTMENT BUREAU OF ENVIRONMENTAL HEALTH

04-321642

Jack Fyock Septic Service _____ IS PERMITTED TO INSTALL ALTER

ADDRESS: 13775 Triadelphia Rd., Glenelg PHONE NUMBER: 410-988-9270

SUBDIVISION: _____ LOT NUMBER: _____

ADDRESS: 14581 Mac Clintock Drive PROPERTY OWNER: Lofgren

SEPTIC TANK CAPACITY (GALLONS): _____

PUMP CHAMBER CAPACITY (GALLONS): _____

NUMBER OF BEDROOMS: _____

SQUARE FEET PER BEDROOM: _____

LINEAR FEET OF TRENCH REQUIRED: _____

TRENCHES:	Trench to be _____ feet wide. Inlet _____ feet below original grade. Bottom maximum depth _____ feet below original grade. Effective area begins at _____ feet below original grade. _____ feet of stone below distribution pipe.
LOCATION:	
PURPOSE:	Existing septic system failed. Call for inspection when ground is opened so sanitarian can recommend repair. <u>Ex. metal tank to be repl.</u>

PLANS APPROVED: Brian Baker DATE: 1/14/2002


- NOTE: PERMIT VOID AFTER 2 YEARS
- NOTE: CONTRACTOR RESPONSIBLE FOR SCHEDULING A PRE-CONSTRUCTION INSPECTION FOR ALL INSTALLATIONS
- NOTE: WATERTIGHT SEPTIC TANKS REQUIRED
- NOTE: ALL PARTS OF SEPTIC SYSTEM SHALL BE 100 FEET FROM ANY WATER WELL
- NOTE: MANHOLE RISERS REQUIRED ON ALL SEPTIC TANKS AND PUMP CHAMBERS

NEITHER THE HOWARD COUNTY COUNCIL NOR THE HEALTH DEPARTMENT IS RESPONSIBLE FOR THE SUCCESSFUL OPERATION OF ANY SYSTEM PERMITTEE RESPONSIBLE FOR OBTAINING FINAL APPROVAL ON THIS PERMIT CALL 410-313-2640 FOR INSPECTION OF SEPTIC SYSTEM

516469-A

NOT TO SCALE

□ ← Pit Well

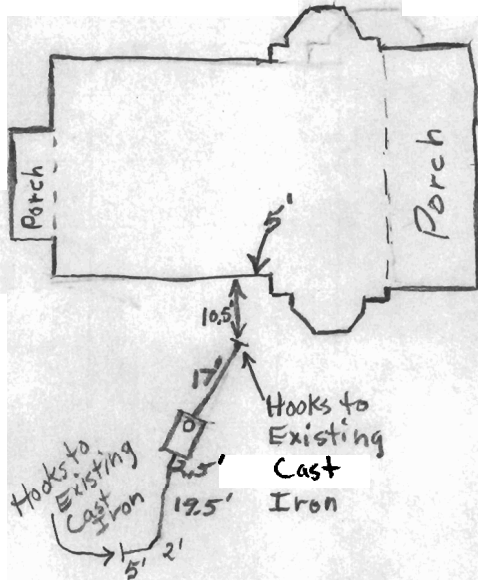

MacClintock Drive

ROAD

TRENCH/DRAINFIELD DATA		
WIDTH	INLET	BOTTOM
_____	_____	_____
NUMBER OF TRENCHES _____		
TOTAL LENGTH _____		
ABSORPTION AREA _____		
DISTRIBUTION BOX LEVEL _____		
DISTRIBUTION BOX BAFFLE _____		
DISTRIBUTION BOX PORT _____		

SEPTIC TANK DATA	
SEPTIC TANK 1 LEVEL _____	
CAPACITY	<u>1250</u> GAL
SEAM LOC	<u>TS</u>
TANK LID DEPTH	_____
BAFFLES	_____
BAFFLE FILTER	_____
MANHOLE LOC	_____
6" PORT LOC	<u>Front</u>
WATERTIGHT TEST	_____
SEPTIC TANK 2 LEVEL _____	
CAPACITY	_____ GAL
SEAM LOC	_____
TANK LID DEPTH	_____
BAFFLES	_____
BAFFLE FILTER	_____
MANHOLE LOC	_____
6" PORT LOC	_____
WATERTIGHT TEST	_____

PRE-CONSTRUCTION _____

INSTALLATION 1/16/02 Old metal tank pumped and filled with dirt.
O.K. to cover new tank and lines. (BB)

FINAL INSPECTOR Brian Baker DATE OF APPROVAL 1/16/02

Repair Septic

1/14/02

14581 MacCintock Drive


JACK FLOCK

CLARE (410) 988-9270

Loefgren - (owner's last name)

NO INDEX CARD - CAN'T LOCATE
file 1/14/2002

Click here for a plain text ADA compliant screen.

	Maryland Department of Assessments and Taxation HOWARD COUNTY Real Property Data Search	Go Back View Map New Search
---	--	---

Account Identifier: District - 04 **Account Number - 321642**

Owner Information

Owner Name:	LOFGREN LETCHER A & WF	Use:	RESIDENTIAL
		Principal Residence:	YES
Mailing Address:	PO BOX 7 GLENWOOD MD 21738-0007	Deed Reference:	1) / 527/ 577 2)

Location & Structure Information

Premises Address		Zoning	Legal Description
14581 MACCLINTOCK DR GLENWOOD 21738		RRDEO	2 ACRES 14581 MACCLINTOCK DR GLENWOOD
Map	Grid	Parcel	Subdivision
21	4	125	
			Section
			Block
			Lot
			Group
			81
			Plat No:
			Plat Ref:
Special Tax Areas		Town Ad Valorem Tax Class	NO A/V, NO M/P, RURAL FIRE TAX
Primary Structure Built		Enclosed Area	Property Land Area
0000		3,874 SF	2.00 AC
Stories	Basement	Type	Exterior
2	YES	STANDARD UNIT	FRAME

Value Information

	Base Value	Value As Of	Phase-in Assessments	
			As Of	As Of
			07/01/2001	07/01/2002
Land:	100,000	150,000		
Improvements:	128,410	147,570		
Total:	228,410	297,570	228,410	251,463
Preferential Land:	0	0	0	0

Transfer Information

Seller:	Date:	Price:
Type:	Deed1:	Deed2:
Seller:	Date:	Price:
Type:	Deed1:	Deed2:
Seller:	Date:	Price:
Type:	Deed1:	Deed2:

Exemption Information

Partial Exempt Assessments	Code	07/01/2001	07/01/2002
County	000	0	0
State	000	0	0
Municipal	000	0	0

Tax Exempt: NO
Exempt Class:

Special Tax Recapture:

* NONE *