

# APPLICATION

A 24840

## SEWAGE DISPOSAL TESTING

P \_\_\_\_\_

STATE OF MARYLAND - DEPARTMENT OF HEALTH AND MENTAL HYGIENE

HOWARD COUNTY HEALTH DEPARTMENT  
ENVIRONMENTAL HEALTH SERVICES

DISTRICT 5th

P. O. BOX 476, ELLICOTT CITY, MARYLAND 21043  
TELEPHONE: 465-5000, EXT. 356

*Septic tank 3 BR 1000 gal.  
4 BR 1250 gal.*

DATE 11/29/76

*Drywell located 150 ft. from front & 20 ft from street as seen  
when facing from road  
135 sq. ft. per bed room - Inlet 4 1/2 - 5 ft. below original grade  
max. effective depth to start at 5 ft., maximum total  
depth to be 10 1/2 ft. below original grade*

TO: THE COUNTY HEALTH OFFICER  
ELLICOTT CITY, MARYLAND

*drywell to have at least 250 sq. ft. & trench 4 BR 70 ft.  
3 BR 40 ft.*

I, HEREBY, APPLY FOR THE NECESSARY TEST IN ORDER TO CONSTRUCT (OR RECONSTRUCT) A SEWAGE  
DISPOSAL SYSTEM.

PROPERTY OWNER Joseph Judge

*avg. time for installation area  
4-2-79 7.7*

ADDRESS 6349 Amherst Avenue, Ellicott City, MD. PHONE 461-9288

PROPERTY LOCATION:

*New lot 6.*

SUBDIVISION \_\_\_\_\_ LOT NO. 8

ROAD AND DESCRIPTION 7032 Loganberry Drive

SIZE OF LOT \_\_\_\_\_ TYPE BLDG. 3 OR 4  
NUMBER OF BEDROOMS

IF NOT SINGLE RESIDENCE DESCRIBE \_\_\_\_\_

THE SYSTEM INSTALLED UNDER THIS APPLICATION IS ACCEPTABLE ONLY UNTIL PUBLIC  
FACILITIES BECOME AVAILABLE.

SIGNATURE OF APPLICANT /s/ Joseph Judge

BLDG. PERMIT SIGNED  
AND RETURNED 4/3/79  
*Serial No. 38690*

APPROVED BY Rgo Mar FOR DW 77-1923 DATE 11/15/77  
(KIND OF SYSTEM)

REJECTED BY \_\_\_\_\_ FOR \_\_\_\_\_ DATE \_\_\_\_\_  
(KIND OF SYSTEM)



HOLD PENDING FURTHER TESTS \_\_\_\_\_ DATE \_\_\_\_\_

REASONS FOR REJECTION OR HOLDING \_\_\_\_\_

# THIS IS NOT A PERMIT

Lot 8

115  
80  
2/195  
97

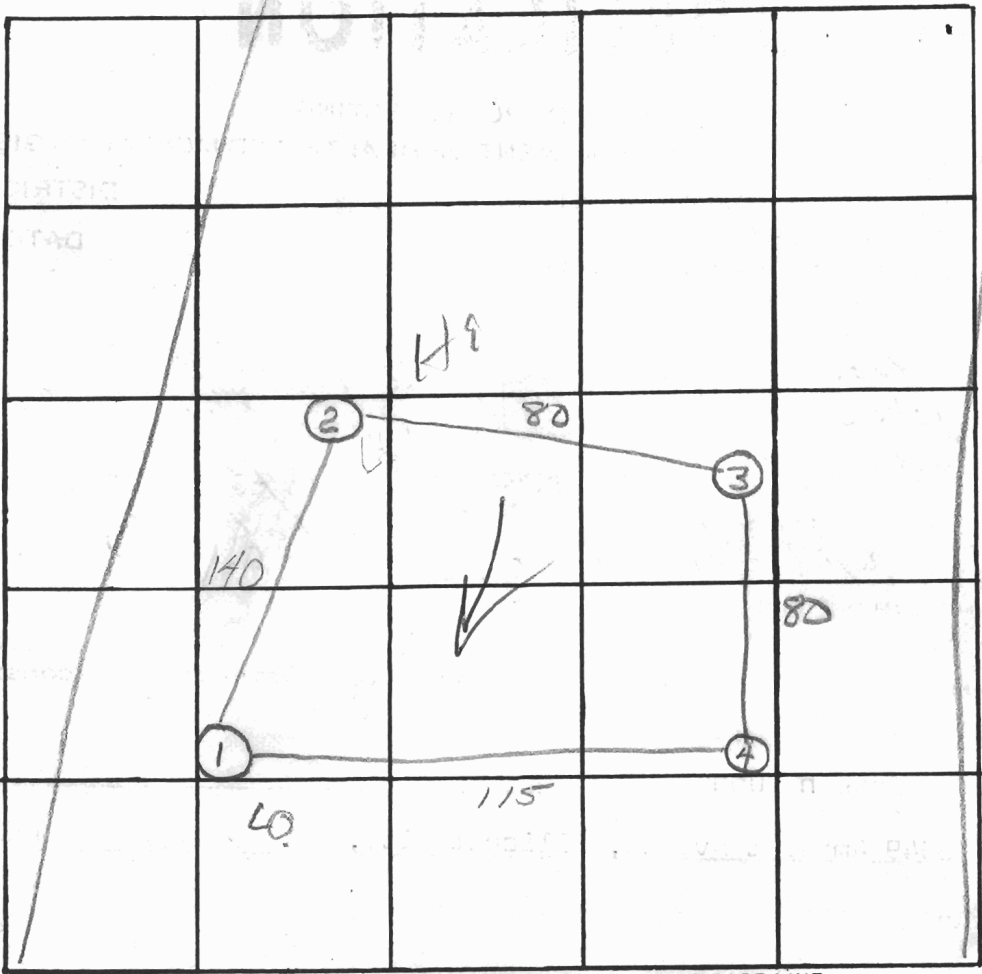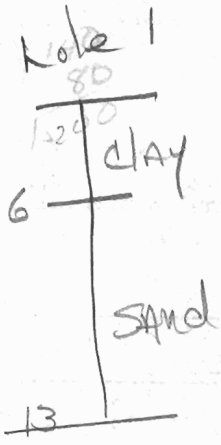

INDICATE NORTH. - NAME ADJOINING ROADWAY AS BASE LINE.

23  
3  
19

135  
7

DATE	TEST NO.	DEPTH	PRE-WET		TEST - 1" DROP		TIME
			START	STOP	START	STOP	
7-13-76	1 s	6	10:35	11:42	10:42	10:50	8
	1 d	13	10:35	10:43	10:43	10:50	7
	2 s	5	10:45	10:50	10:50	10:55	5
	2 d	11 1/2	10:42	10:55	10:55	11:15	20
	3 v	11 1/2					
	4 s	2 1/2	11:00	11:19			
	4 d	12 1/2	11:00	11:05	11:05	11:18	8
	4 sa	5	12:02	12:16	12:16	NO PERC	
	4 sb	6	12:58	11:00	1:00	1:09	9

5  
6

REMARKS \_\_\_\_\_

TYPE OF SOIL \_\_\_\_\_

TESTED BY nb ALSO PRESENT: \_\_\_\_\_

#6

1" = 100'

