

C1 1306

SEQUENCE NO. (OEP USE ONLY)

STATE OF MARYLAND WELL COMPLETION REPORT

THIS REPORT MUST BE SUBMITTED WITHIN 45 DAYS AFTER WELL IS COMPLETED.

(THIS NUMBER IS TO BE PUNCHED IN COES. 3-6 ON ALL CARDS)

COUNTY NUMBER A31462

Date Received (OEP use only)

DATE WELL COMPLETED

10/2/81

Depth of Well

300

(TO NEAREST FOOT)

PERMIT NO.

FROM "PERMIT TO DRILL WELL"

HO-73-4023

OWNER Johnson last name

Dewitt first name

STREET OR RFD 575 Manc

TOWN olum.

SUBDIVISION

SECTION

LOT

WELL LOG

Not required for driven wells

STATE THE KIND OF FORMATIONS PENETRATED, THEIR COLOR, DEPTH, THICKNESS AND IF WATER BEARING

Table with columns: DESCRIPTION, FEET (FROM, TO), Check if water bearing. Rows include TOP SOIL, SHALE, CLAY, SILT, SHALE, MICA, SANDSTONE, MICA, FLINT, MICA.

GROUTING RECORD

WELL HAS BEEN GROUTED (Circle Appropriate Box) YES [Y] NO [N]. TYPE OF GROUTING MATERIAL CEMENT [CM] BENTONITE CLAY [BC]. NO. OF BAGS 25 NO. OF POUNDS 2500. GALLONS OF WATER 125. DEPTH OF GROUT SEAL (to nearest foot) from 0 ft. to 30 ft.

CASING RECORD

MAIN CASING TYPE [ST] Nominal diameter top(main)casing (nearest inch) 6 Total depth of main casing (nearest foot) 38. OTHER CASING (if used) diameter mch depth (feet) from to.

SCREEN RECORD

screen type or open hole [ST] [BR] [HO] [PL] [OT]. STEEL BRASS BRONZE OPEN HOLE PLASTIC OTHER.

C 2 (Seq. no)

Table for screen depth and slot size. Columns: DEPTH (nearest ft.), SLOT SIZE. Rows 1, 2, 3.

DIAMETER OF SCREEN (NEAREST INCH) from to. GRAVEL PACK IF WELL DRILLED WAS FLOWING WELL CIRCLE BOX [F].

OEP USE ONLY (NOT TO BE FILLED IN BY DRILLER) T (E.R.O.S.) WQ 74 75 76. TELESCOPE CASING LOG INDICATOR OTHER DATA.

C 3 (Seq. no)

PUMPING TEST

HOURS PUMPED (nearest hour) 2. PUMPING RATE (gal. per min. to nearest gal.) 1. METHOD USED TO MEASURE PUMPING RATE. WATER LEVEL (distance from land surface) BEFORE PUMPING. WHEN PUMPING 300. TYPE OF PUMP USED (for test) [A] air [P] piston [T] turbine [C] centrifugal [R] rotary [O] other [J] jet [S] submersible.

PUMP INSTALLED

DRILLER WILL INSTALL PUMP (CIRCLE APPROPRIATE BOX) YES [Y] NO [N]. IF DRILLER INSTALLS PUMP, THIS SECTION MUST BE COMPLETED FOR ALL WELLS EXCEPT HOME USE. TYPE OF PUMP (WRITE APPROPRIATE LETTER IN BOX - SEE ABOVE: (A, C, J, P, R, S, T, O)). CAPACITY: GALLONS PER MINUTE (to nearest gallon). PUMP HORSE POWER. PUMP COLUMN LENGTH (nearest ft.).

CASING HEIGHT (circle appropriate box and enter casing height) [ + ] above [ - ] below. LAND SURFACE (nearest foot). LOCATION OF WELL ON LOT SHOW PERMANENT STRUCTURE SUCH AS BUILDING, SEPTIC TANKS, AND/OR LANDMARKS AND INDICATE NOT LESS THAN TWO DISTANCES (MEASUREMENTS TO WELL).

CIRCLE APPROPRIATE BOX A WELL WAS ABANDONED AND SEALED WHEN THIS WELL WAS COMPLETED [E] ELECTRIC LOG OBTAINED TEST WELL CONVERTED TO PRODUCTION WELL.

I HEREBY CERTIFY THAT THIS WELL HAS BEEN CONSTRUCTED IN ACCORDANCE WITH COMAR 10.17.13 "WELL CONSTRUCTION" AND IN CONFORMANCE WITH ALL CONDITIONS STATED IN THE ABOVE CAPTIONED PERMIT, AND THAT THE INFORMATION PRESENTED HEREIN IS ACCURATE AND COMPLETE TO THE BEST OF MY KNOWLEDGE.

DRILLERS IDENT. NO. 40. DRILLERS SIGNATURE (MUST MATCH SIGNATURE ON APPLICATION).

SITE SUPERVISOR (sign of driller or journeyman responsible for sitework if different from permittee).

Handwritten notes: DRIVEWAY, 63' WELL, 10', MAJOR LA.

B 1 0026

SEQUENCE NO. (OEP USE ONLY)

STATE OF MARYLAND PERMIT TO DRILL WELL

OEP PERMIT NUMBER

HO-73-4023

(THIS NUMBER IS TO BE PUNCHED IN COLS. 3-6 ON ALL CARDS)

10/21/81 9:30

please print or type

fill in this form completely

Date Received

10 07 81 (OEP Use Only)

B 3

LOCATION OF WELL

COUNTY Howard

SUBDIVISION

SECTION 23 LOT

NEAREST TOWN Columbia

MILES FROM TOWN (enter 0 if in town) 2

OWNER INFORMATION

Last Name 15 Owner 34 Name

Street or RFD

Town 57 State City MO 76 Zip

B 1 Continued

DRILLER INFORMATION

Driller's Name 77 License No. 80


Firm Name

Address

Signature Date

B 4

DIRECTION OF WELL FROM TOWN (CIRCLE BOX)

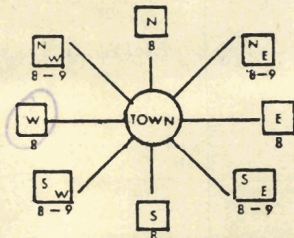

NEAR WHAT ROAD Manor Rd.

ON WHICH SIDE OF ROAD (CIRCLE APPROPRIATE BOX) NORTH WEST EAST SOUTH

DISTANCE FROM ROAD 100

WELL INFORMATION

APPROX. PUMPING RATE (GAL. PER MIN.) 5

AVERAGE DAILY QUANTITY NEEDED (GAL. PER DAY) 100

USE FOR WATER (CIRCLE APPROPRIATE BOX)


- HOME (SINGLE OR DOUBLE HOUSEHOLD UNIT ONLY)
FARMING (LIVESTOCK WATERING & AGRICULTURAL IRRIGATION)
INDUSTRIAL, COMMERCIAL, STATE AND FEDERAL GOV. OTHER (REQUIRES APPROPRIATION PERMIT)
PUBLIC OR PRIVATE WATER COMPANY (REQUIRES APPROPRIATION PERMIT AND STATE HEALTH DEPARTMENT APPROVAL)
TEST, OBSERVATION, MONITORING (MAY REQUIRE APPROPRIATION PERMIT)

SHOW MAJOR FEATURES OF BOX & LOCATE WELL WITH AN X

SOURCES OF DRILLING WATER


- 1.
2.
3.

WRITE THE BOX NUMBER FROM THE MAP HERE

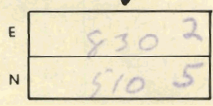

10/21/81 drilled 30'+
25 Bags of Cement P.W.D.
35' Well Street
38' Well Casing P.W.D.
C.B.S.

DRAW A SKETCH BELOW SHOWING LOCATION OF WELL IN RELATION TO NEARBY TOWNS AND ROADS AND GIVE DISTANCE FROM WELL TO NEAREST ROAD JUNCTION

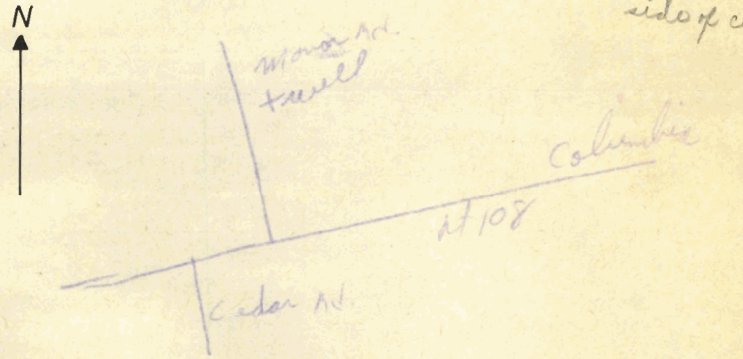

APPROXIMATE DEPTH OF WELL 150 FEET

APPROXIMATE DIAMETER OF WELL 6 NEAREST INCH

METHOD OF DRILLING (circle one)

- BORED (OR AUGERED) JETTED JETTED & DRIVEN
AIR ROTARY AIR PERCUSSION ROTARY (HYDRAULIC ROTARY)
CABLE REVERSE ROTARY DRIVE POINT
other

REPLACEMENT OR DEEPEINED WELLS (CIRCLE APPROPRIATE BOX)

- THIS WELL WILL NOT REPLACE AN EXISTING WELL
THIS WELL WILL REPLACE A WELL THAT WILL BE ABANDONED AND SEALED
THIS WELL WILL REPLACE A WELL THAT WILL BE USED AS A STANDBY
THIS WELL WILL DEEPEIN AN EXISTING WELL
PERMIT NUMBER OF WELL TO BE REPLACED OR DEEPEINED (IF AVAILABLE) 41

B 4

NOT TO BE FILLED IN BY DRILLER HEALTH DEPARTMENT APPROVAL

COUNTY NAME HOWARD COUNTY NO. A-31162

OEP SIGNATURE DATE ISSUED STATE HEALTH CIRCLE BOX

100981 CO SIGNATURE EAST GRID 0832 EXPIRES 040982

Not to be filled in by driller (OEP USE ONLY)

APPROP. PERMIT NUMBER GAP

FORCE FS WRITE INITIALS IN BOX PERMIT No. HO-73-4023

SPECIAL CONDITIONS 8-63

FILE Emergency Well Siting DATE REPORTED 10/2/81

PROPERTY OWNER Dewitt Johnson

P.O. ADDRESS 4575 Manor Lane TELEPHONE 730-8093

DIRECTIONS TO PROPERTY Manor Lane off Rte 108

INFORMANT Mr. Johnson (Easterday has been contacted)


Has spring for house doesn't drink water  
gets drinking water from neighbor.

DW

GARAGE

CONDITION FOUND

Septic in Rear of House  
Well area in front yard  
35' from house.

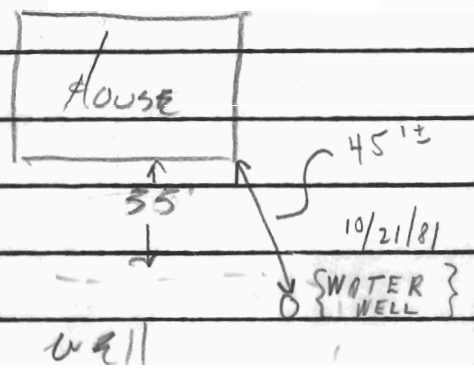

10/2/81 S/R

AREA

ACTION TAKEN

FINAL DISPOSITION