

# APPLICATION

18650

## SEWAGE DISPOSAL TESTING


P. \_\_\_\_\_

STATE OF MARYLAND - DEPARTMENT OF HEALTH AND MENTAL HYGIENE

HOWARD COUNTY HEALTH DEPARTMENT  
ENVIRONMENTAL HEALTH SERVICES  
P. O. BOX 476, ELLICOTT CITY, MARYLAND 21043  
TELEPHONE: 443-3888, EXT. 385

DISTRICT 4th

DATE 7/6/73

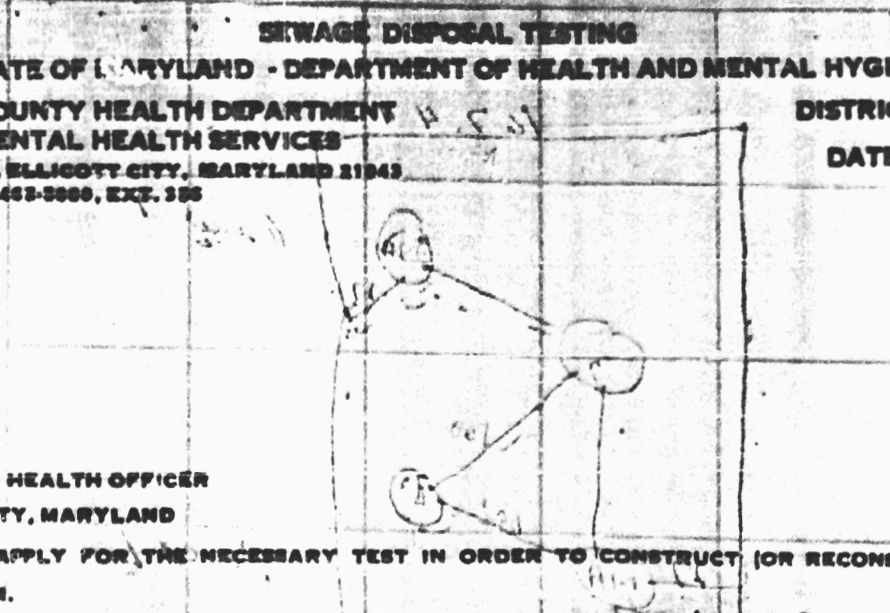

TO: THE COUNTY HEALTH OFFICER  
ELLICOTT CITY, MARYLAND

I, HEREBY, APPLY FOR THE NECESSARY TEST IN ORDER TO CONSTRUCT (OR RECONSTRUCT) A SEWAGE DISPOSAL SYSTEM.

PROPERTY OWNER EDWARD DURBIN CASCIOLI & wife

ADDRESS 6510 HAVILANDS MILL RD, CLARKSVILLE, MD. 725-5161

PROPERTY LOCATION:

SUBDIVISION CHESTNUT HILLS LOT NO. PARCEL Y

ROAD AND DESCRIPTION PARCEL Y at intersection of LONG CORNER RD & FLORENCE RD.

SIZE OF LOT 1.518 A TYPE BLDG. 3 Bedrooms  
NUMBER OF BEDROOMS

IF NOT SINGLE RESIDENCE DESCRIBE \_\_\_\_\_

THE SYSTEM INSTALLED UNDER THIS APPLICATION IS ACCEPTABLE ONLY UNTIL PUBLIC FACILITIES BECOME AVAILABLE.

SIGNATURE OF APPLICANT Edward D Cascioli


APPROVED BY \_\_\_\_\_ FOR \_\_\_\_\_ DATE \_\_\_\_\_  
(KIND OF SYSTEM)

REJECTED BY \_\_\_\_\_ FOR \_\_\_\_\_ DATE \_\_\_\_\_  
(KIND OF SYSTEM)

HOLD PENDING FURTHER TESTS \_\_\_\_\_ DATE \_\_\_\_\_

REASONS FOR REJECTION OR HOLDING \_\_\_\_\_

**THIS IS NOT A DEED**

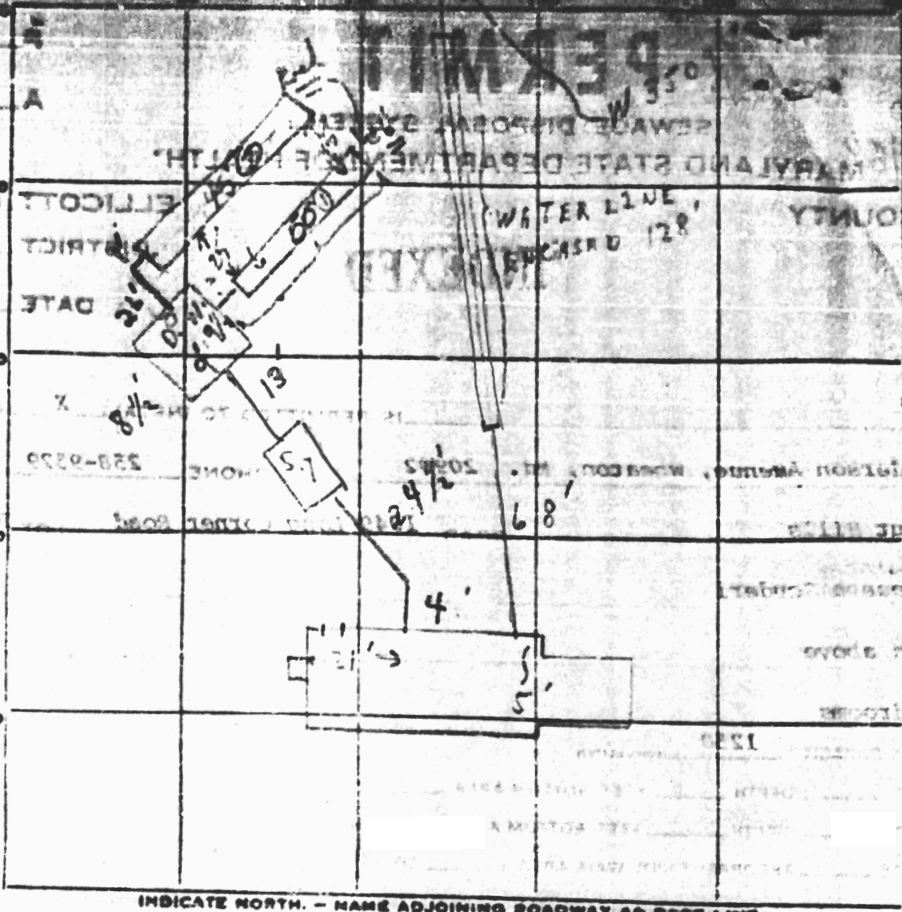


INDICATE NORTH. - NAME ADJOINING ROADWAY AS BASE LINE.

PERMIT CARD  S.T. | D.W.  
 SEPTIC TANK, LEVEL  CLEANOUTS   
 DISTRIBUTION BOX, LEVEL   
 TILE FIELD, DEPTH 6 1/2 FT. TRENCH WIDTH 2 FT.  
 GRAVEL DEPTH 9 IN. TOTAL LENGTH 150 FT. 15  
 NUMBER OF TRENCHES 2 TOTAL BOTTOM AREA 200 + @ 405 605  
 SEEPAGE PITS, INSIDE DIAMETER 35 IN. FT. DEPTH BELOW INLET 7 FT. 245  
 ABSORBENT AREA 850 SQ. FT.

REMARKS 6/2/20 WORK - IMPROPER PIPE FROM SEPTIC  
TO DRYWELL, STONE IN TRENCH BEFORE INSPECT  
11' FROM TRENCH TO DRYWELL, C.B.W. 6 1/2' DEPTH WITH  
DRYWELL @ SITE USED (1) IN SEPTIC TANK  
NEEDS TO SETTLE (3) NEEDS TO SETTLE  
LIGHT STONE IN TRENCH (4)

# APPLICATION

STATE OF MARYLAND - DEPARTMENT OF HEALTH AND MENTAL HYGIENE  
 HOWARD COUNTY HEALTH DEPARTMENT  
 ENVIRONMENTAL HEALTH SERVICE  
 DISTRICT \_\_\_\_\_  
 DATE 4.7.4

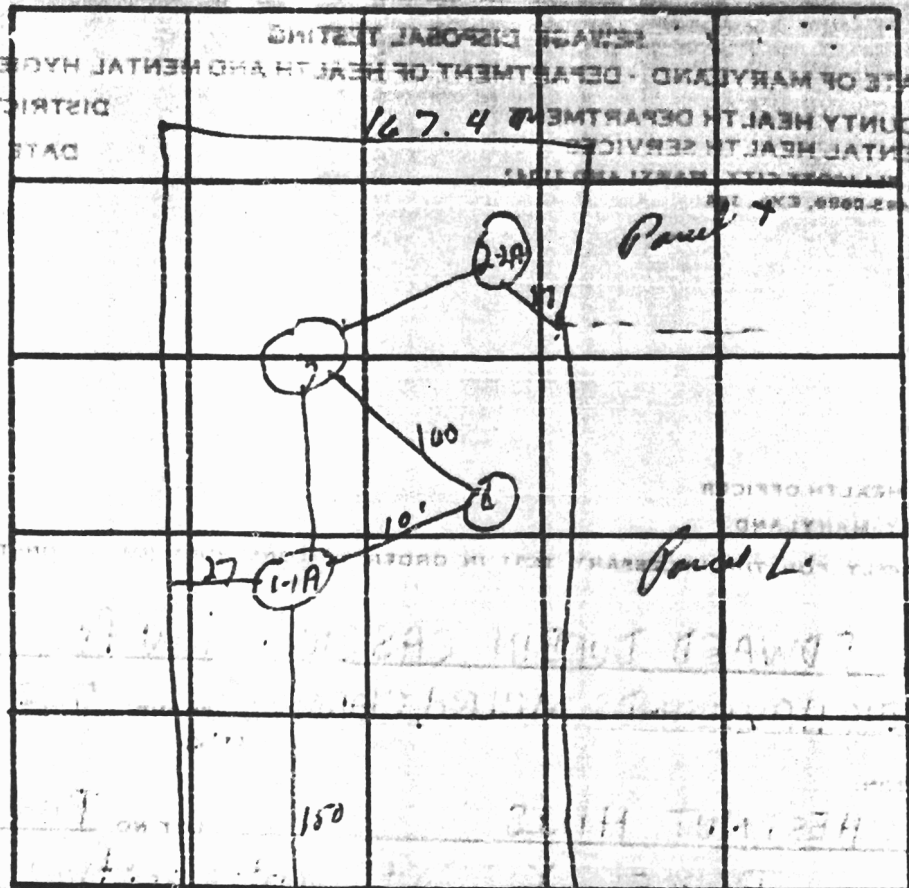

Paul T

Paul L

DATE	TEST NO.	DEPTH	PRE-WET		TEST - 1" DROP		TIME
			START	STOP	START	STOP	
4/16/72	1	5'	10 <sup>55</sup>	10 <sup>42</sup>	10 <sup>42</sup>	11 <sup>05</sup>	23 min
	1A	12'	10 <sup>35</sup>	10 <sup>30</sup>	10 <sup>30</sup>	10 <sup>22</sup>	5 min
	2	11'	10 <sup>54</sup>	10 <sup>38</sup>	11 <sup>01</sup>	10 <sup>51</sup>	13 min
	3	5'	10 <sup>36</sup>	10 <sup>32</sup>	10 <sup>32</sup>	10 <sup>41</sup>	4 min
	4	11'	good soil	shale			
			"	"	"		

REMARKS 1-1A high - 2-3A low