

PUB. SEWER STATUS VERIFIED BY _____

03-285820

ISSUE DATE: 4/25/2002

P 516951-A

APPROVAL DATE: 12/11/73

A 516951-A

PERMIT

RE-INDEXED

ON-SITE SEWAGE DISPOSAL SYSTEM HOWARD COUNTY HEALTH DEPARTMENT BUREAU OF ENVIRONMENTAL HEALTH

_____ IS PERMITTED TO INSTALL ALTER

ADDRESS: _____ PHONE NUMBER: _____

SUBDIVISION: Fox Den Farms LOT NUMBER: 5B

ADDRESS: 4001 Jumpers Hill Lane PROPERTY OWNER: James Gillicee

SEPTIC TANK CAPACITY (GALLONS): _____

PUMP CHAMBER CAPACITY (GALLONS): _____

NUMBER OF BEDROOMS: _____

SQUARE FEET PER BEDROOM: _____

LINEAR FEET OF TRENCH REQUIRED: _____

TRENCHES:	Trench to be _____ feet wide. Inlet _____ feet below original grade. Bottom maximum depth _____ feet below original grade. Effective area begins at _____ feet below original grade. _____ feet of stone below distribution pipe.
LOCATION:	_____
PURPOSE:	_____

PLANS APPROVED: _____ DATE: _____

- NOTE: PERMIT VOID AFTER 2 YEARS
- NOTE: CONTRACTOR RESPONSIBLE FOR SCHEDULING A PRE-CONSTRUCTION INSPECTION FOR ALL INSTALLATIONS
- NOTE: WATERTIGHT SEPTIC TANKS REQUIRED
- NOTE: ALL PARTS OF SEPTIC SYSTEM SHALL BE 100 FEET FROM ANY WATER WELL
- NOTE: MANHOLE RISERS REQUIRED ON ALL SEPTIC TANKS AND PUMP CHAMBERS

NEITHER THE HOWARD COUNTY COUNCIL NOR THE HEALTH DEPARTMENT IS RESPONSIBLE FOR THE SUCCESSFUL OPERATION OF ANY SYSTEM PERMITTED RESPONSIBLE FOR OBTAINING FINAL APPROVAL ON THIS PERMIT CALL 410-313-2640 FOR INSPECTION OF SEPTIC SYSTEM

A-516951-A

PERMIT

SEWAGE DISPOSAL SYSTEM

MARYLAND STATE DEPARTMENT OF HEALTH

HOWARD COUNTY

P 19365
A 19236

ELLICOTT CITY

DISTRICT 3rd

DATE 12/11/73

INDEXED

Richard Lowe

IS PERMITTED TO INSTALL ALTER

ADDRESS Ilchester Road, Ellicott City, Md.

PHONE 747-7598

A SEWAGE DISPOSAL SYSTEM LOCATED AT

SUBDIVISION Fox Den Farms

ROAD Jumper Hill Lane

LOT 5, Blk. B

PROPERTY OWNER Mr. James Gilliece

ADDRESS 1684 Kirkwood Road, Baltimore, Maryland 21207

SPECIFICATIONS 4 bedrooms

DRAIN FIELD DEPTH FEET, BOTTOM AREA SQ. FT.

SEEPAGE PITS ABSORBENT SIDE-WALL AREA SQ. FT.

SEPTIC TANK CAPACITY 1200 GALLONS

FOR GARBAGE GRINDER, INCREASE DISPOSAL AREA 22% & TANK CAPACITY 50%.

OTHER DRY WELL - Dig pit 12 ft. square - set block and top for 9 or 10 ft. diameter and fill in rest of pit with gravel. Dry well to have 7 ft. effective depth below the first 4 ft. of original grade. Maximum depth for dry well is 11 ft. below original grade. Come off dry well with trench 50 ft. long - 11 ft. deep with 7 ft. of gravel under pipe. Leave 5 ft. solid buffer between trench and dry well. Call for inspection of trench before gravel is installed. Place dry well 35 ft. behind rear center of house.

NOTE: ALL PIPE FROM HOUSE TO DRY WELL MUST BE CAST IRON.
PERMIT VOID AFTER THREE YEARS.

NOTE: INSTALL STAND PIPE ON SEPTIC TANK AND DRY WELL.

PLANS APPROVED BY Donald W. Monaghan

DATE 11/20/73

FILL SEPTIC TANK AND DISTRIBUTION BOX WITH WATER BEFORE CALLING FOR AN INSPECTION. COVER NO WORK UNTIL INSPECTED AND APPROVED.

NEITHER THE HOWARD COUNTY COMMISSIONERS NOR THE HEALTH DEPARTMENT IS RESPONSIBLE FOR THE SUCCESSFUL OPERATION OF ANY SYSTEM.

DESG. PERMIT SIGNED AND RETURNED


Serial # 20078
pmb

A 19236

12/13/73
1/3/74
Early as possible
1/7/74 rechecked

12/13/73

C.6-
7
11/9/74

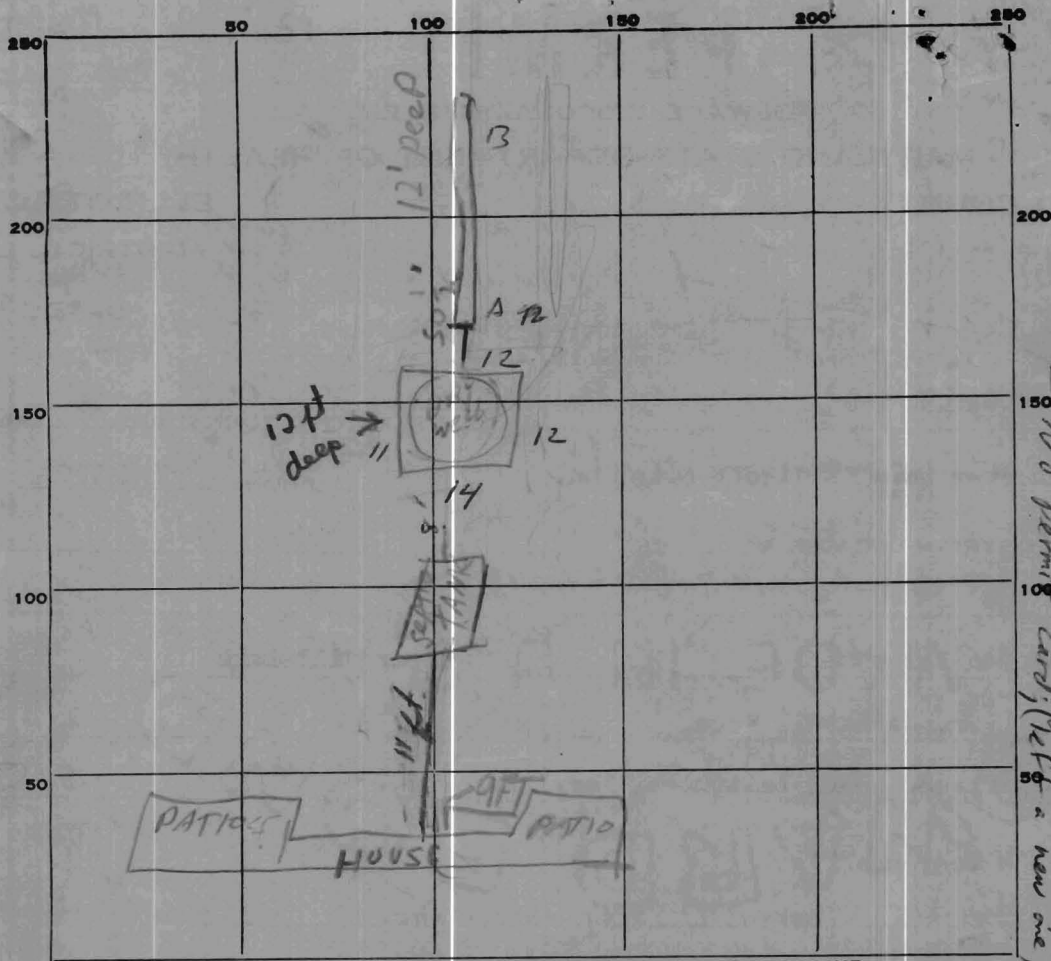

INDICATE NORTH. - NAME ADJOINING ROADWAY AS BASE LINE.

JUMPER HILL

12/9/74 - Drywell - Cement cleanout 4 1/2 ft
 - Seal crack at open end on lid
 - Septic Tank - at open end (end away from house)
 - both inlet & outlet to be re-cemented - bottoms of "seals" are open
 - cover tank, call for signature of Dwyer ST.
 - No permit card; (let a new one)

24
 25
 49
 9
 pit: 44 1/2 ft

55
 9
 495
 + 491

PERMIT CARD _____

SEPTIC TANK, LEVEL 1250 GALLONS

CLEANOUTS NONE

DISTRIBUTION BOX, LEVEL _____

Trench
 THE FIELD, DEPTH 12 FT. TRENCH WIDTH 2 FT.

to gravel - 3 1/2' @ end
 2 1/2' @ end B
 55' long

GRAVEL DEPTH 9 ft TOTAL LENGTH 50 55 FT.

NUMBER OF TRENCHES 1 TOTAL BOTTOM AREA _____

SEEPAGE PITS, INSIDE DIAMETER Perimeter 49 FT. DEPTH BELOW INLET 9 FT.

Note: D.W. 1 1/2 ft below specs on max depth (also trench)

ABSORBENT AREA 936 SQ. FT.

REMARKS 12-1373 H.J.V.

Nothing installed except 1250 gallon capacity septic tank. pipe from the frame to the septic tank is not connected. Give permission to complete system and put stone in trench.

DATE SYSTEM APPROVED 11/8/74 All violations corrected INSPECTOR H.J. 262