

*Preliminary*

# APPLICATION

A 09892

P \_\_\_\_\_

SEWAGE DISPOSAL TESTING

MARYLAND STATE DEPARTMENT OF HEALTH

HOWARD COUNTY

ELLICOTT CITY

DISTRICT 3

*1200 gal -  
Septic Tank - ~~1000~~ gallons man hole cleanout to  
grade level*

Dry well - ~~12~~ ft in dia. by 4 ft deep below the inlet DATE 3/31/65

pipe located 150 ft. from front property line and ~~426~~ <sup>22</sup> ft. from left side property line as seen when facing lot from Jumper Hill Rd.

right - Dry Well - 450 sq ft absorbent side wall area to be per below the first 3 1/2' of orig. grade. Max depth permitted for Dry Well is 12 ft below orig. grade.

TO: THE COUNTY HEALTH OFFICER  
ELLICOTT CITY, MARYLAND

*Charge OK 9/24/73 - D.L.W.*

I, HEREBY, APPLY FOR THE NECESSARY TESTS IN ORDER TO CONSTRUCT (OR RECONSTRUCT) A SEWAGE DISPOSAL SYSTEM.

PROPERTY OWNER Fox Den, Inc.

ADDRESS Folly Quarter Rd., Ellicott City, Md. PHONE HO 5-4222

PROPERTY LOCATION:

SUBDIVISION Fox Den Farms LOT NO. 5, Blk. B

ROAD AND DESCRIPTION Road Not Named Jumper Hill Lane

OCCUPANT \_\_\_\_\_ PHONE \_\_\_\_\_

PERSON TO CONSTRUCT SYSTEM \_\_\_\_\_

ADDRESS \_\_\_\_\_ PHONE \_\_\_\_\_

SIZE OF LOT 165,500 sq. ft. TYPE BLDG. 4  
NUMBER OF BEDROOMS

IF NOT SINGLE RESIDENCE DESCRIBE \_\_\_\_\_

SIGNATURE OF APPLICANT /s/ Geo. B. White


APPROVED BY J.H. Kilmore FOR Dry well DATE 4/8/65  
(KIND OF SYSTEM)

REJECTED BY \_\_\_\_\_ FOR \_\_\_\_\_ DATE \_\_\_\_\_  
(KIND OF SYSTEM)

HOLD PENDING FURTHER TESTS \_\_\_\_\_ DATE \_\_\_\_\_

REASONS FOR REJECTION OR HOLDING \_\_\_\_\_

# THIS IS NOT A PERMIT

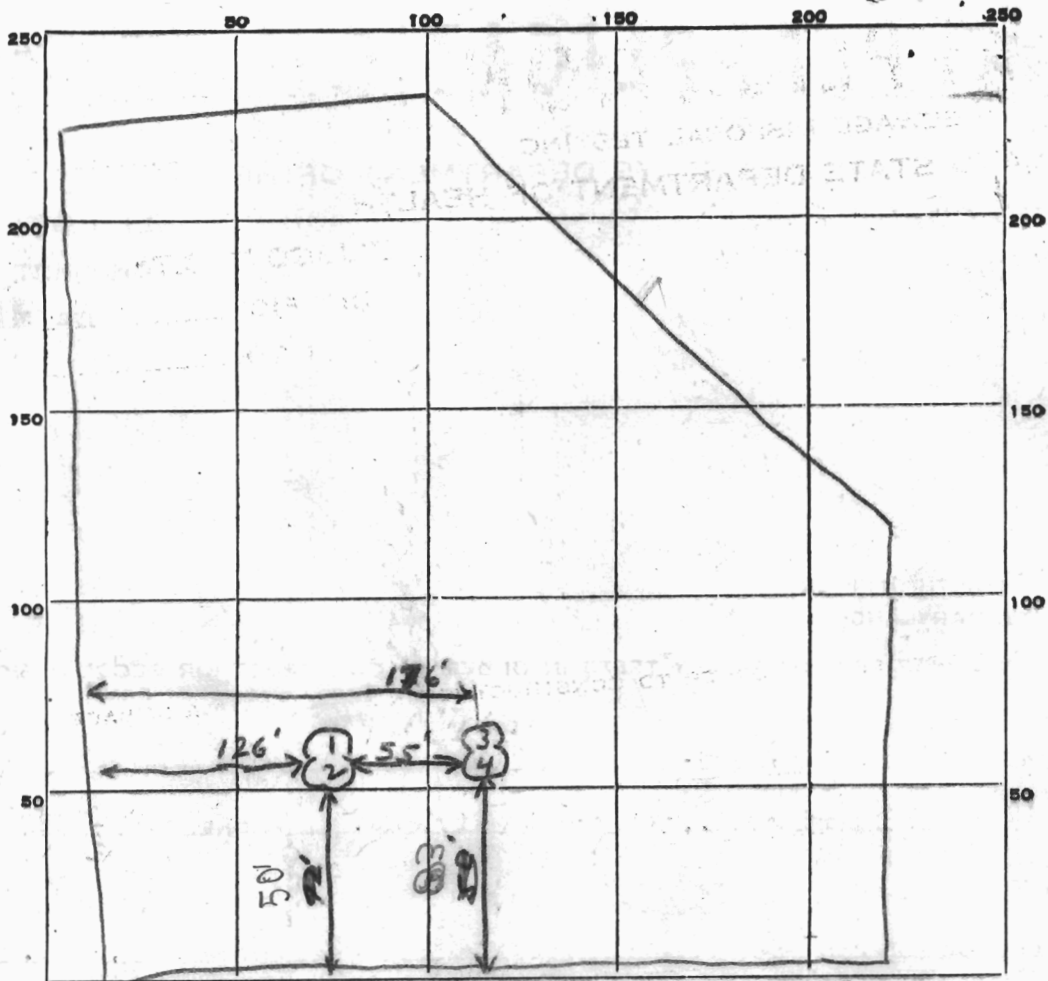

INDICATE NORTH. - NAME ADJOINING ROADWAY AS BASE LINE.

Jumper's Hill Rd

DATE	TEST NO.	DEPTH	PRE-WET		TEST - 1" DROP		TIME
			START	STOP	START	STOP	
4/8/65	1	10'	3:08	3:11	3:11	3:14	3 min
"	2	6'	3:08	3:11	3:11	3:15	4 min
"	3	10'	3:06	3:11	3:11	3:20	9 min
"	4	5'	3:07	Overtime			

SOIL AUGER FINDING \_\_\_\_\_

TESTED BY JHR

REMARKS \_\_\_\_\_

*J.B. White*

Lot-5-BIK B

*Relist*

*2-12' Lales  
50ft. apart*

# APPLICATION

A 19236

P \_\_\_\_\_

## SEWAGE DISPOSAL TESTING

STATE OF MARYLAND - DEPARTMENT OF HEALTH AND MENTAL HYGIENE

HOWARD COUNTY HEALTH DEPARTMENT  
ENVIRONMENTAL HEALTH SERVICES  
P. O. BOX 476, ELLICOTT CITY, MARYLAND 21043  
TELEPHONE: 465-9000, EXT. 356

DISTRICT 3rd

DATE 11/1/73

*11/20/73 Septic Tank - 1200 gal.  
1:30 Dry Well - Dig pit 12' sq. set block + top for 9 or 10' diameter +  
fill in rest of pit with gravel. Dry Well to have 7' effective depth below the  
ground 4' of orig. grade. More depth for DW is 11' below orig grade.  
Come off DW with trench 50' long - 11' deep with 7' of gravel under pipe  
leave 5' solid buffer between trench + DW. \* call for map of trench  
before gravel is installed*

TO: THE COUNTY HEALTH OFFICER  
ELLICOTT CITY, MARYLAND

*Place Dry Well 35' behind rear center of house.*

I, HEREBY, APPLY FOR THE NECESSARY TEST IN ORDER TO CONSTRUCT (OR RECONSTRUCT) A SEWAGE DISPOSAL SYSTEM.

PROPERTY OWNER James Gilliece

ADDRESS 1684 Kirkwood Road, Baltimore, Md. 21207 PHONE 944-8122

PROPERTY LOCATION:

SUBDIVISION Fox Den Farms LOT NO. 5, Blk. B

ROAD AND DESCRIPTION Jumper hill Lane

SIZE OF LOT 165,000 sq. ft. TYPE BLDG. 4 bedrooms  
NUMBER OF BEDROOMS

IF NOT SINGLE RESIDENCE DESCRIBE \_\_\_\_\_

THE SYSTEM INSTALLED UNDER THIS APPLICATION IS ACCEPTABLE ONLY UNTIL PUBLIC FACILITIES BECOME AVAILABLE.

SIGNATURE OF APPLICANT Mrs. James M. Gilliece, Jr.


APPROVED BY Dir. Monaghan FOR Dry Well DATE 11/20/73  
(KIND OF SYSTEM)

REJECTED BY \_\_\_\_\_ FOR \_\_\_\_\_ DATE \_\_\_\_\_  
(KIND OF SYSTEM)

HOLD PENDING FURTHER TESTS \_\_\_\_\_ DATE \_\_\_\_\_

REASONS FOR REJECTION OR HOLDING \_\_\_\_\_

# THIS IS NOT A PERMIT

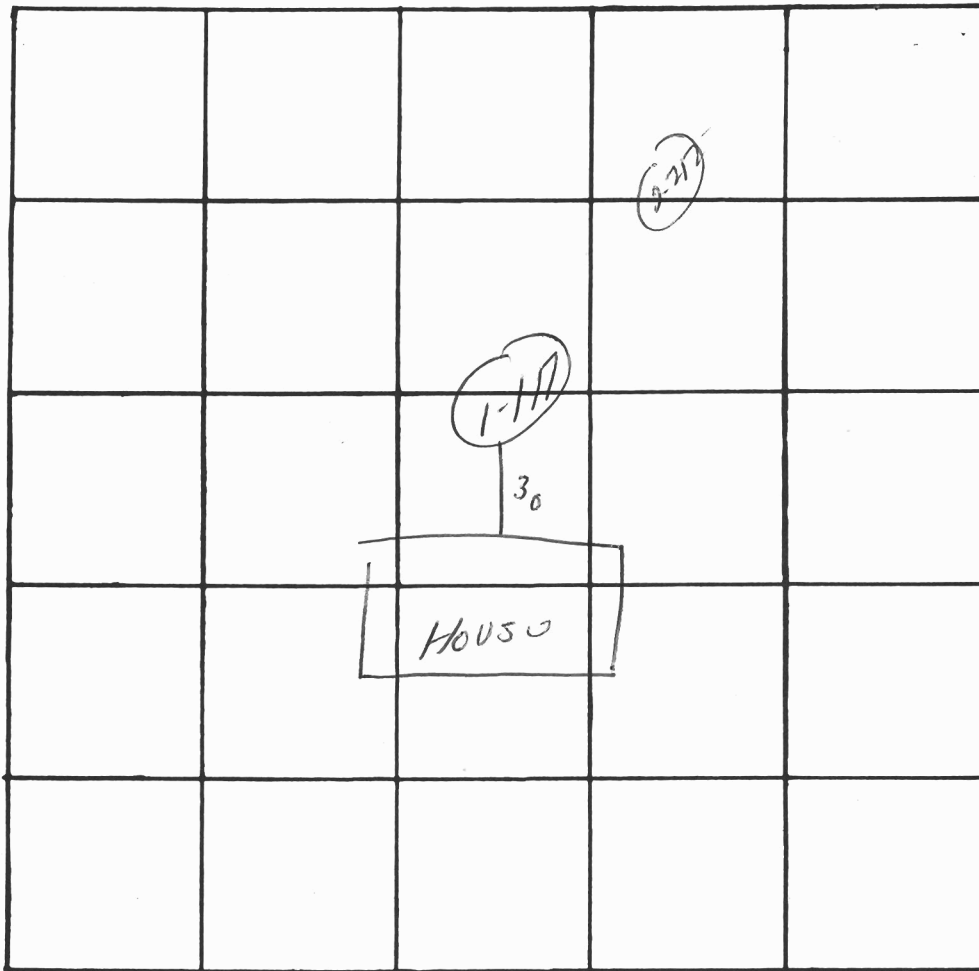

INDICATE NORTH. - NAME ADJOINING ROADWAY AS BASE LINE.

DATE	TEST NO.	DEPTH	PRE-WET		TEST - 1" DROP		TIME
			START	STOP	START	STOP	
11/30/77	1	12'	1 39	1 45	1 45	2 02	17 min
	1A	4'	1 40	1 49	1 49	2 10	21 min
	2	good soil not tested					
	2A						

REMARKS \_\_\_\_\_

TYPE OF SOIL \_\_\_\_\_

# APPLICATION

SEWAGE DISPOSAL TESTING

MARYLAND STATE DEPARTMENT OF HEALTH

HOWARD COUNTY

ELLICOTT CITY

DISTRICT 3

DATE 3/31/65

A 09892

P \_\_\_\_\_

TO: THE COUNTY HEALTH OFFICER  
ELLICOTT CITY, MARYLAND

I, HEREBY, APPLY FOR THE NECESSARY TESTS IN ORDER TO CONSTRUCT (OR RECONSTRUCT) A SEWAGE DISPOSAL SYSTEM.

PROPERTY OWNER Fox Den, Inc.

ADDRESS Folly Quarter Rd., Ellicott City, Md. PHONE HO 5-4222

PROPERTY LOCATION:

SUBDIVISION Fox Den Farms LOT NO. 5, Blk. B

ROAD AND DESCRIPTION Road Not Named

OCCUPANT W.E. Hill PHONE 1-219/11

PERSON TO CONSTRUCT SYSTEM W.E. Hill

ADDRESS W.E. Hill PHONE 1-219/11

SIZE OF LOT 165,500 sq. ft. TYPE BLDG. 4  
NUMBER OF BEDROOMS

IF NOT SINGLE RESIDENCE DESCRIBE \_\_\_\_\_

SIGNATURE OF APPLICANT /s/ Geo. B. White


APPROVED BY J.H. Kilmore FOR Dry well DATE 4/8/65  
(KIND OF SYSTEM)

REJECTED BY \_\_\_\_\_ FOR \_\_\_\_\_ DATE \_\_\_\_\_  
(KIND OF SYSTEM)

HOLD PENDING FURTHER TESTS \_\_\_\_\_ DATE \_\_\_\_\_

REASONS FOR REJECTION OR HOLDING \_\_\_\_\_

# THIS IS NOT A PERMIT

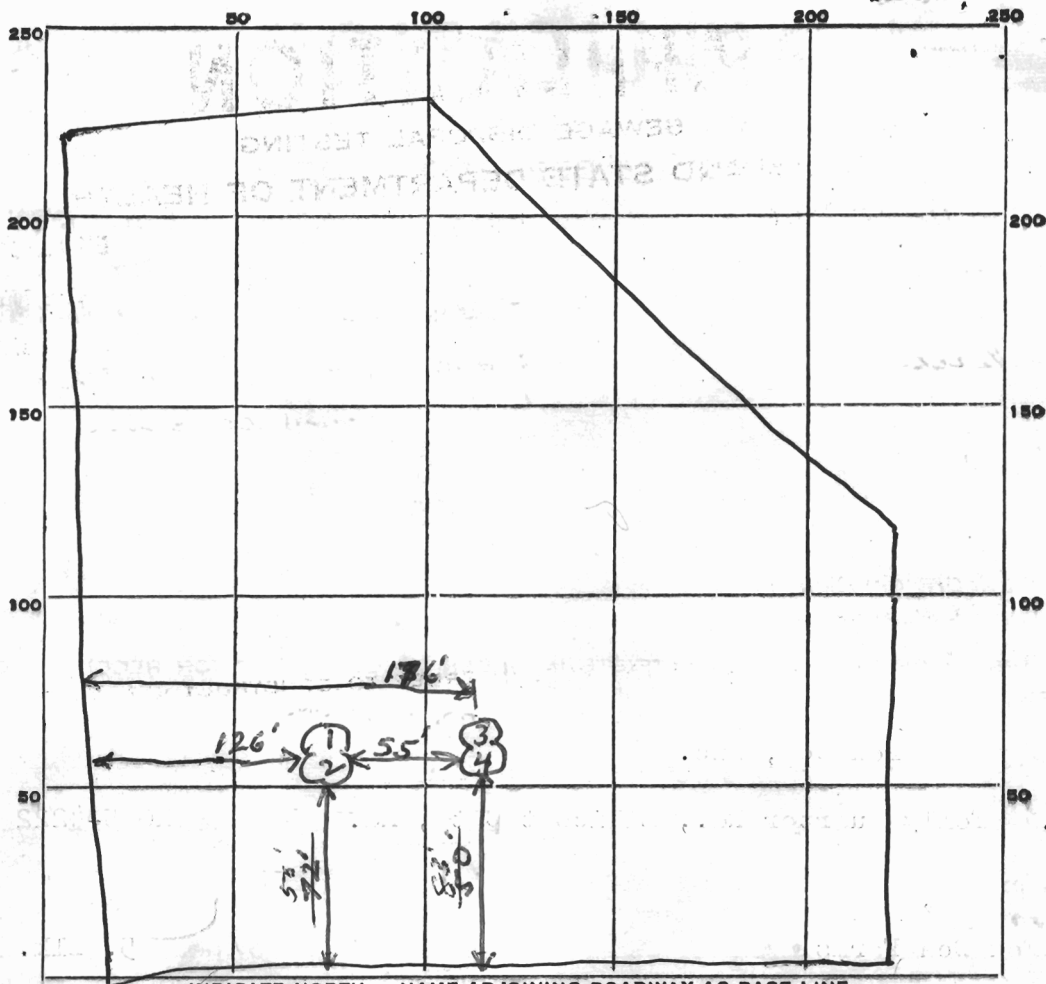

INDICATE NORTH. - NAME ADJOINING ROADWAY AS BASE LINE.

Jumper's Hill Rd

DATE	TEST NO.	DEPTH	PRE-WET		TEST - 1" DROP		TIME
			START	STOP	START	STOP	
4/8/65	1	10'	3:08	3:11	3:11	3:14	3 min
"	2	6'	3:08	3:11	3:11	3:15	4 min
"	3	10'	3:06	3:11	3:11	3:20	9 min
"	4	5	3:07	Overtime			

5.33 min.

SOIL AUGER FINDING

TESTED BY JHR

REMARKS G.B. White

Lot-5-BJK B