

03-282961

LAYOUT _____ INSP 4 _____
INSP 2 _____ INSP 5 _____
INSP 3 _____ INSP 6 _____

ISSUE DATE: _____
APPROVAL DATE: _____

PERMIT

P _____
A 517316-A

ON-SITE SEWAGE DISPOSAL SYSTEM HOWARD COUNTY HEALTH DEPARTMENT BUREAU OF ENVIRONMENTAL HEALTH

IS PERMITTED TO INSTALL ALTER

ADDRESS: _____ PHONE NUMBER: _____

SUBDIVISION: Woodmark LOT NUMBER: 54

ADDRESS: 12220 Ioka Court PROPERTY OWNER: Tim Siebes

SEPTIC TANK CAPACITY (GALLONS): _____ OUTLET BAFFLE FILTER REQUIRED

PUMP CHAMBER CAPACITY (GALLONS): _____ COMPARTMENTED TANK REQUIRED

NUMBER OF BEDROOMS: _____

SQUARE FEET PER BEDROOM: _____

LINEAR FEET OF TRENCH REQUIRED: _____

TRENCHES:	Trench to be _____ feet wide. Inlet _____ feet below original grade. Bottom maximum depth _____ feet below original grade. Effective area begins at _____ feet below original grade. _____ feet of stone below distribution pipe.
LOCATION:	
BUILDING PERMIT SIGNED	
NOTES:	AND RETURNED 6/13/2002 B00136431 Screened Porch

PLANS APPROVED: _____ DATE: _____

- NOTE: PERMIT VOID AFTER 2 YEARS
- NOTE: CONTRACTOR RESPONSIBLE FOR SCHEDULING A PRE-CONSTRUCTION INSPECTION FOR ALL INSTALLATIONS
- NOTE: WATERTIGHT SEPTIC TANKS REQUIRED
- NOTE: ALL PARTS OF SEPTIC SYSTEM SHALL BE 100 FEET FROM ANY WATER WELL
- NOTE: MANHOLE RISERS REQUIRED ON ALL SEPTIC TANKS AND PUMP CHAMBERS UNLESS SPECIFICALLY AUTHORIZED

NEITHER THE HOWARD COUNTY COUNCIL NOR THE HEALTH DEPARTMENT IS RESPONSIBLE FOR THE SUCCESSFUL OPERATION OF ANY SYSTEM PERMITTEE RESPONSIBLE FOR OBTAINING FINAL APPROVAL ON THIS PERMIT CALL 410-313-2640 FOR INSPECTION OF SEPTIC SYSTEM

517316-A



HOWARD COUNTY HEALTH DEPARTMENT

6751 Columbia Gateway Drive Columbia, MD 21046

(410) 313-6300 Fax (410) 313-6303

TDD (410) 313-2323 Toll Free 1-877-4MD-DHMH

Penny E. Borenstein, M.D., M.P.H., Acting County Health Officer

June 14, 2002

X 1861

MEMORANDUM

To: Department of Inspections, Licenses and Permits

From: Kacie Noonan
Water and Sewerage Program

Re: Apparently unpermitted pool
12220 Ioka Court
Woodmark, Lot 54
Current Application B00136431


On May 24, 2002, an inspection was conducted at the referenced property to evaluate the suitability of the proposed screen porch relative to the existing septic system. On that date, an existing inground pool was observed in the back yard. There is no record of a permit application for the referenced pool in Health Department files nor could a record be found in Cornerstone.

Please handle/investigate at your discretion. If you have any questions or comments, please call extension 2669.

KN


cc: File

Pool w/o permit

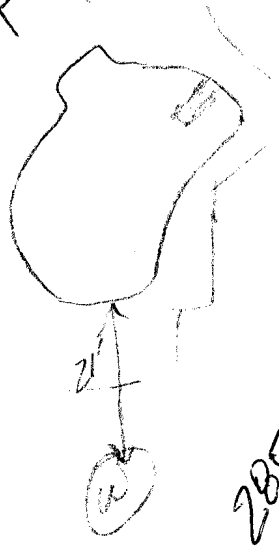

285

6/24/02
KN

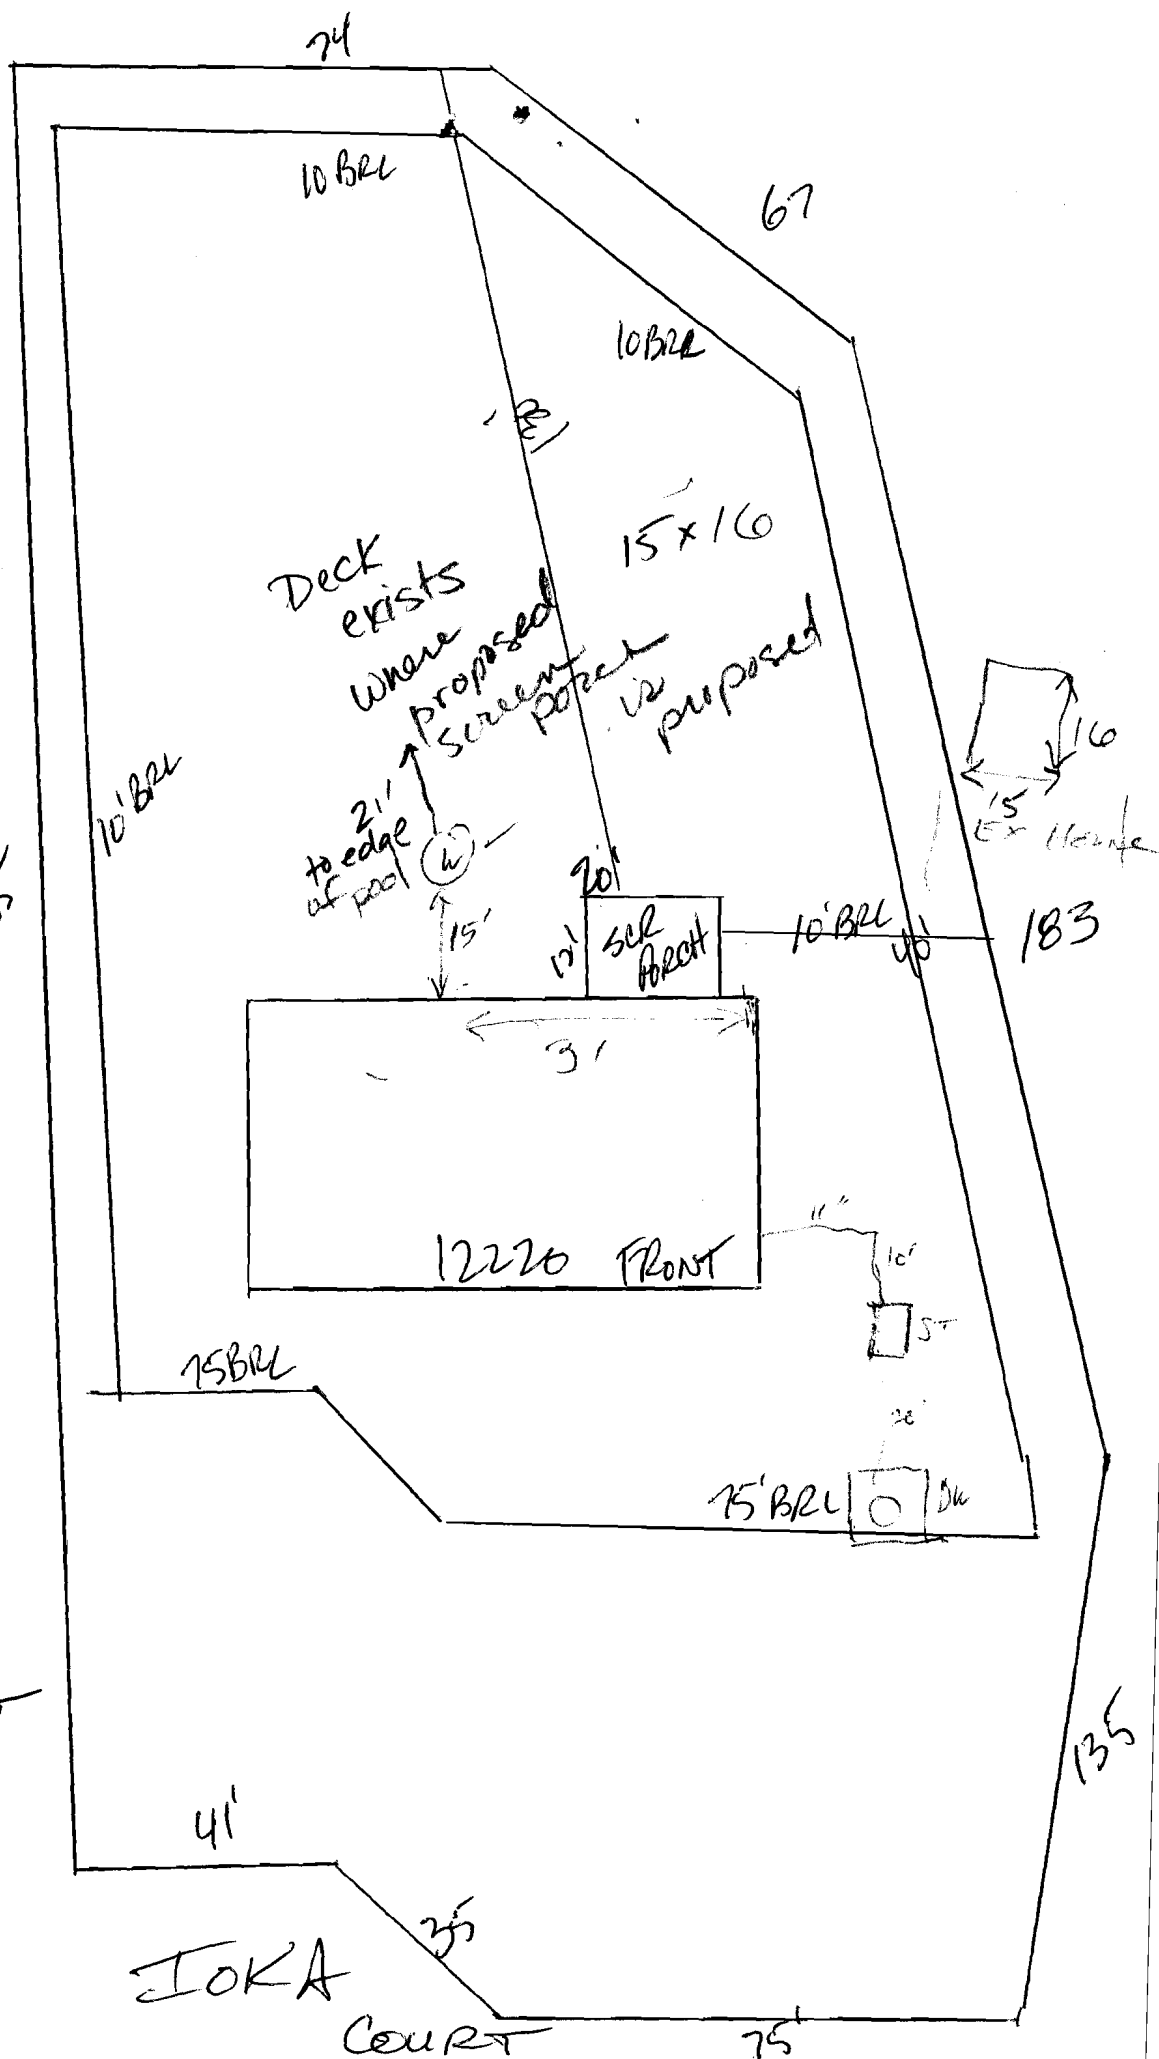

12220 IOKA COURT
ELLICOTT CITY

IOKA

COURT